


PAVED CUTTER
Lt. 123+03 ~ 25+00 Rt.

GUARD RAIL, STD. STEEL BEAM
w/ STEEL POSTS TYPE II
Lt. 26+50 ~ 28+50 Rt. 25+00 ~ 29+00

EXCAVATION & REMOVAL of
ROAD SURFACES and PAVEMENTS
Lt. 26+75 ~ 27+50 Rt. 27+50 ~ 28+35
28+20 ~ 30+00

REMOVAL & DISPOSAL OF
EXISTING GUARD RAIL
Lt. 26+65 ~ 28+30 Rt. 26+65 ~ 28+40

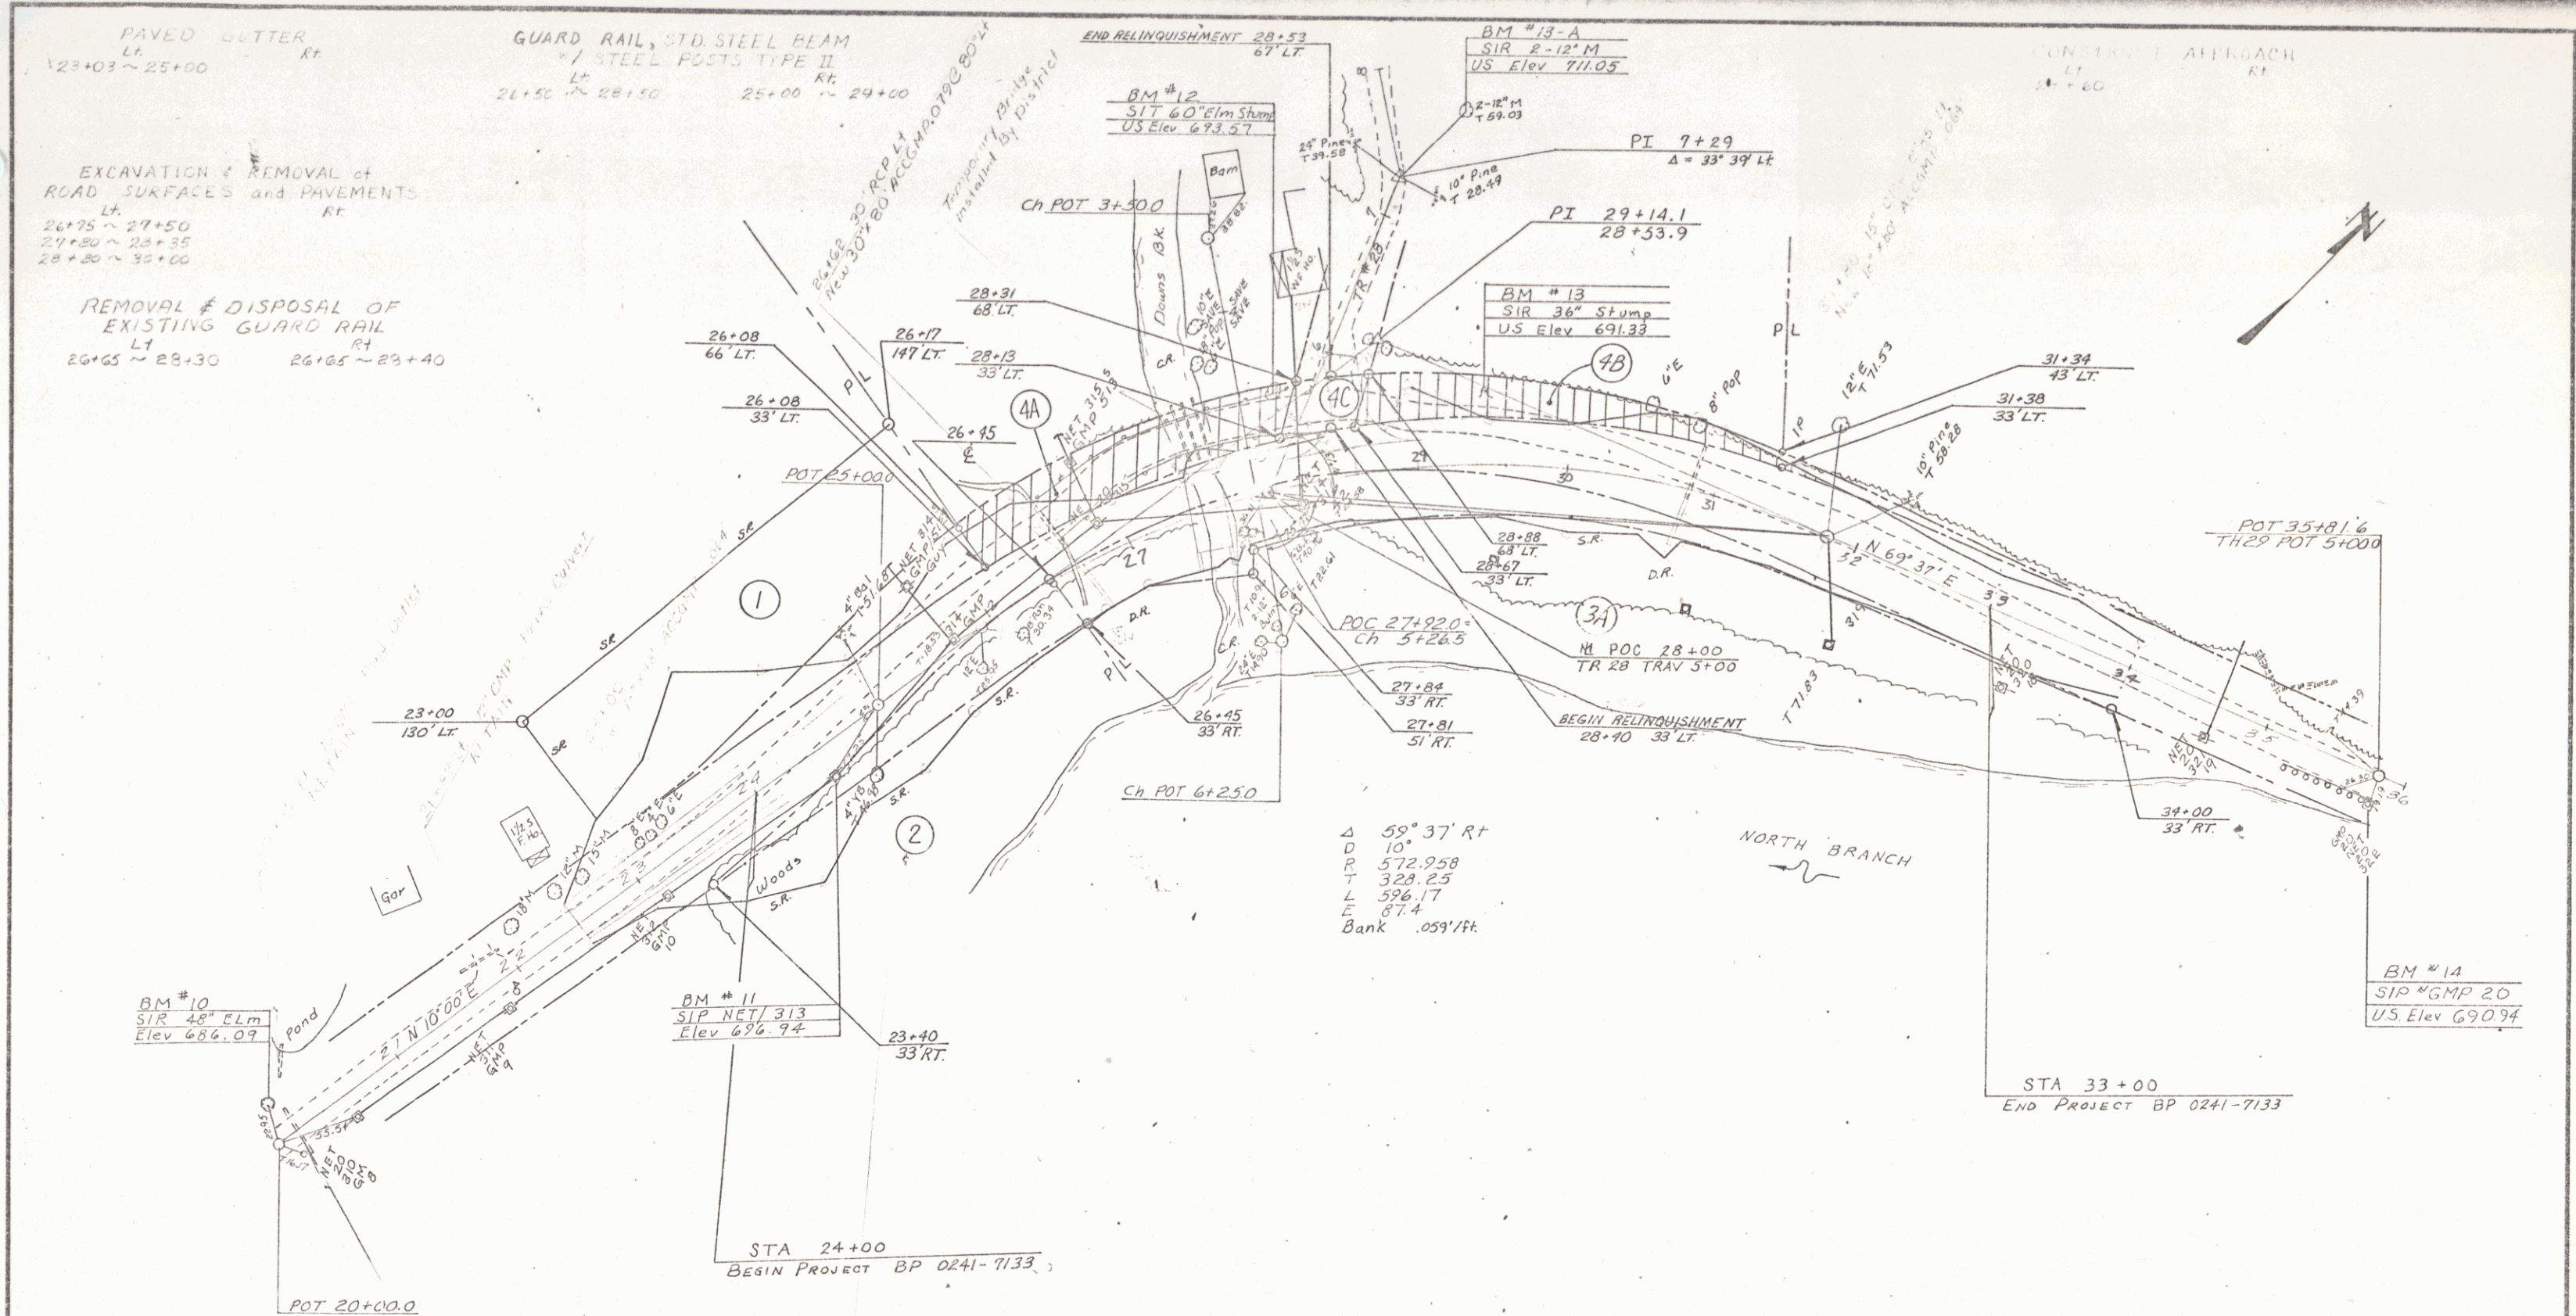

SCALE
0 50 100
FEET

SURVEYED BY Stevens DATE June 1973
DRAWN BY Smith DATE June 1973
TRACED BY Hay DATE July 1973
WORCESTER
PROJ. BP NO. 0241-7133
SHEET 7 OF 46
D-7