


PLAN
 DATE 9/25
 DRAWN BY GANEX
 CHECKED BY GANEX

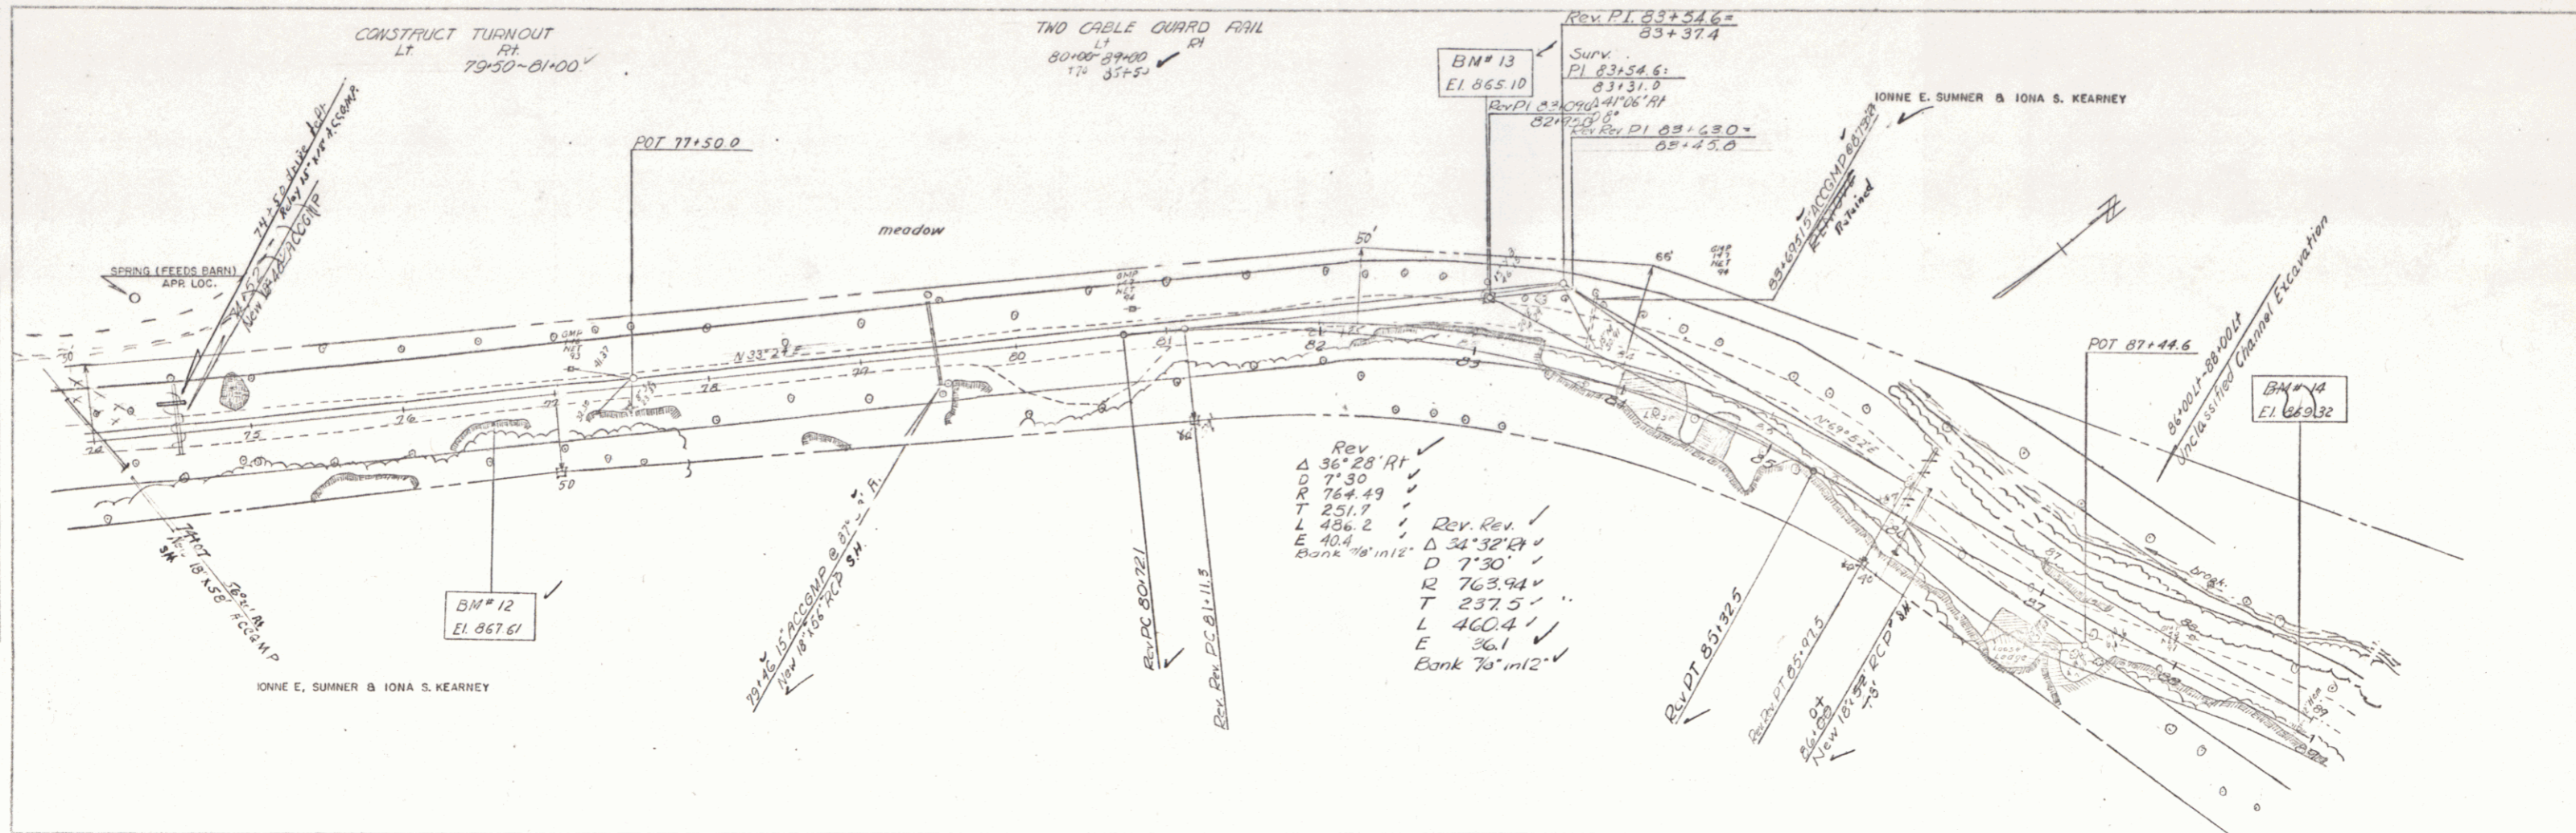

PROFILE
 DATE 9/25
 DRAWN BY GANEX
 CHECKED BY GANEX

