
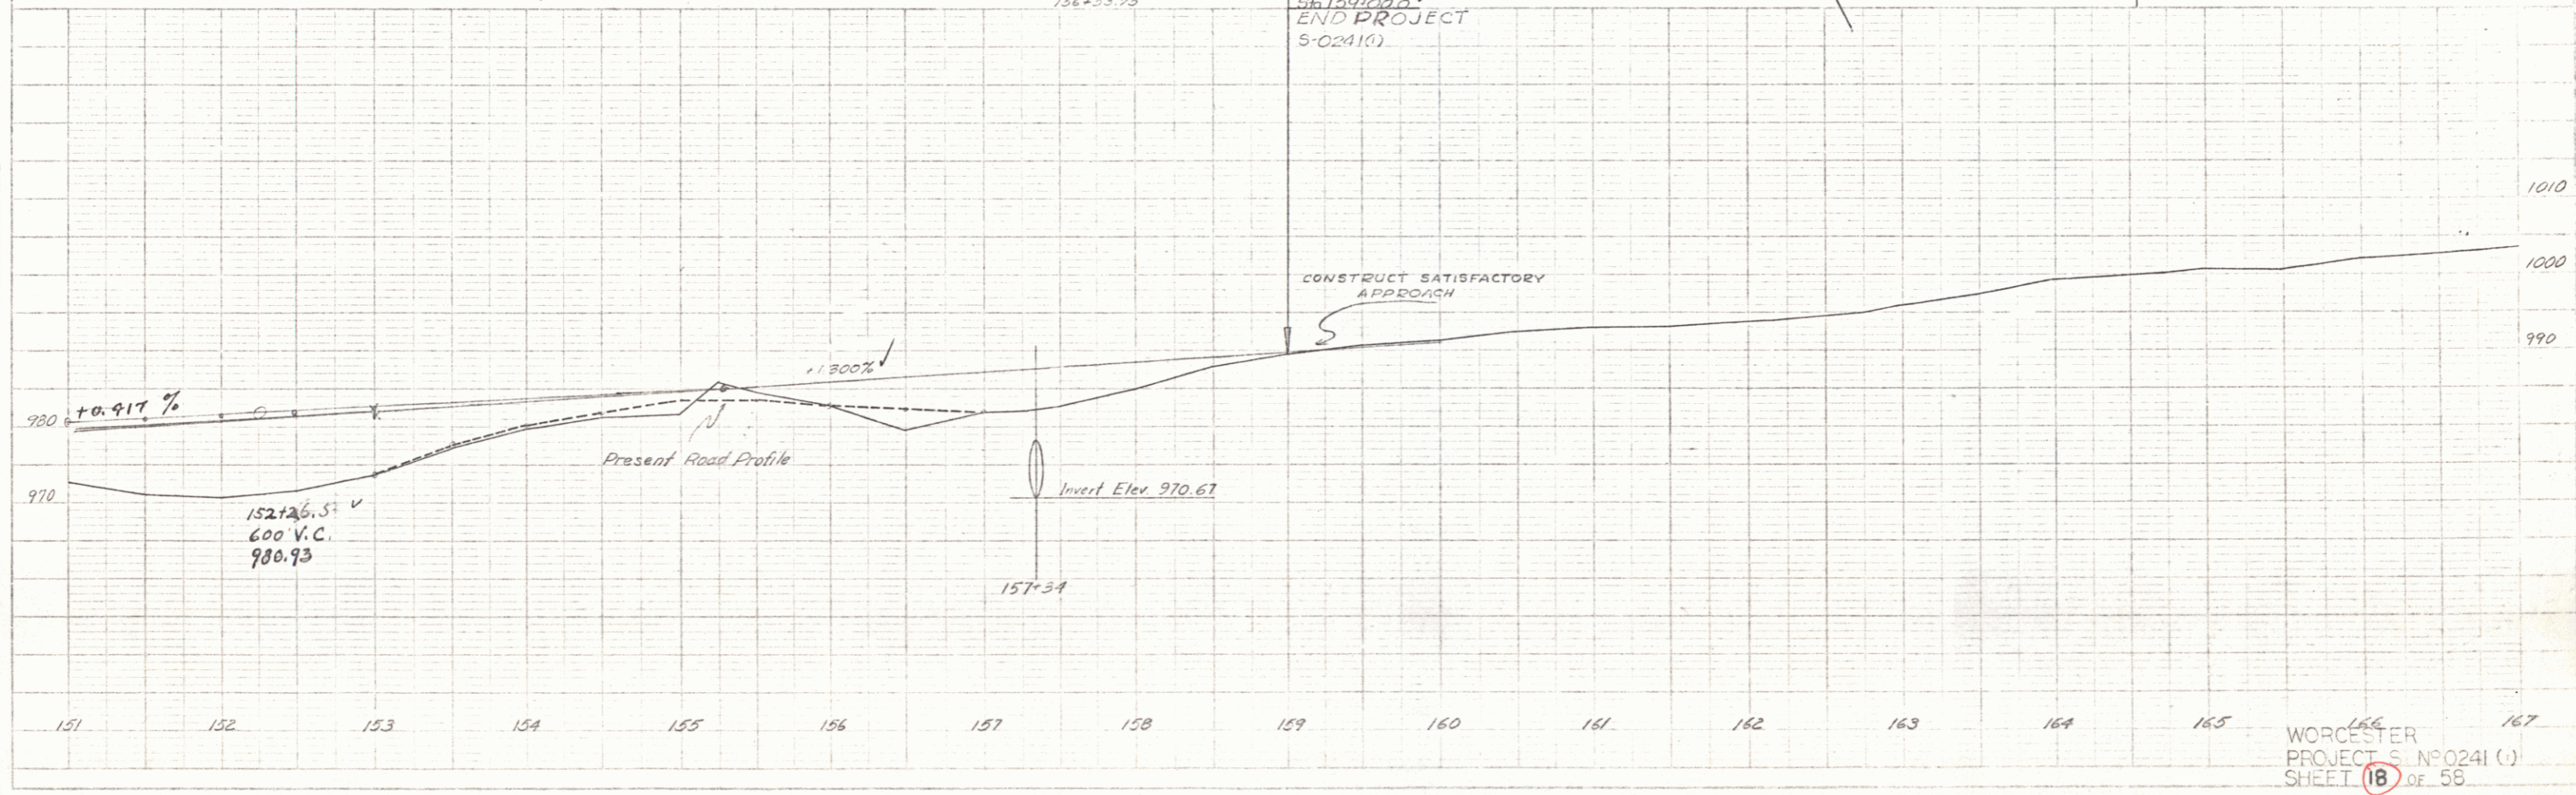


PLAN
 DATE: 1/25/58
 DRAWN BY: [illegible]
 CHECKED BY: [illegible]
 PROJECT: [illegible]

NOTE: [illegible]
 [illegible]
 [illegible]

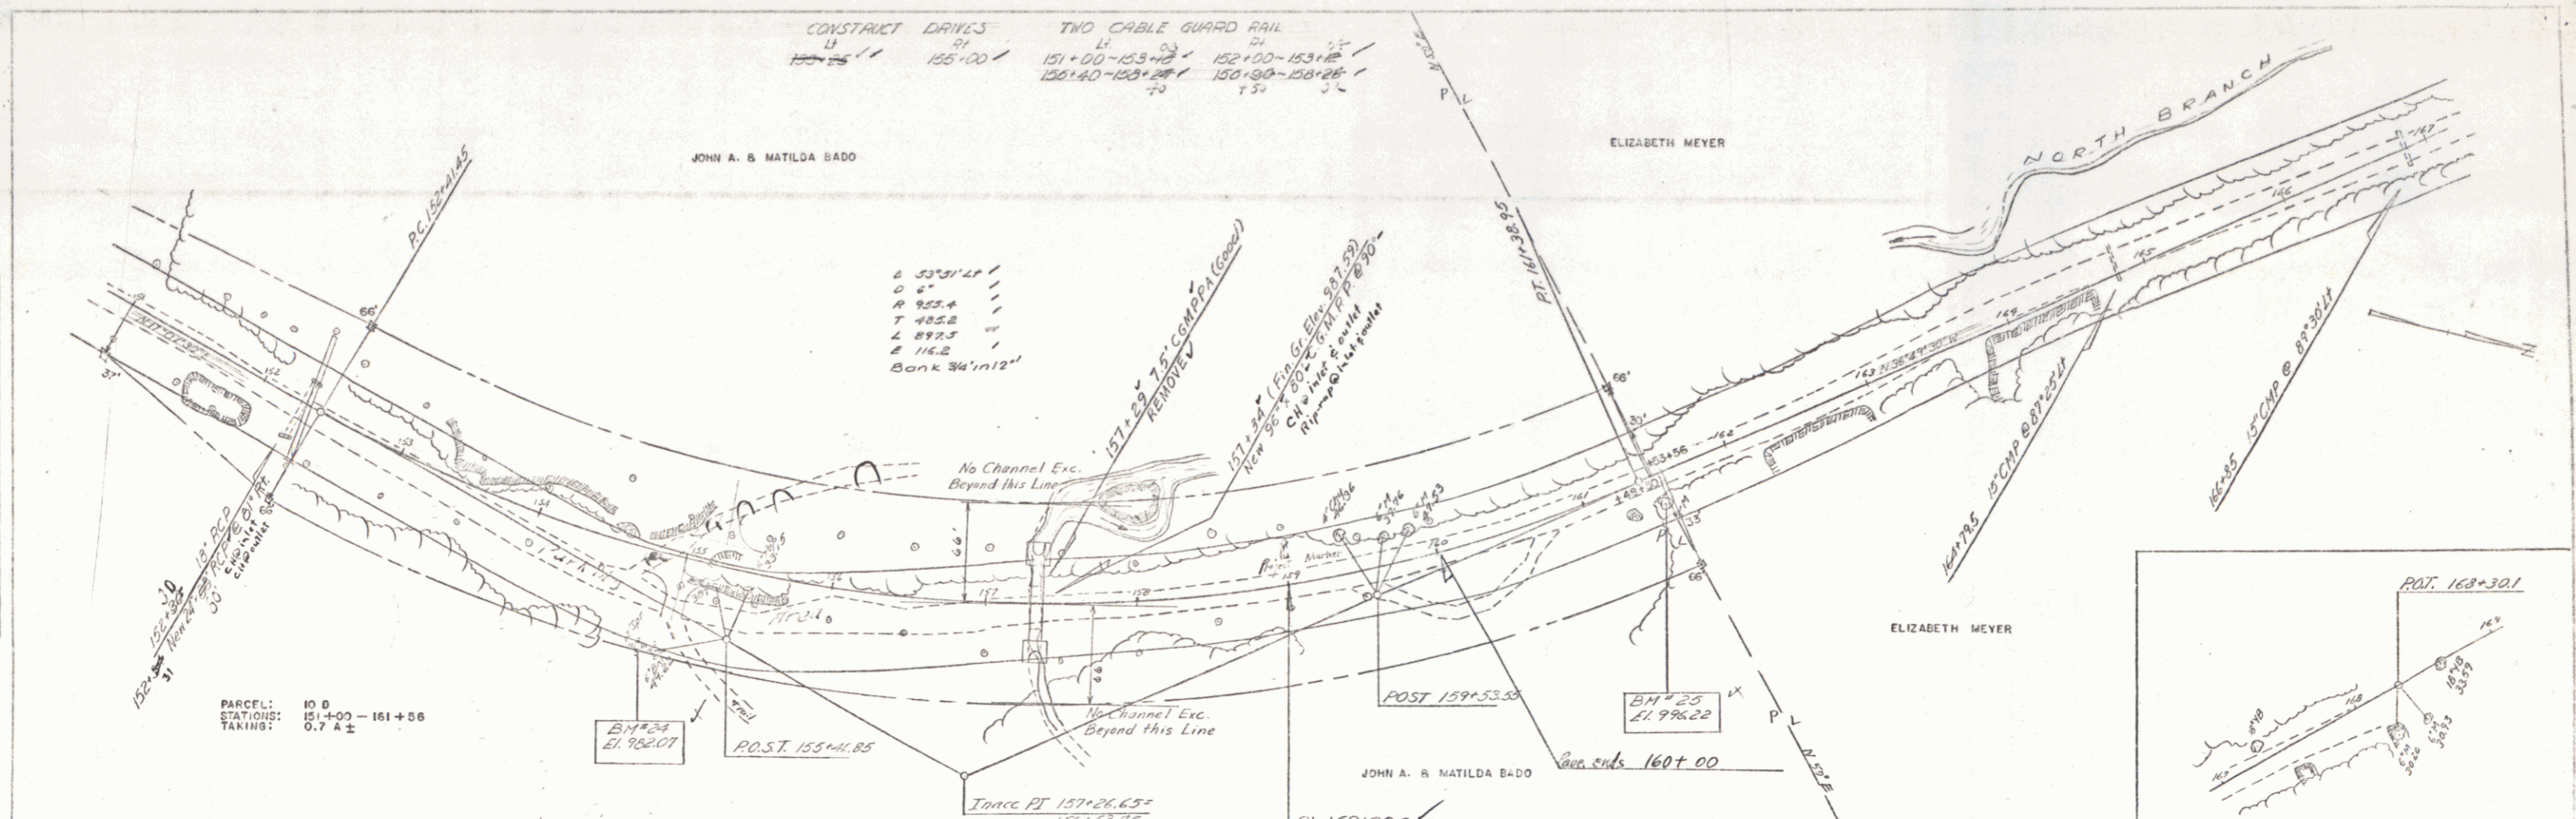

WORCESTER
 PROJECT S. N°0241 (1)
 SHEET 18 OF 58