




PLAN  
 DATE: 11/28/68  
 DRAWN BY: W. J. WELLS  
 CHECKED BY: C. E. H.  
 PROJECT: WORCESTER-ELMORE  
 SHEET: 24 OF 64

PROFILE  
 DATE: 11/28/68  
 DRAWN BY: W. J. WELLS  
 CHECKED BY: C. E. H.  
 PROJECT: WORCESTER-ELMORE  
 SHEET: 24 OF 64

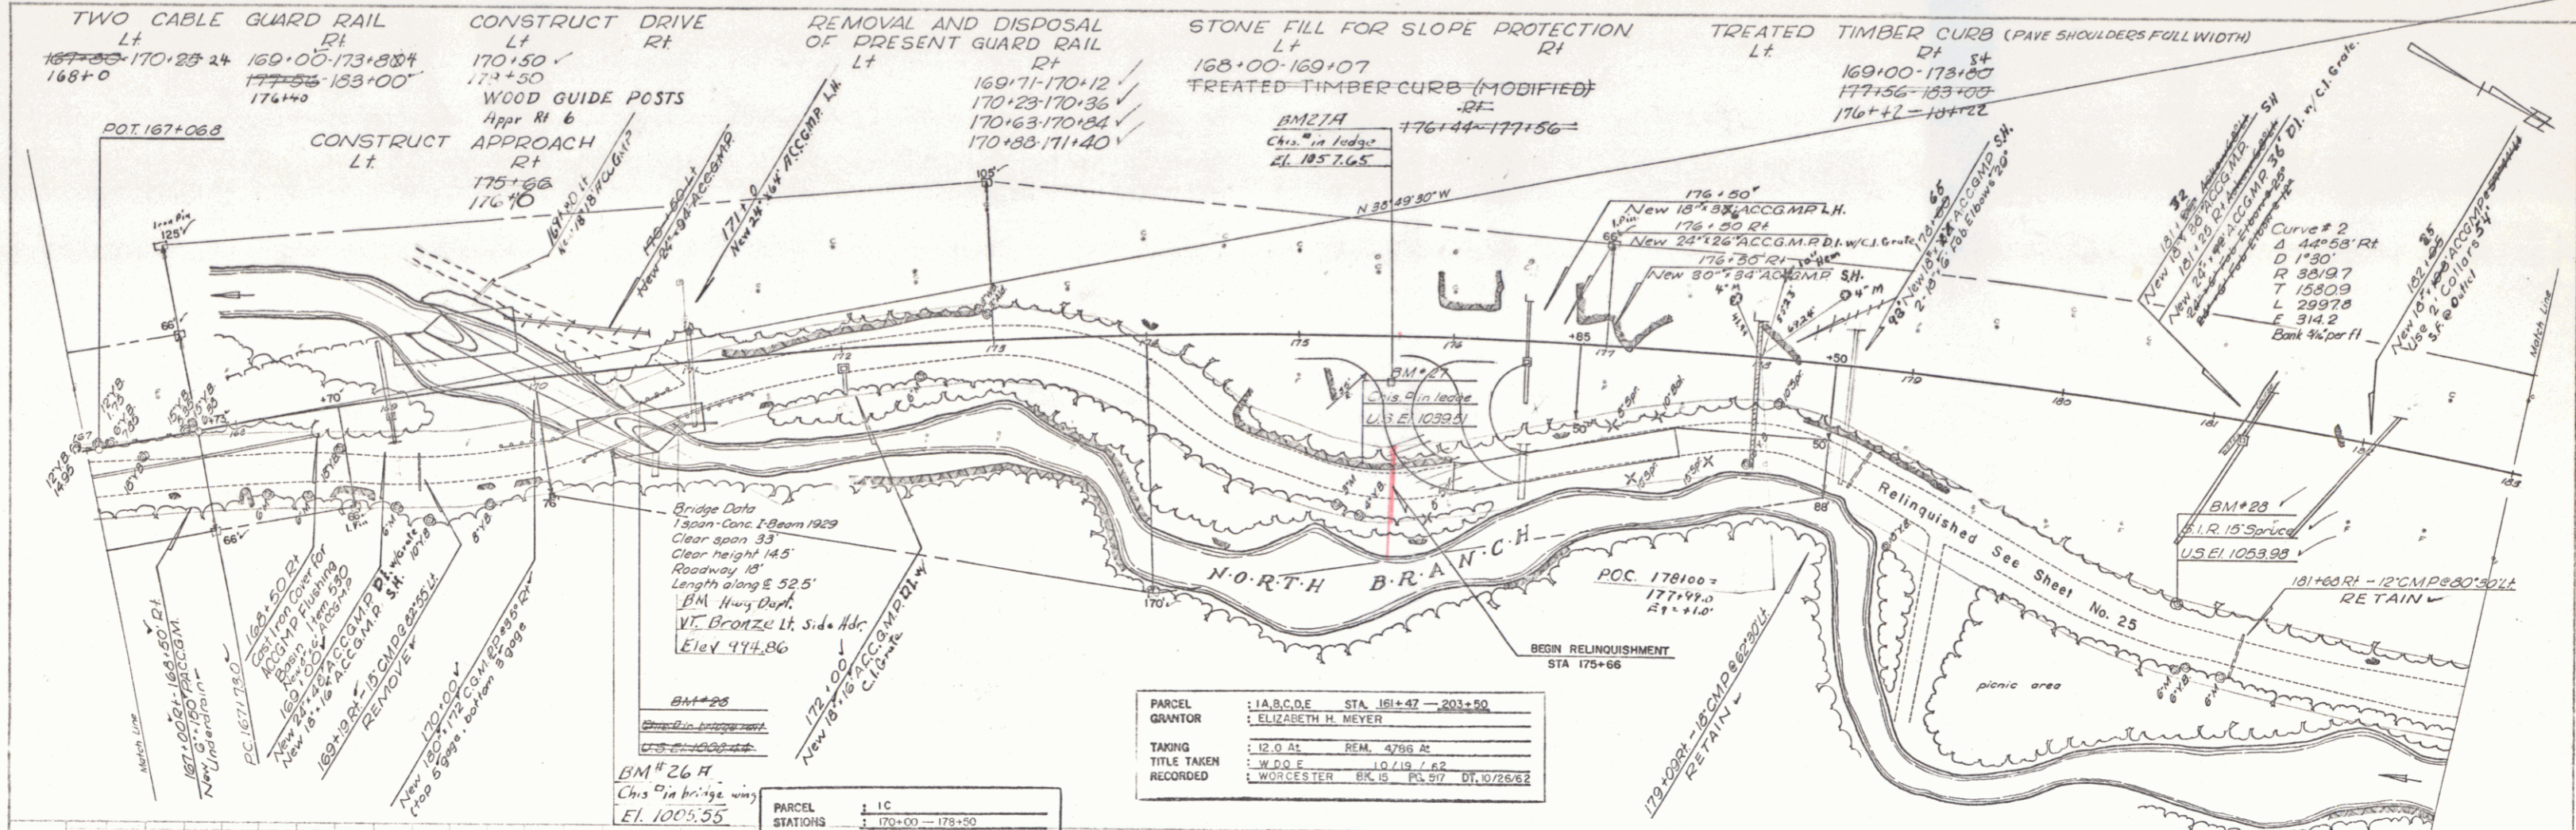

|             |                                      |      |                 |
|-------------|--------------------------------------|------|-----------------|
| PARCEL      | : I.A.B.C.D.E                        | STA  | 181+47 - 203+50 |
| GRANTOR     | : ELIZABETH H. MEYER                 |      |                 |
| TAKING      | : 12 0 At                            | REM. | 4796 At         |
| TITLE TAKEN | : W.D.F. 10/19/62                    |      |                 |
| RECORDED    | : WORCESTER BK 15 PL 517 DT 10/26/62 |      |                 |

|          |                   |
|----------|-------------------|
| PARCEL   | : IC              |
| STATIONS | : 170+00 - 178+50 |
| TAKING   | : I.A.A.          |

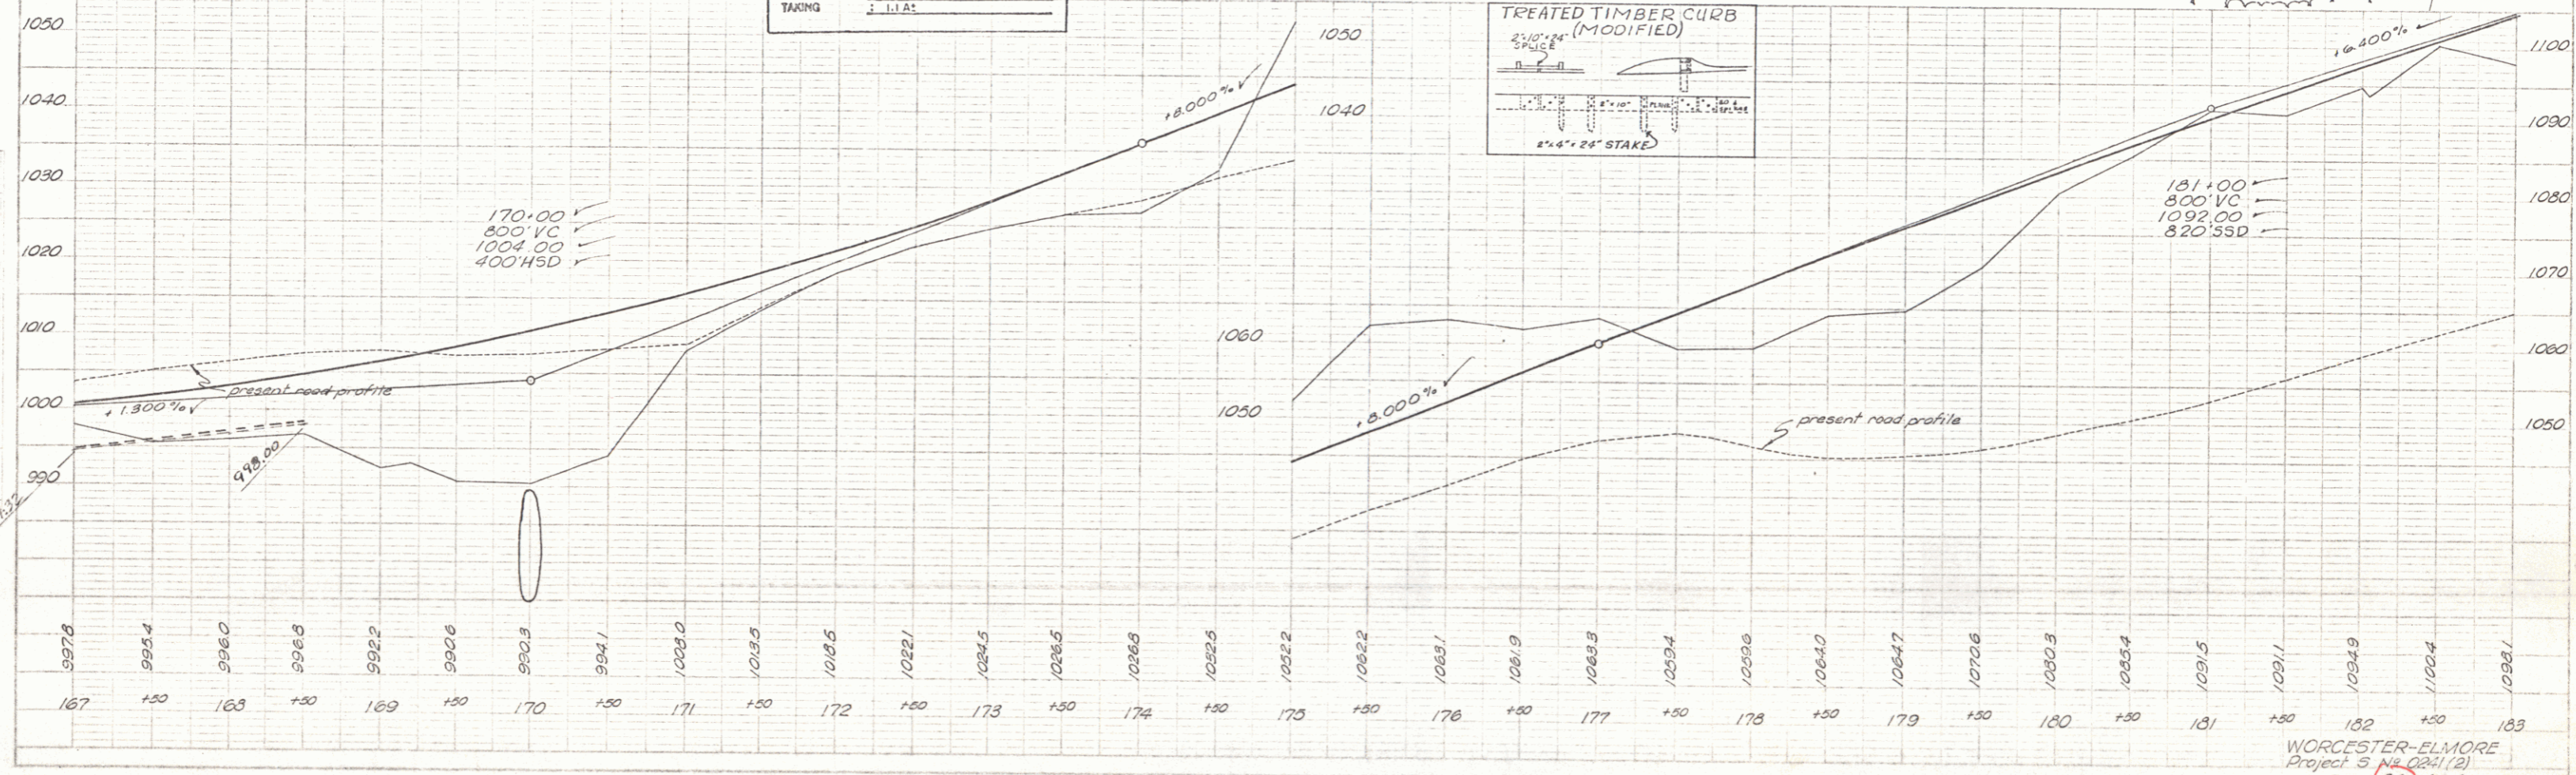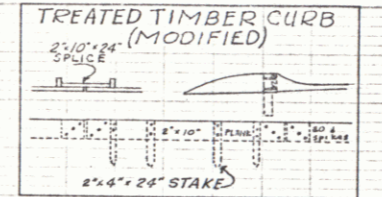

WORCESTER-ELMORE  
 Project 3 (11-28-68) (2)  
 Sheet 24 of 64