



PLAN	DATE	BY	CHECKED
NO. 1	11/15/62	W. W. WOOD	C.E.H.
NO. 2			
NO. 3			
NO. 4			
NO. 5			
NO. 6			
NO. 7			
NO. 8			
NO. 9			
NO. 10			

PROFILE	DATE	BY	CHECKED
NO. 1	11/15/62	W. W. WOOD	C.E.H.
NO. 2			
NO. 3			
NO. 4			
NO. 5			
NO. 6			
NO. 7			
NO. 8			
NO. 9			
NO. 10			

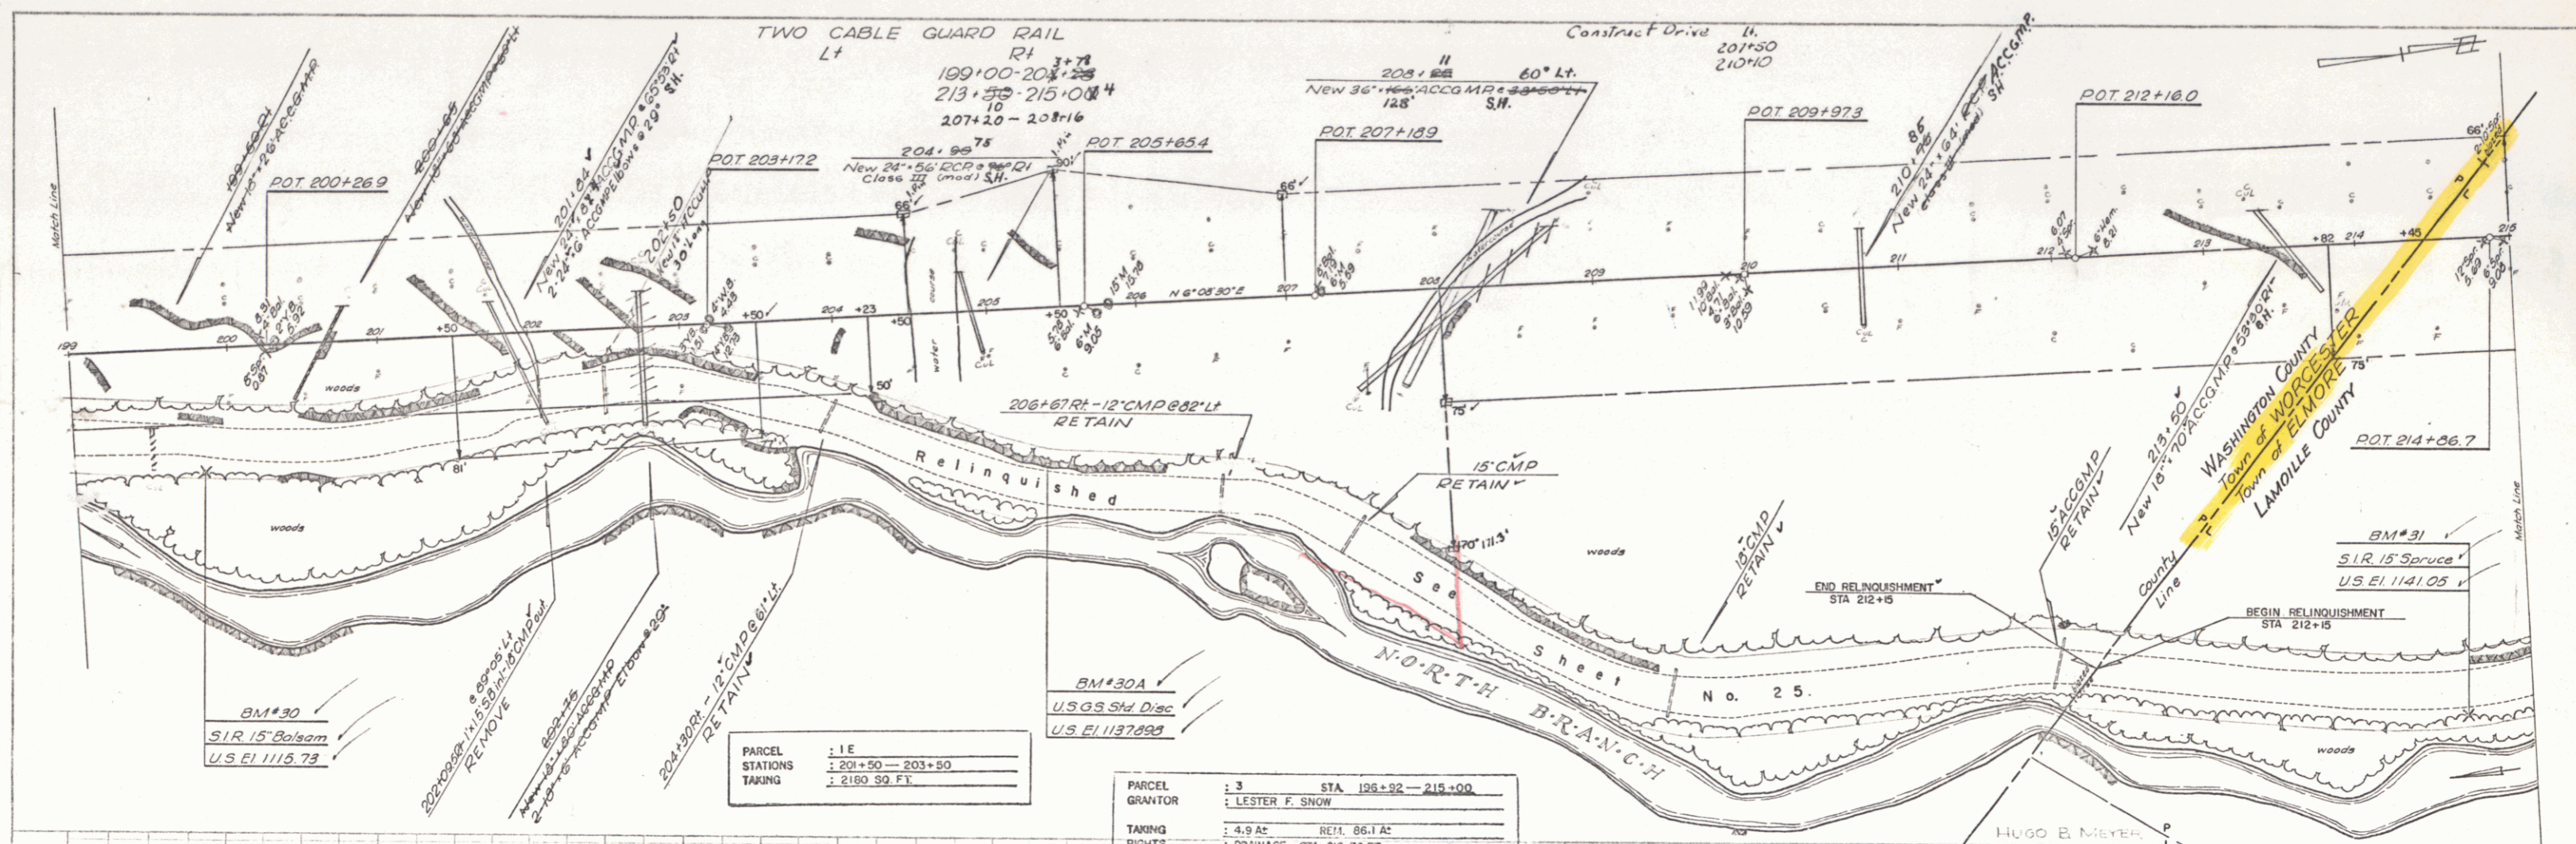

PARCEL	: 1 E
STATIONS	: 201+50 - 203+80
TAKING	: 2190.99 FT.

PARCEL	: 3	STA. 196+92 - 215+00
GRANTOR	: LESTER F. SNOW	
TAKING	: 4.9 AC.	REL. 86.1 AC.
RIGHTS	: DRAINAGE - STA. 207+76 RT.	
TITLE TAKEN	: WOOD	10/17/62
RECORDED	: WORCESTER BK. 15 PG. 516 DT. 10/26/62	

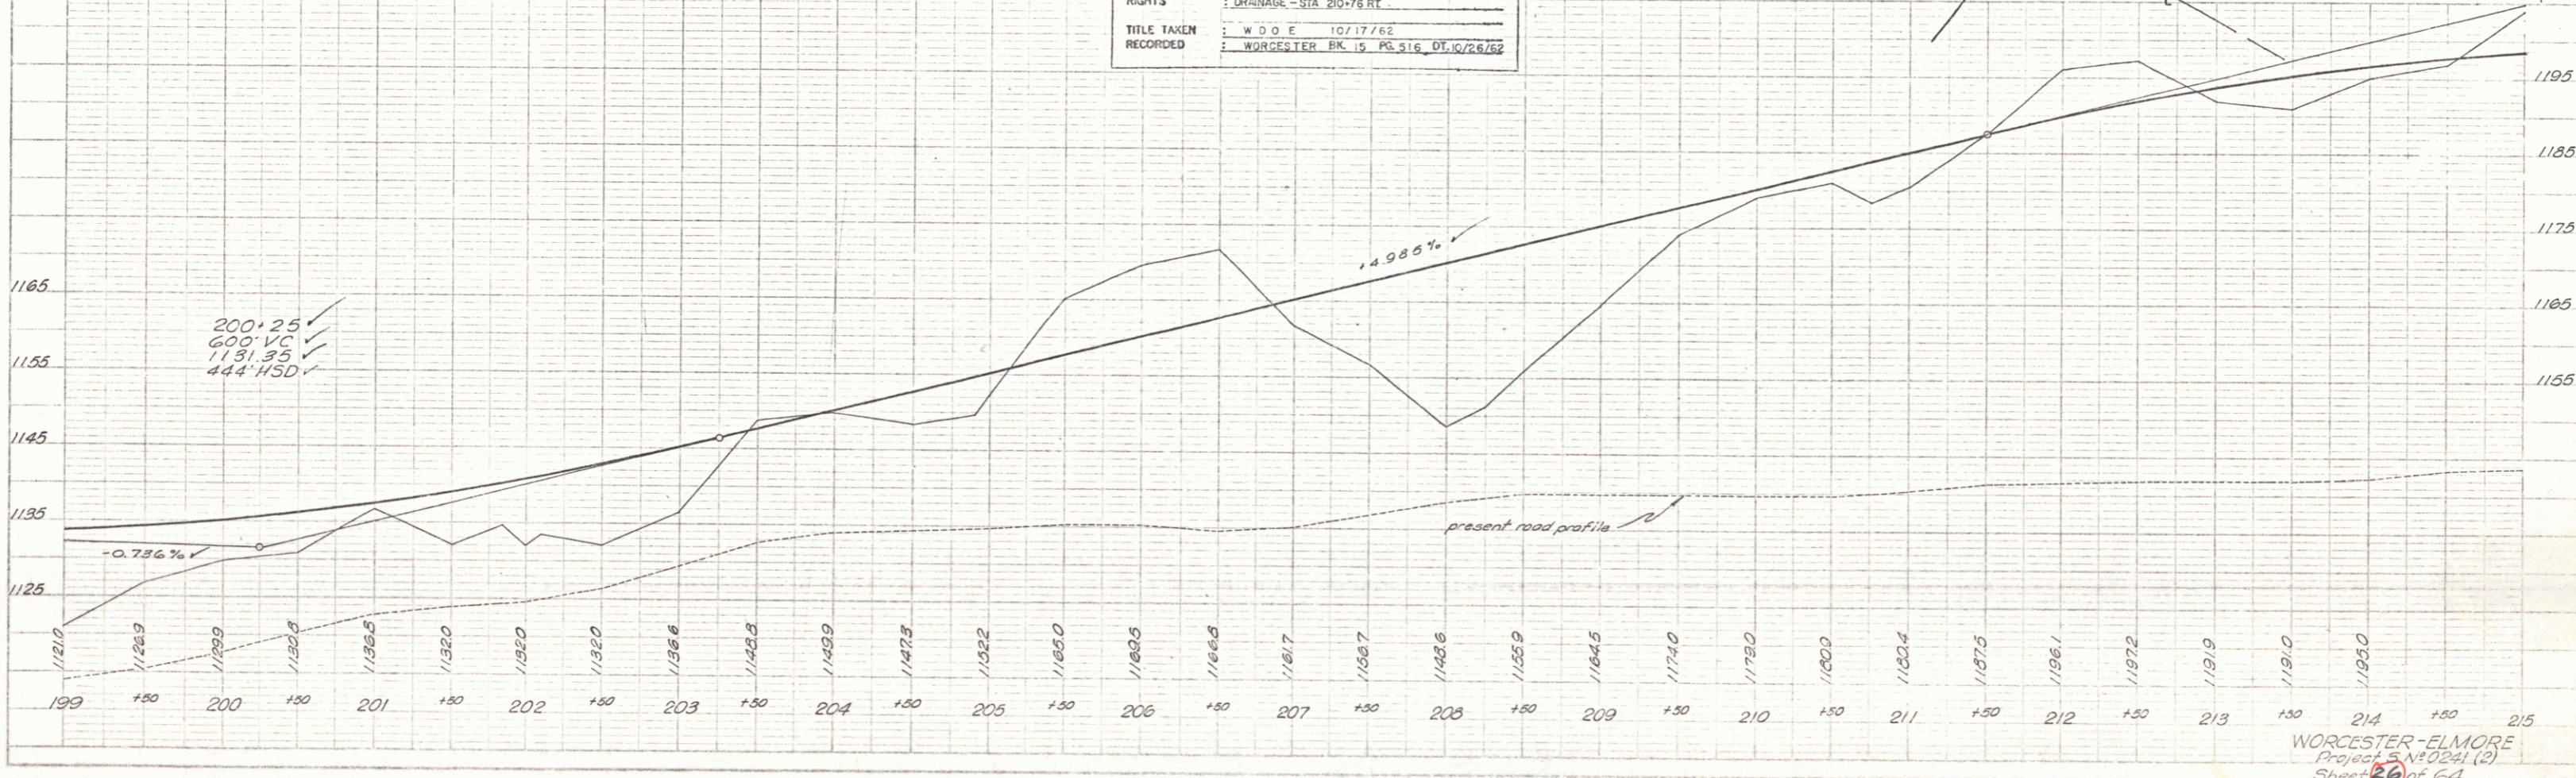

WORCESTER-ELMORE
Project 5 N10241 (2)
Sheet 26 of 64