
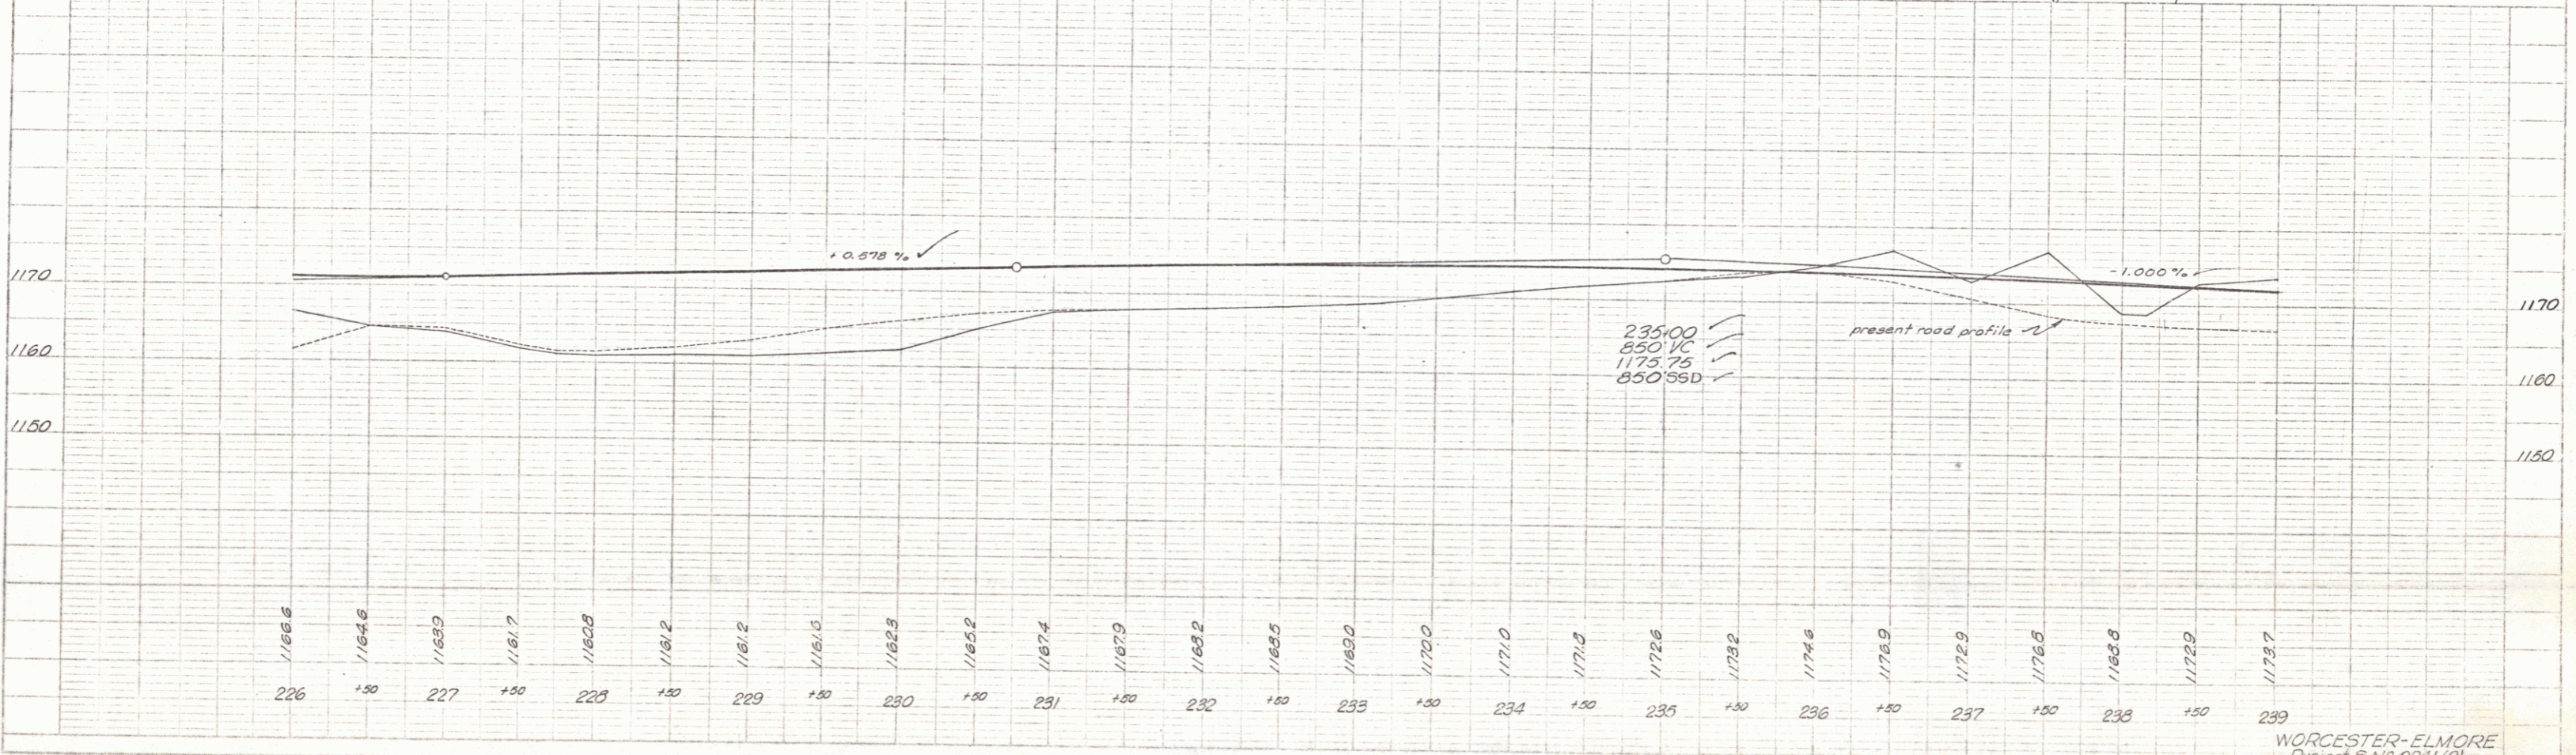


PLAN  
 DATE: 11/17/81  
 DRAWN BY: [unclear]  
 CHECKED BY: [unclear]  
 PROJECT: [unclear]

PROFILE  
 DATE: 11/17/81  
 DRAWN BY: [unclear]  
 CHECKED BY: [unclear]  
 PROJECT: [unclear]

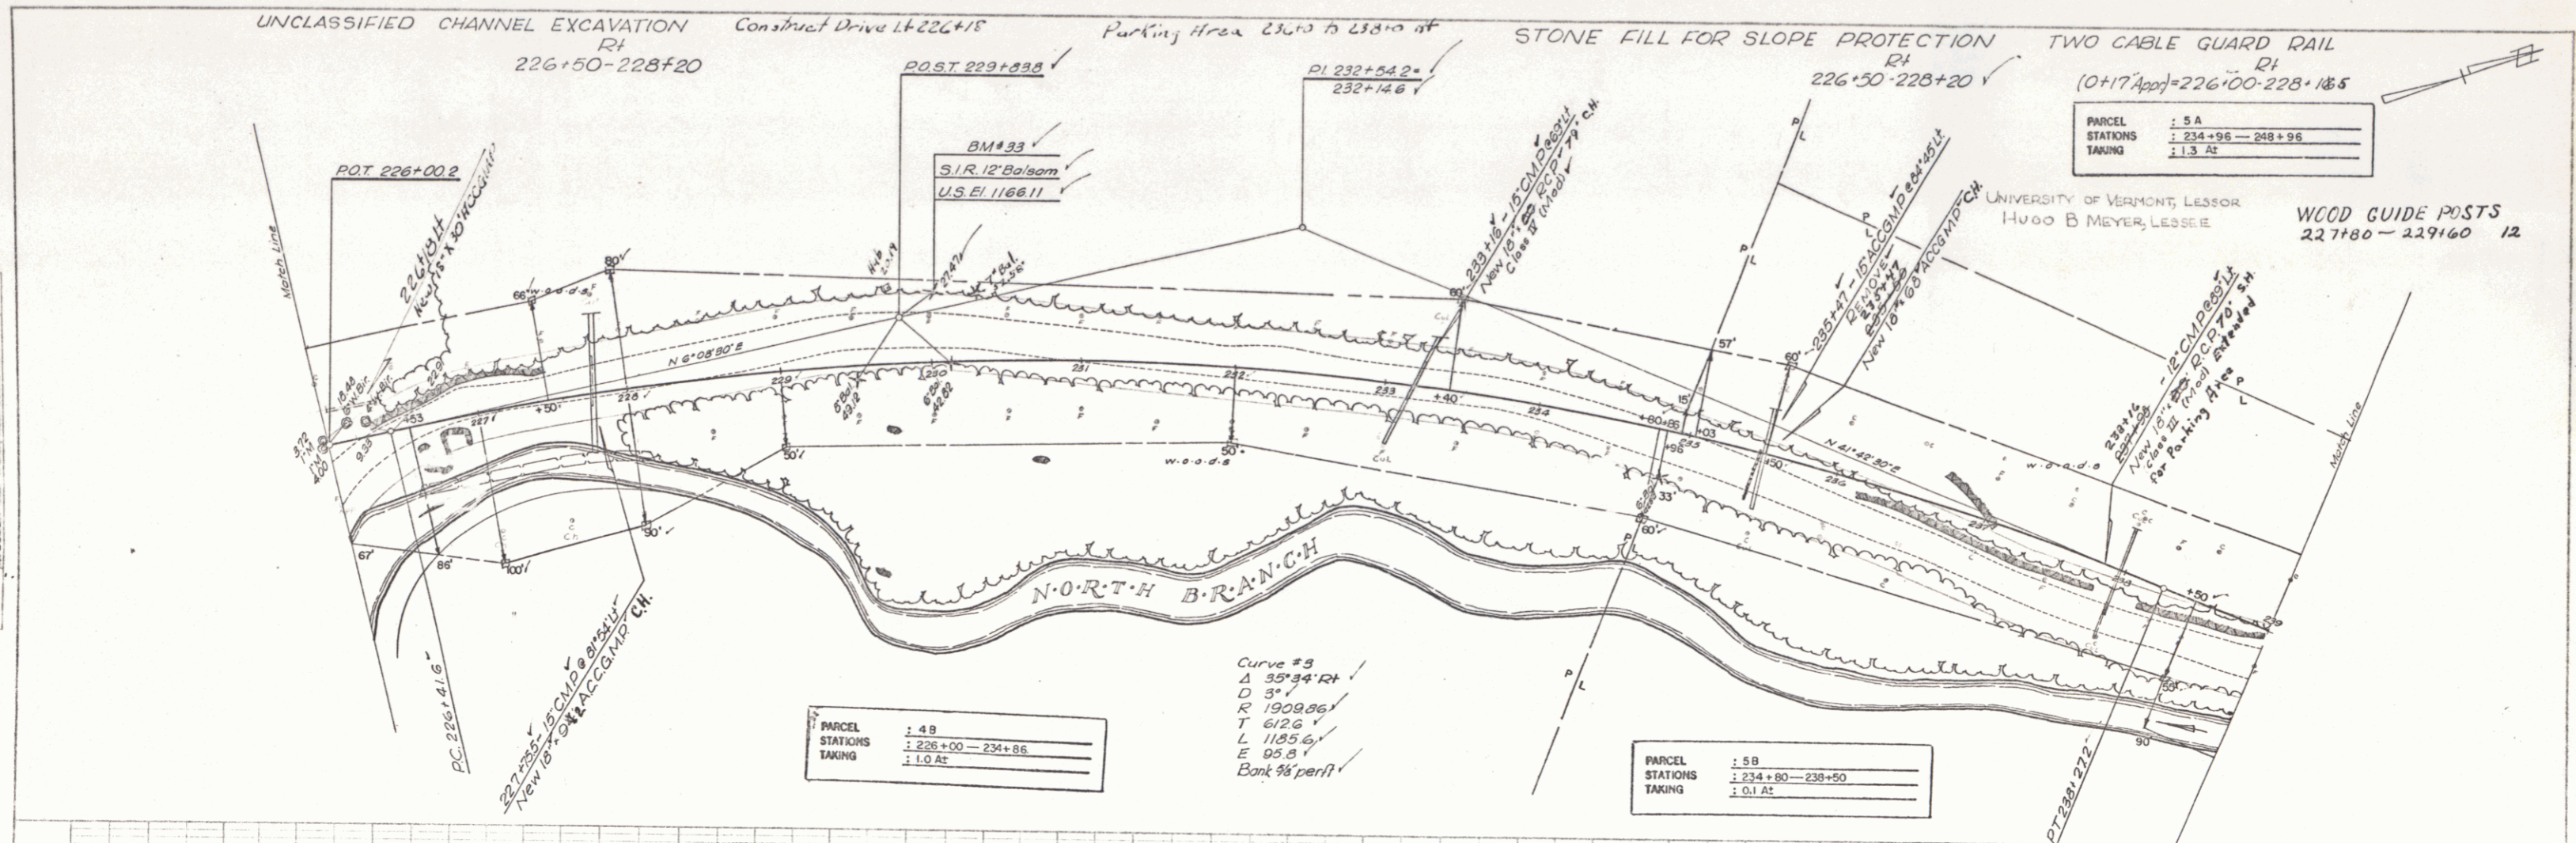

SCALE: 1" = 40' HORIZ. 1" = 4' VERT.  
 DRAWING NO. [unclear]

WORCESTER-ELMORE  
 Project No. 0241(2)  
 Sheet 21 of 64