


CONSTRUCT DRIVE Rt 298+88' 311+67'
 TWO CABLE GUARD RAIL Lt 304+52-305+06
 REMOVING AND RESETTING TWO CABLE GUARD RAIL WITH WOOD POSTS Lt 308+42-309+06
 MUCK EXCAVATION 298+00-304+00
 DRILLING & BLASTING OF SOLID ROCK SUBGRADE 304+00-304+60

PLAN
 DATE 1/15/65
 DRAWN BY W. Smith
 CHECKED BY J. Smith
 NO. 1165

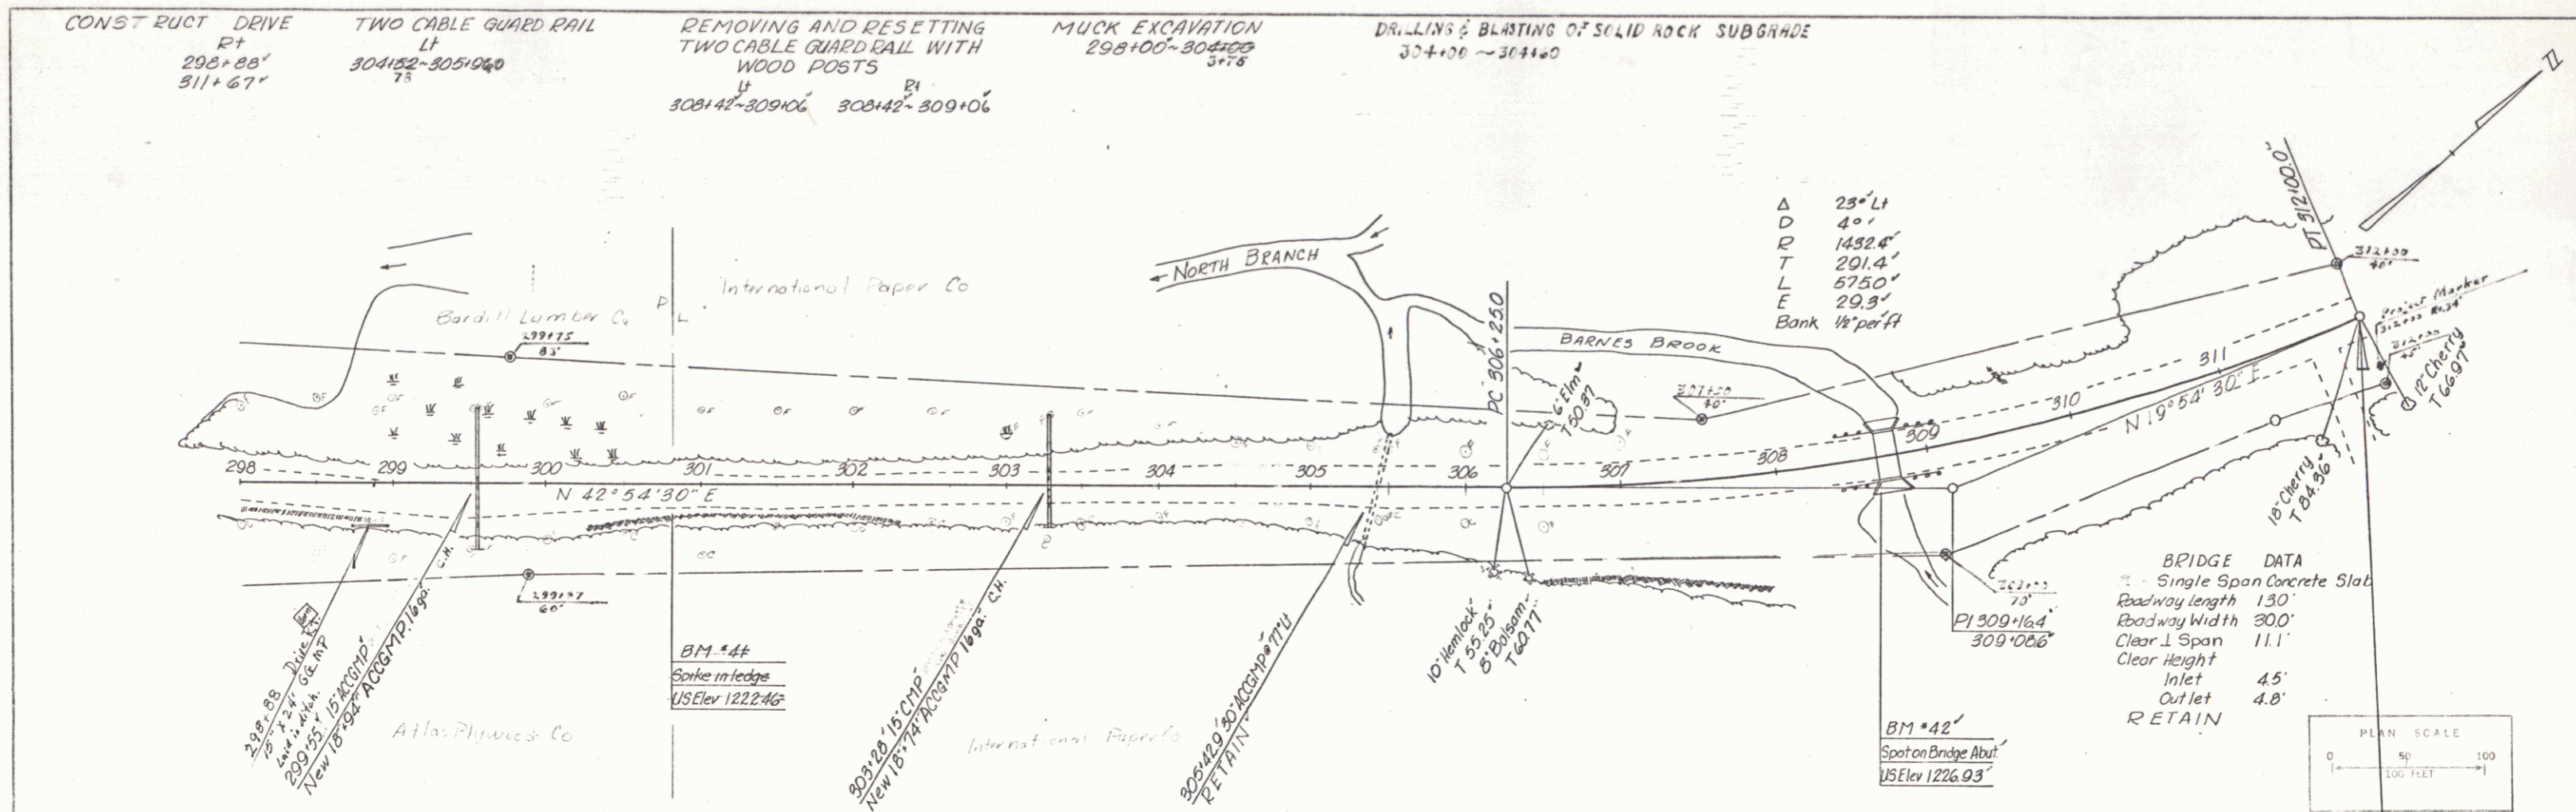

PROFILE
 DATE 1/15/65
 DRAWN BY W. Smith
 CHECKED BY J. Smith
 NO. 1165

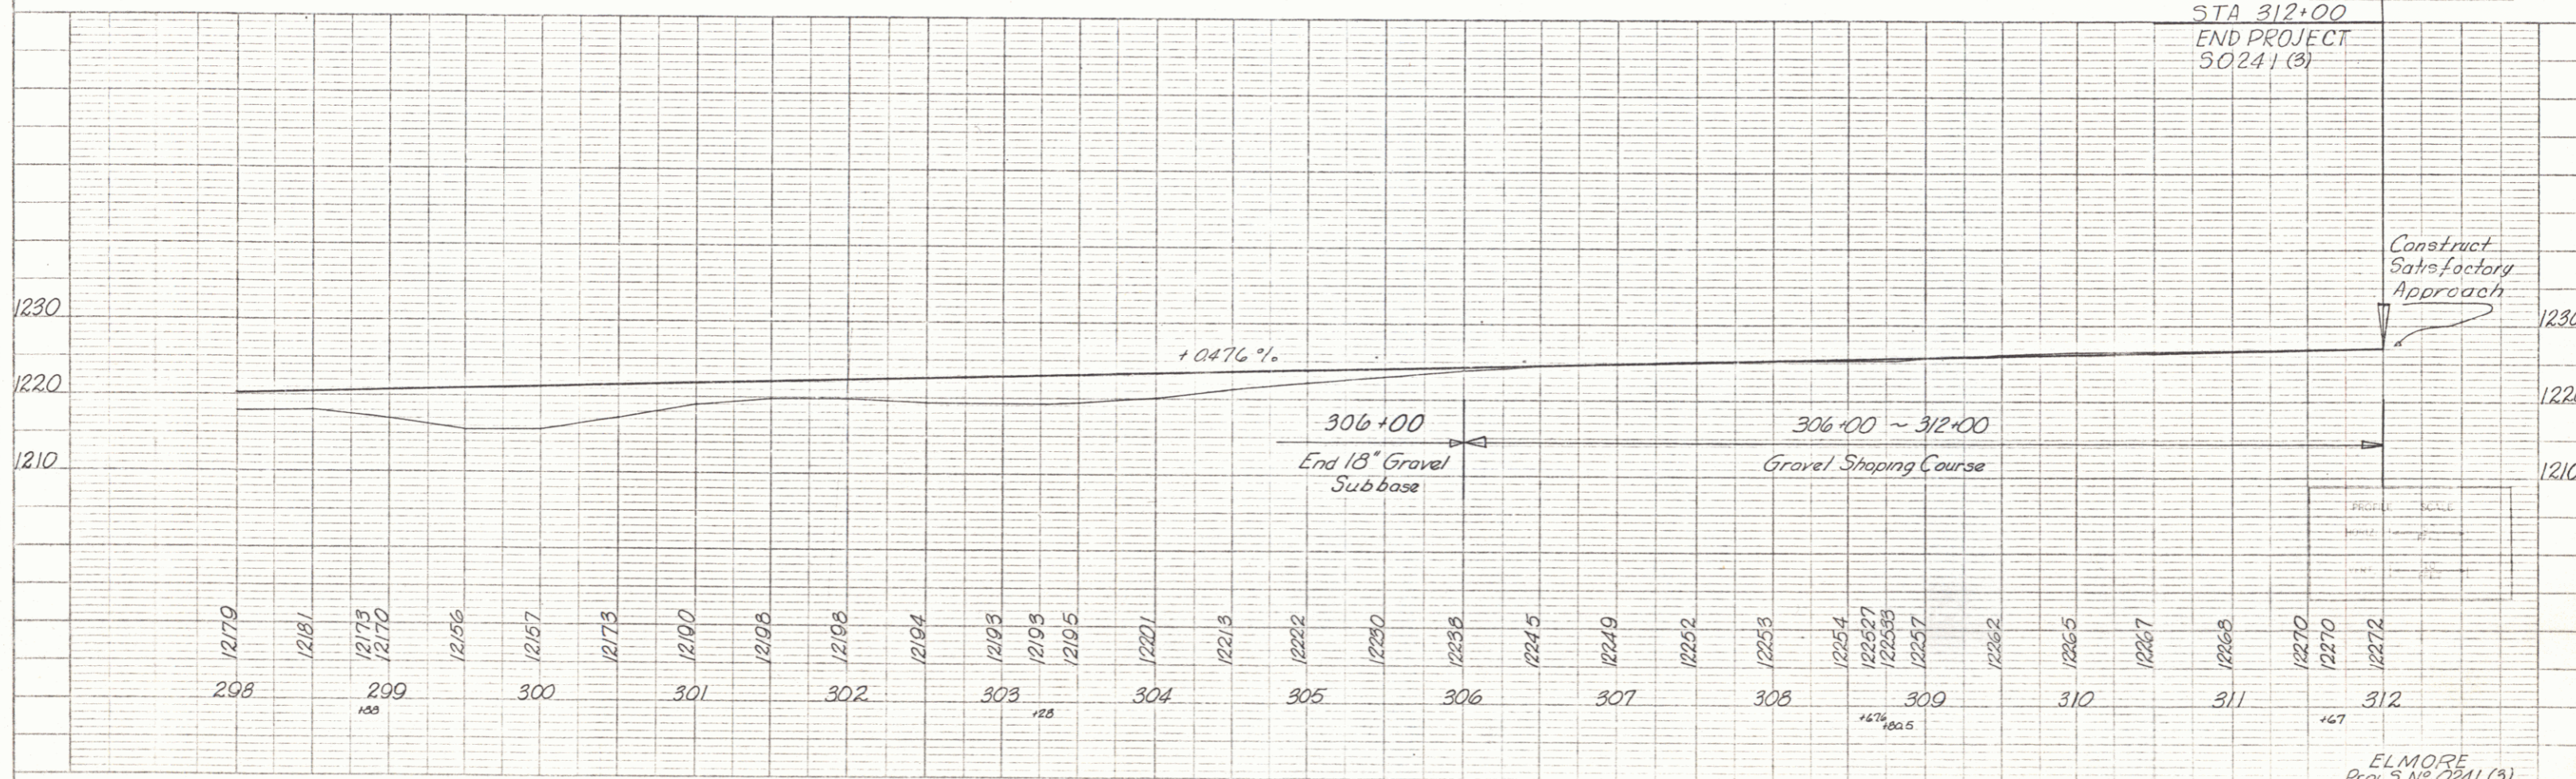


PLATE 1 - PLAN, PROFILE & P.A.R.E. STANDARD
 NEW YORK STATE DEPARTMENT OF TRANSPORTATION
 DIVISION OF HIGHWAYS
 1964 EDITION

ELMORE
 Proj 5 No 0841 (3)
 Sheet 32 of 61