



POOR ORIGINAL COPY

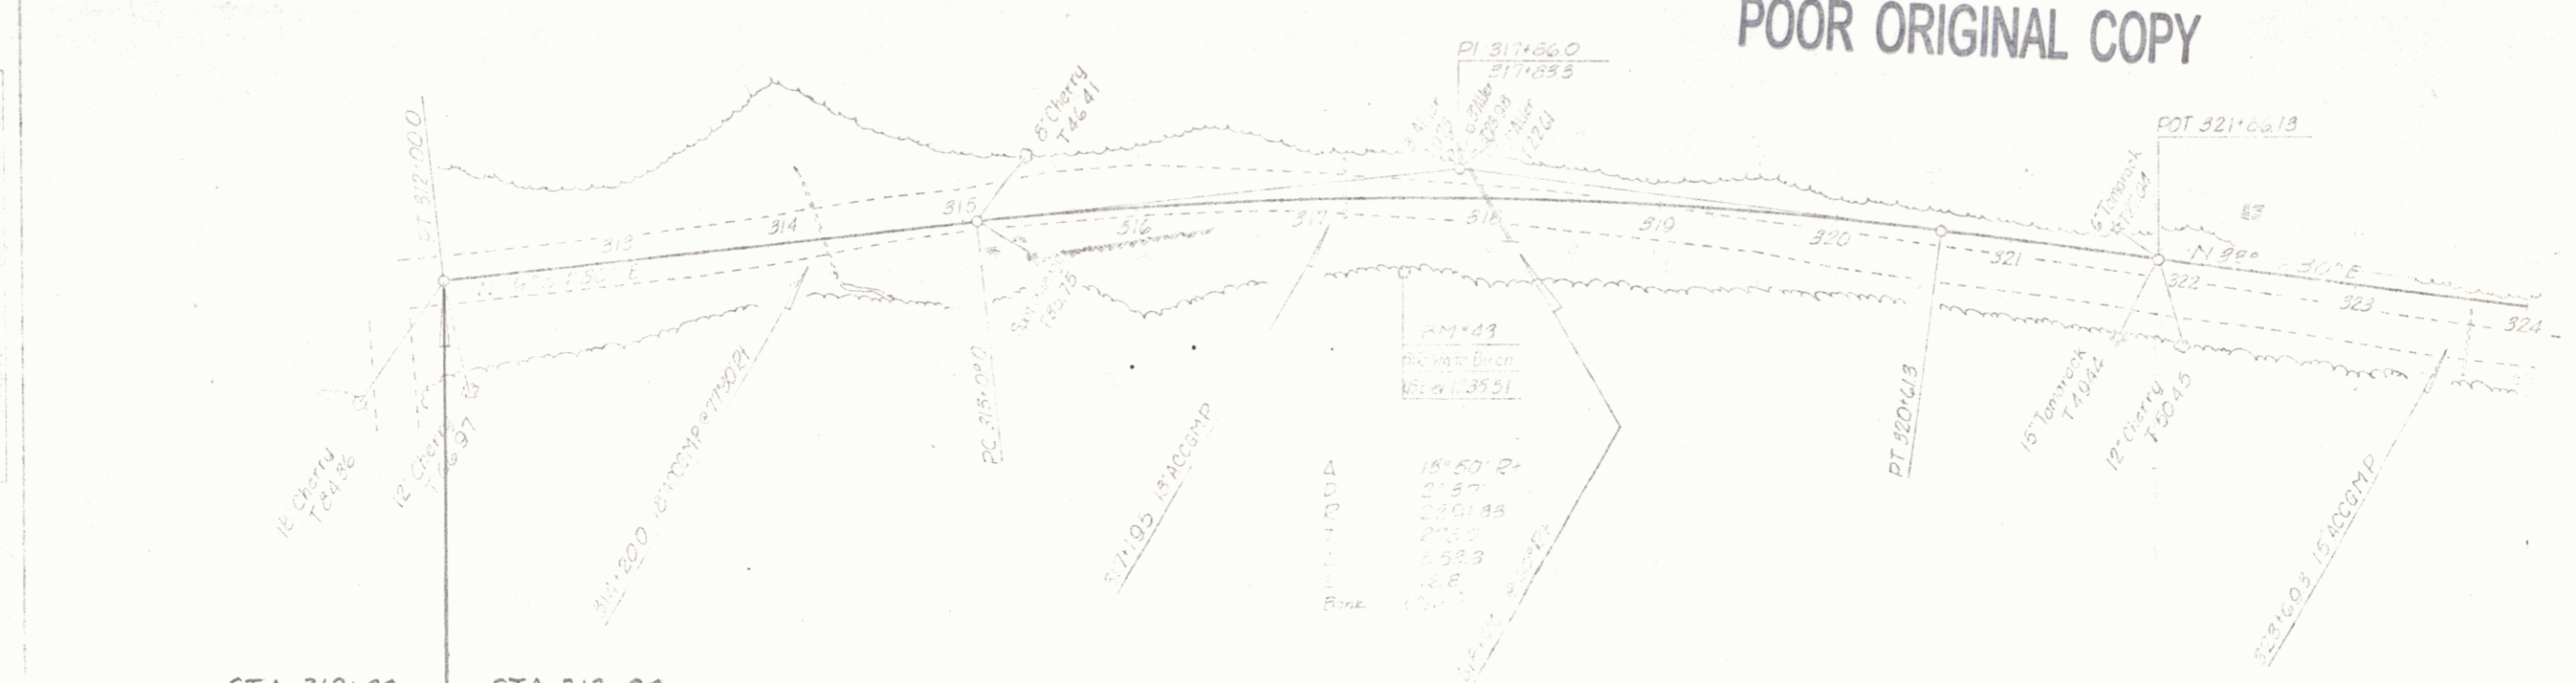

STA 312+00
END PROJECT
50241(3)

STA 312+00
BEGIN PROJECT
50241(4)

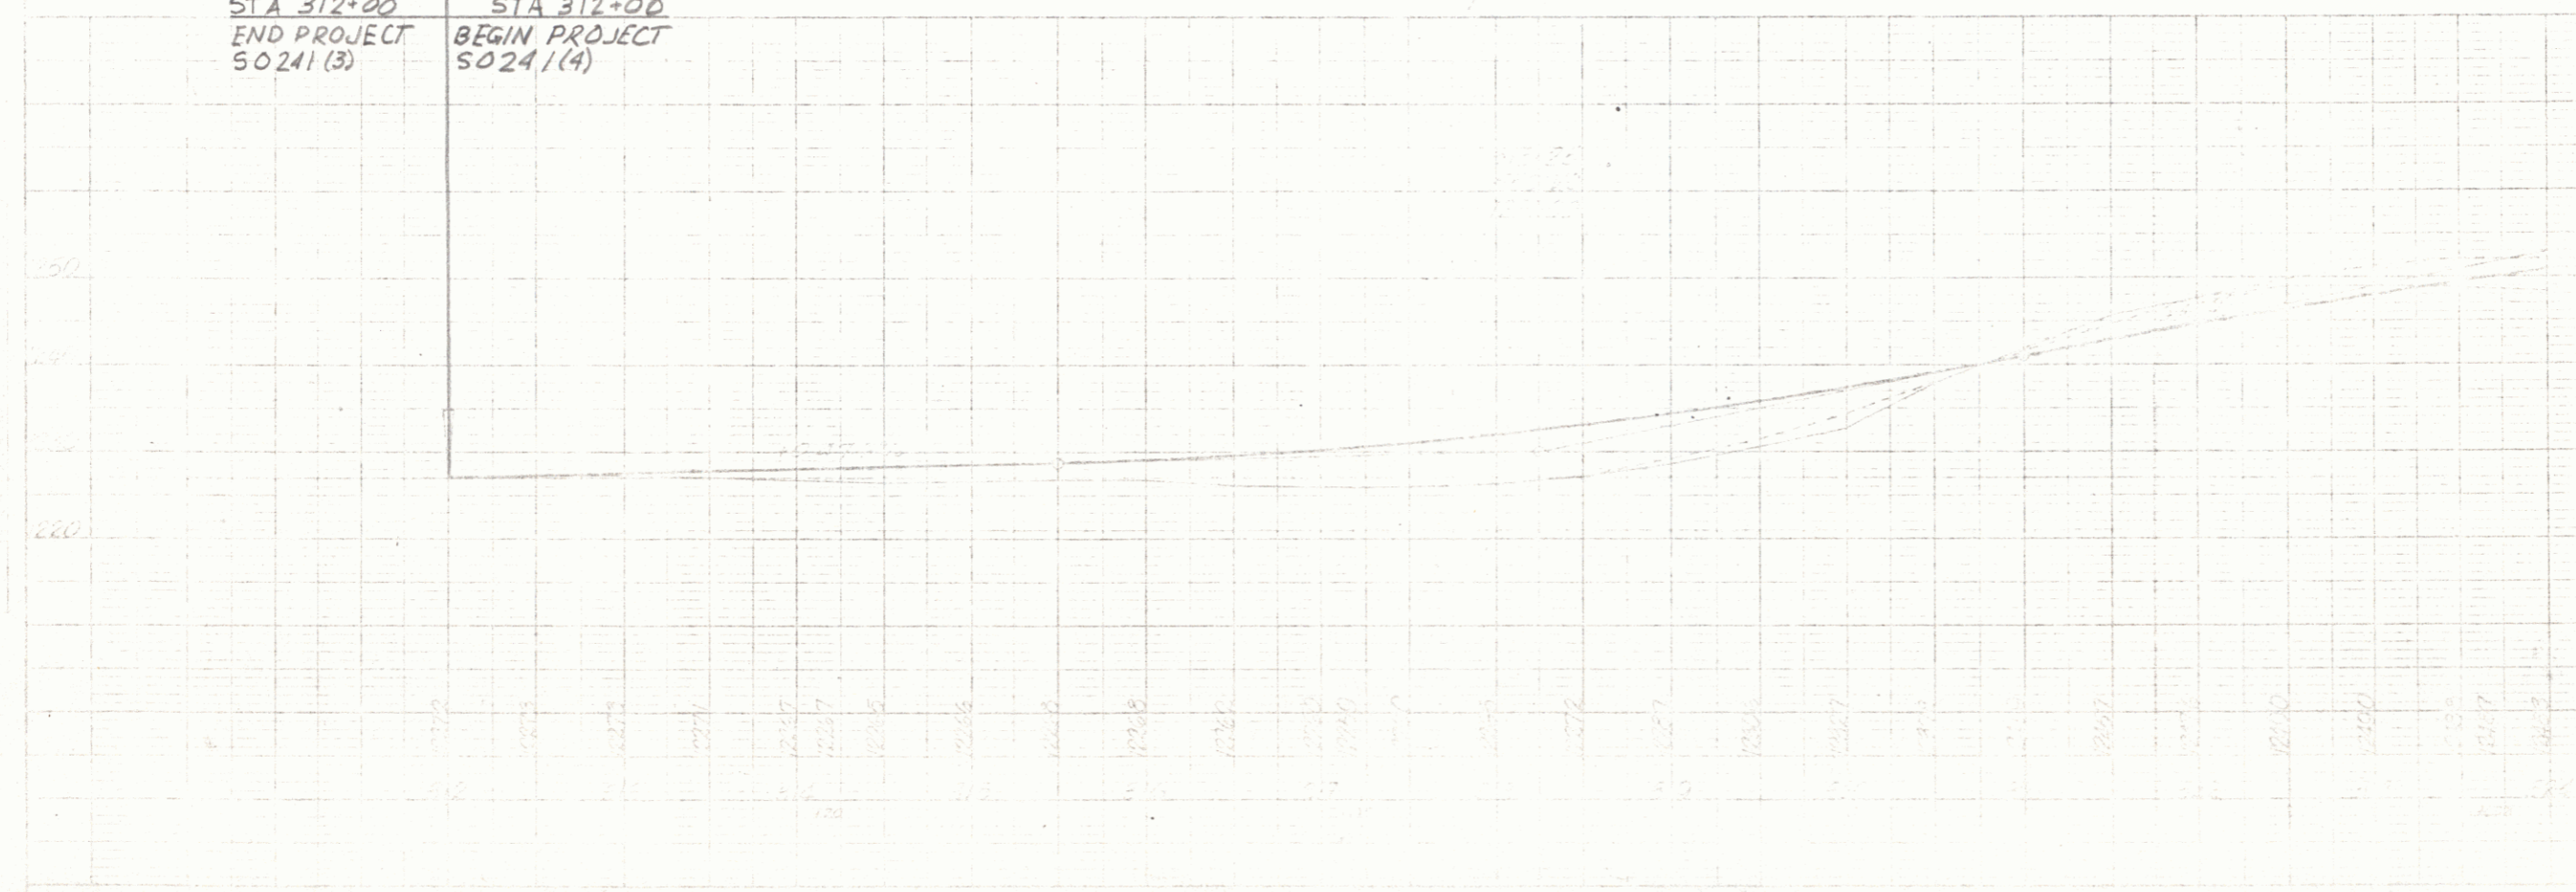

89 61