
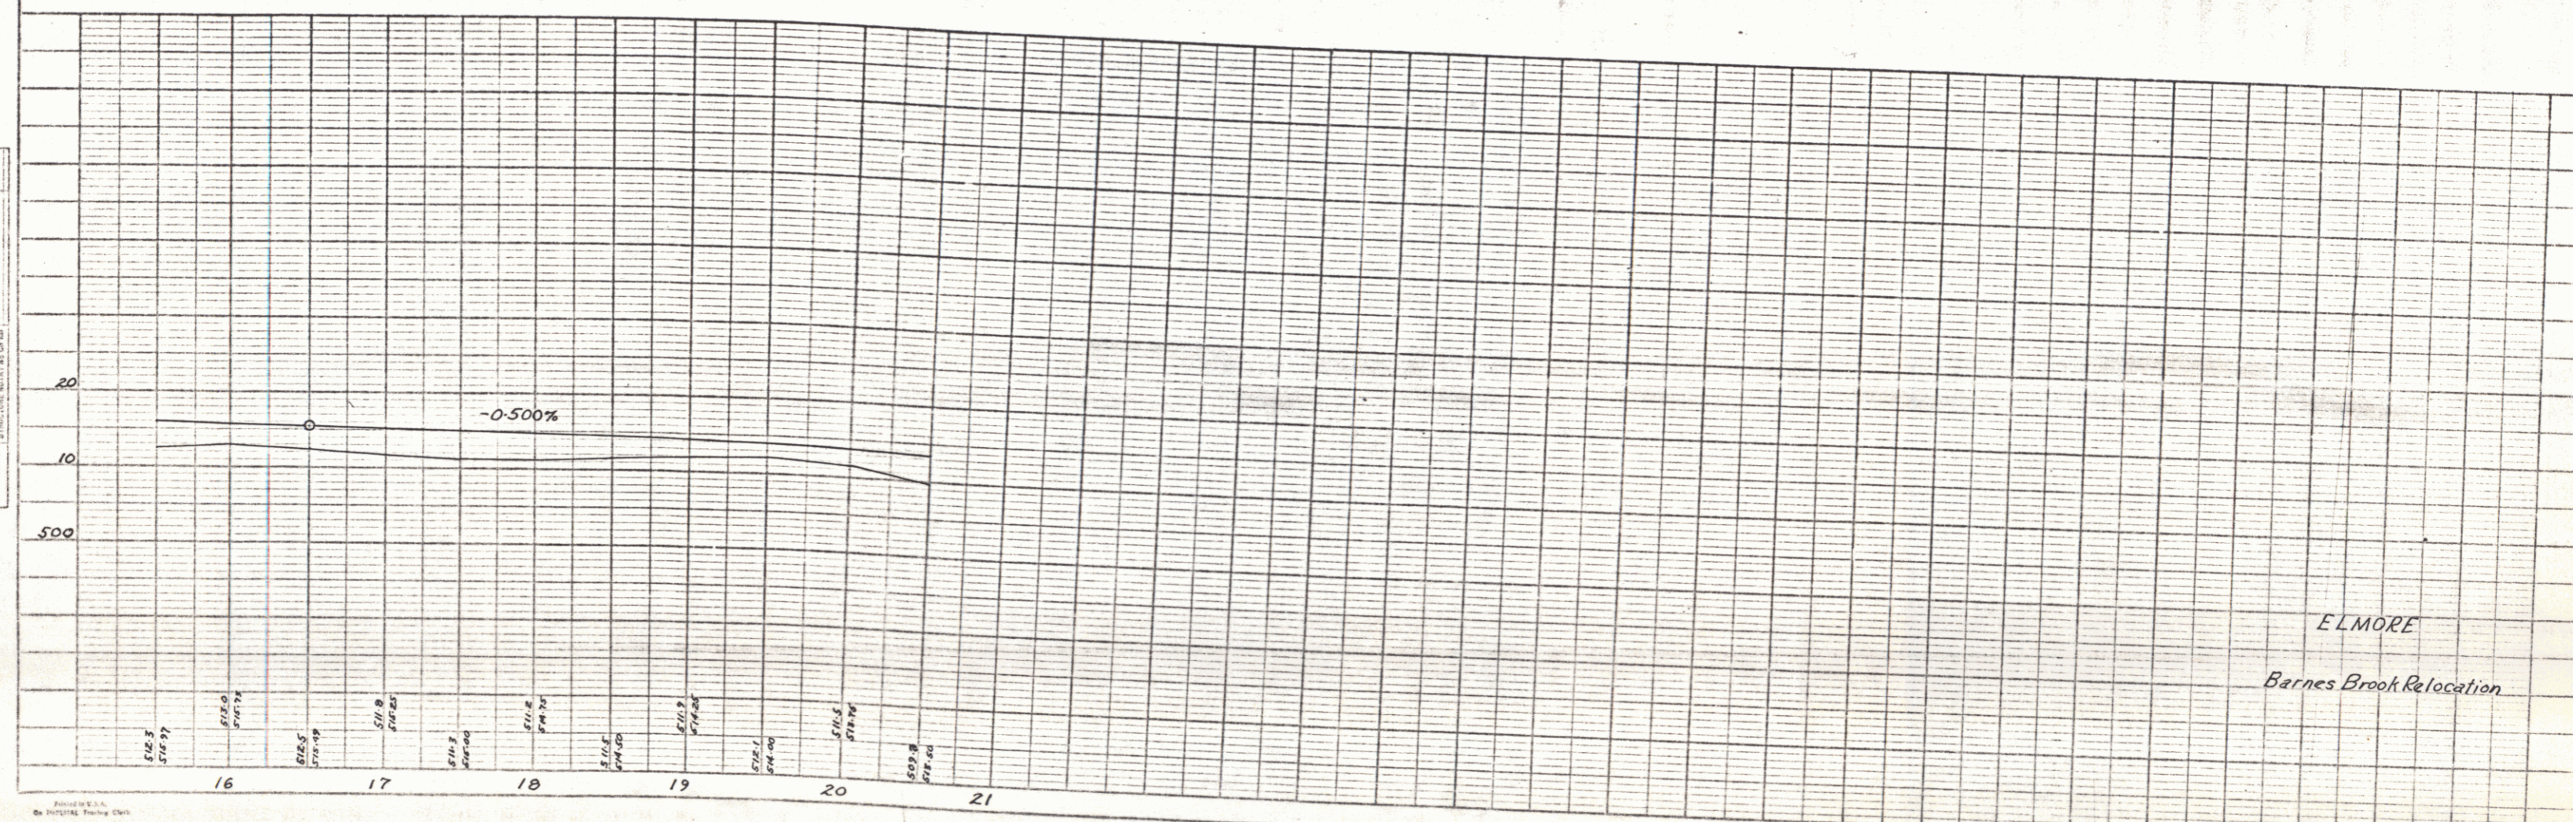


PLAN	DATE	BY
DATE	BY	BY
DATE	BY	BY
PROFILE	DATE	BY
DATE	BY	BY
DATE	BY	BY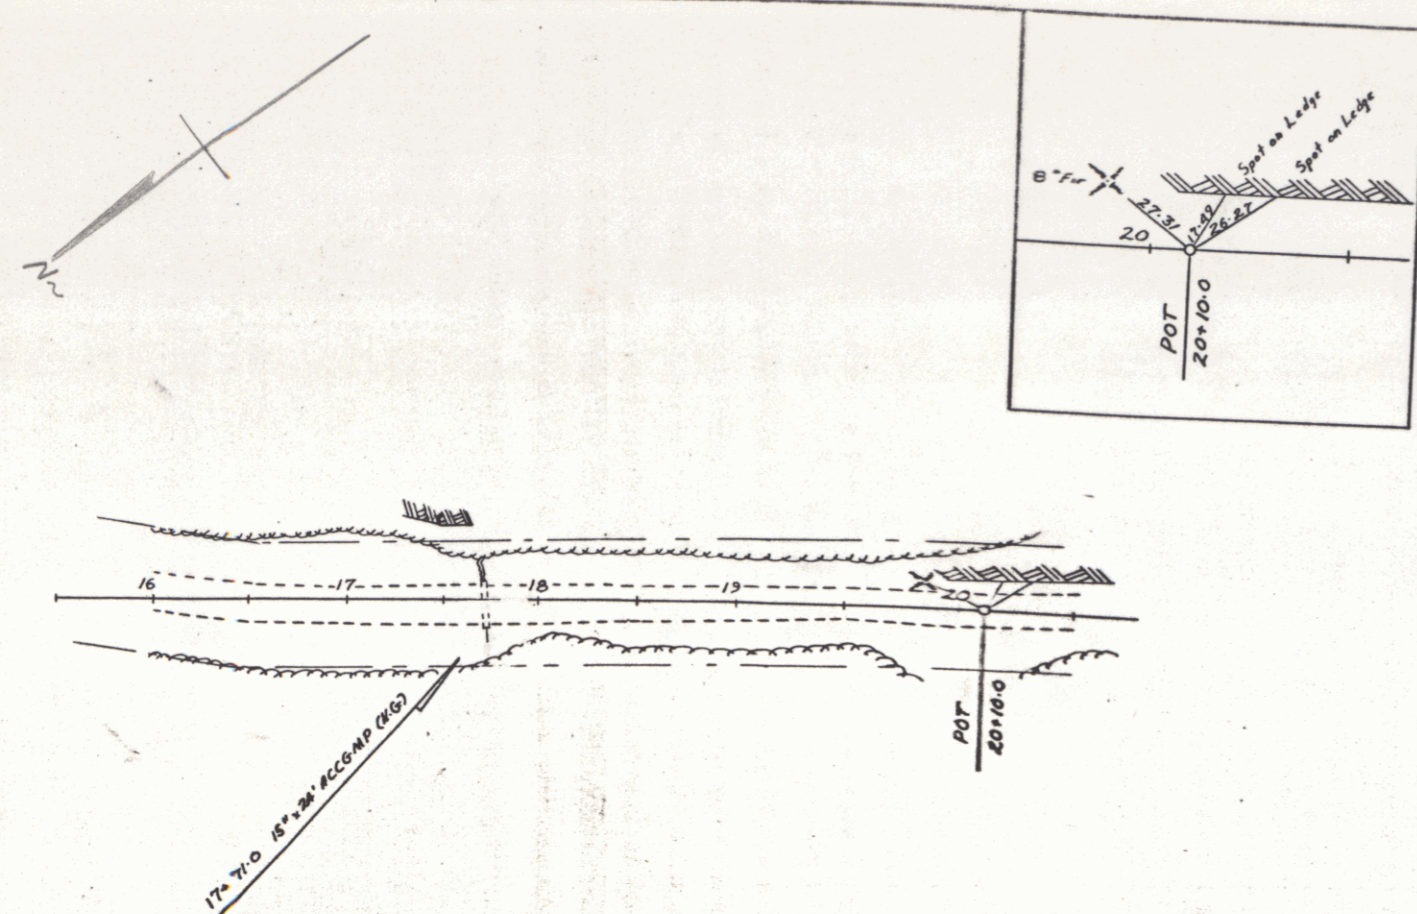
PROF. 1/2" = 1' HORIZ. 1" = 100'

PLATE 1-FLAN-PROFILE S. P. A. STANDARD
 ENGINE 2072018 CS, Chicago-Riv. Ind.

ELMORE
 Barnes Brook Relocation

SHEET 2

17