
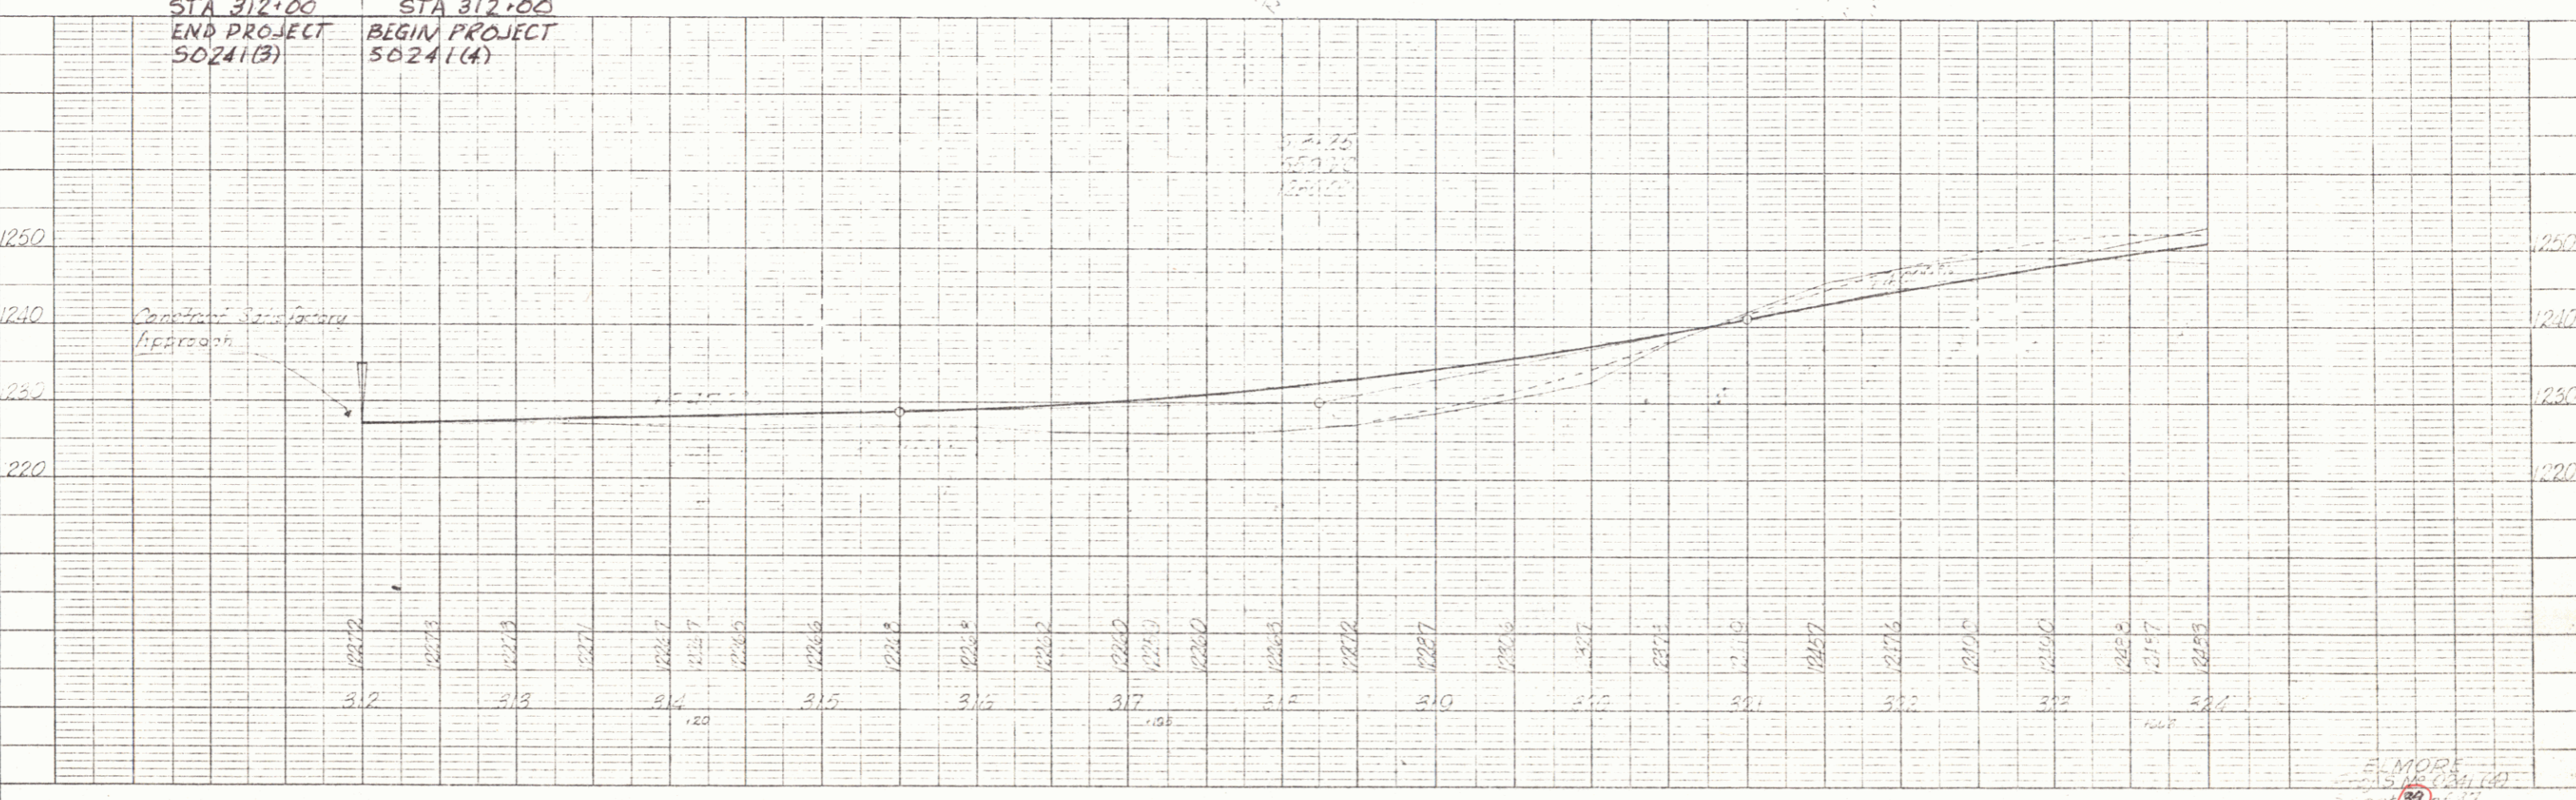


TWO CABLE GUARD RAIL
 1.5
 312+00 - 323+50
 312+00 - 323+50

DRILLING & BLASTING OF SOLID ROCK SUBGRADE
 320+50 - 323+50

DATE: 11/17/17
 DRAWN BY: [Signature]

PLAN
 PROJECT NO. 50241
 SHEET NO. 17 OF 17
 DATE: 11/17/17

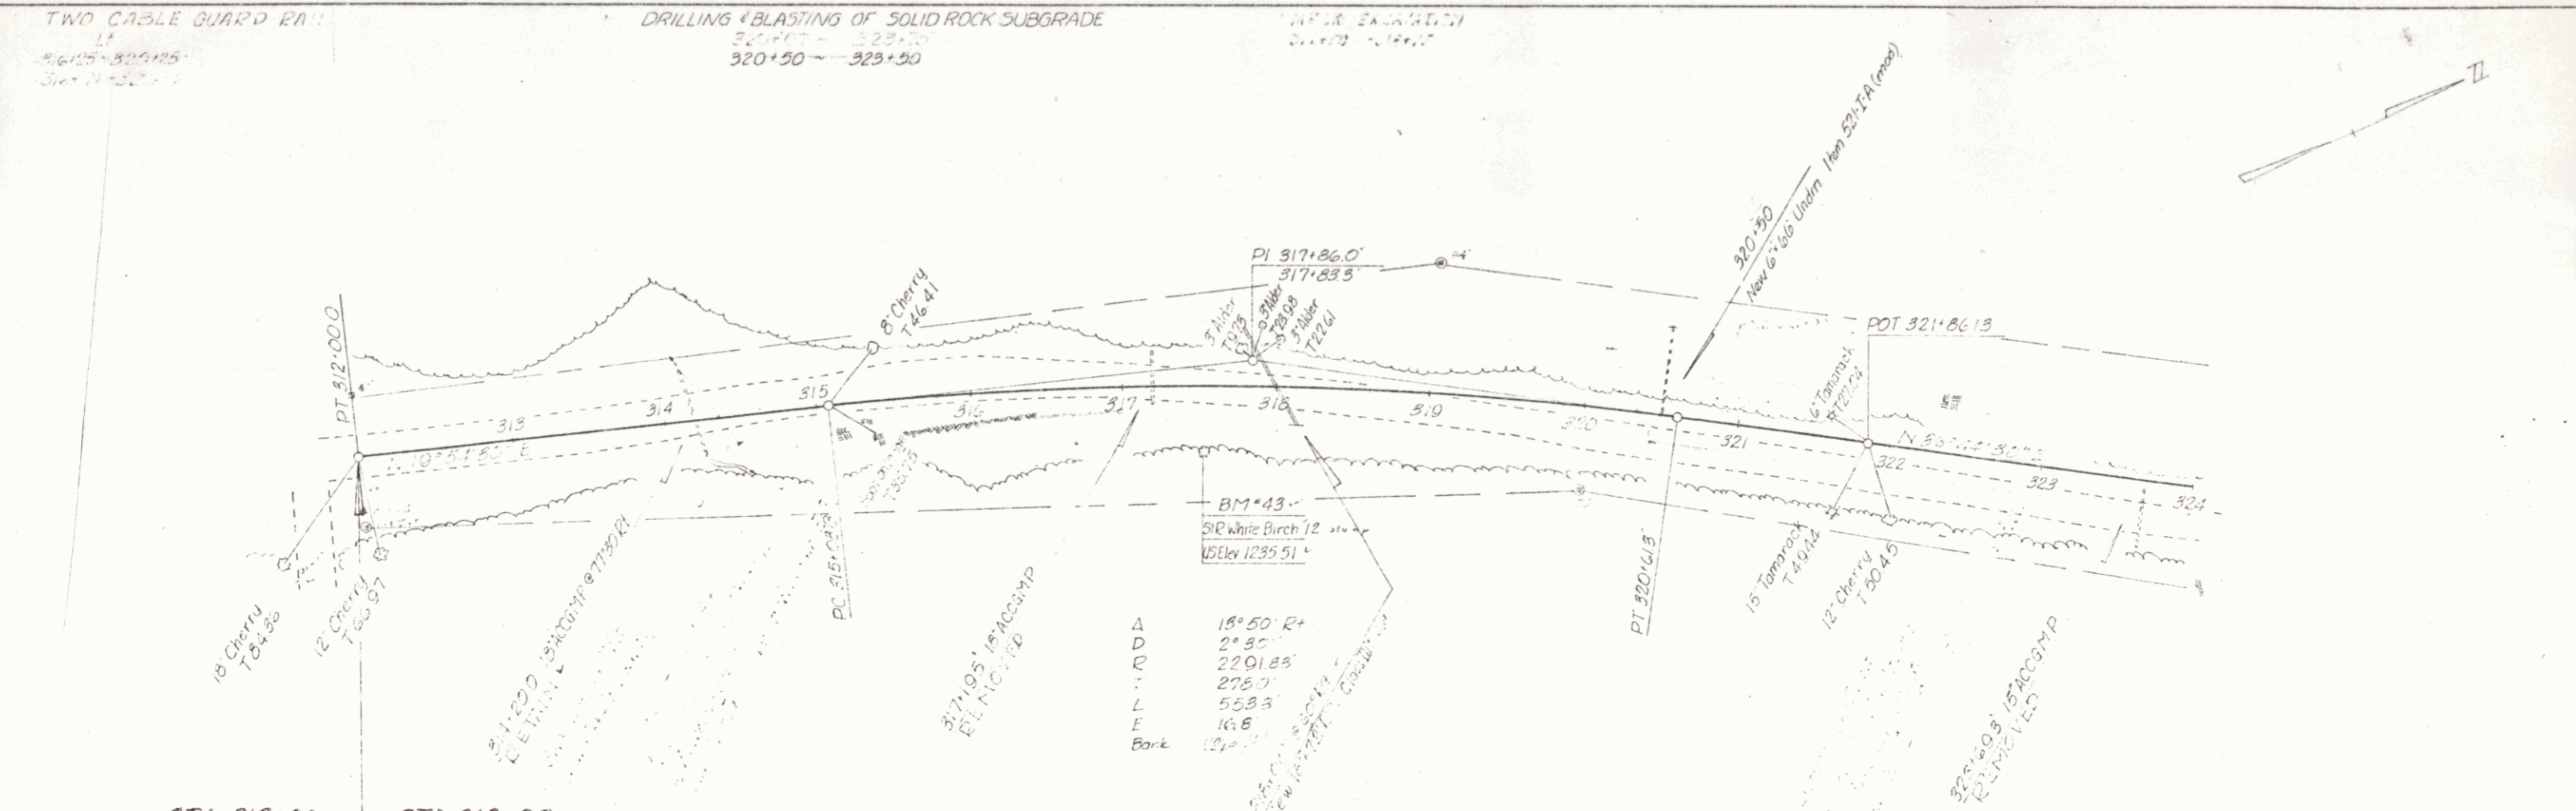

PROFILE
 PROJECT NO. 50241
 SHEET NO. 17 OF 17
 DATE: 11/17/17