


CONSTRUCT DRIVE TWO CABLE GUARD RAIL

Pt 325+00 - 331+96  
328+42 - 331+74


DRILLING & BLASTING OF SOLID ROCK SUBGRADE

331+50 - 336+00  
324+75 - 326+75  
331+25 - 335+75

PLAN  
DATE: 9/27/68  
BY: Smith  
CHECKED: Smith  
SCALE: 1/8" = 10' (HORIZ)  
1/4" = 10' (VERT)

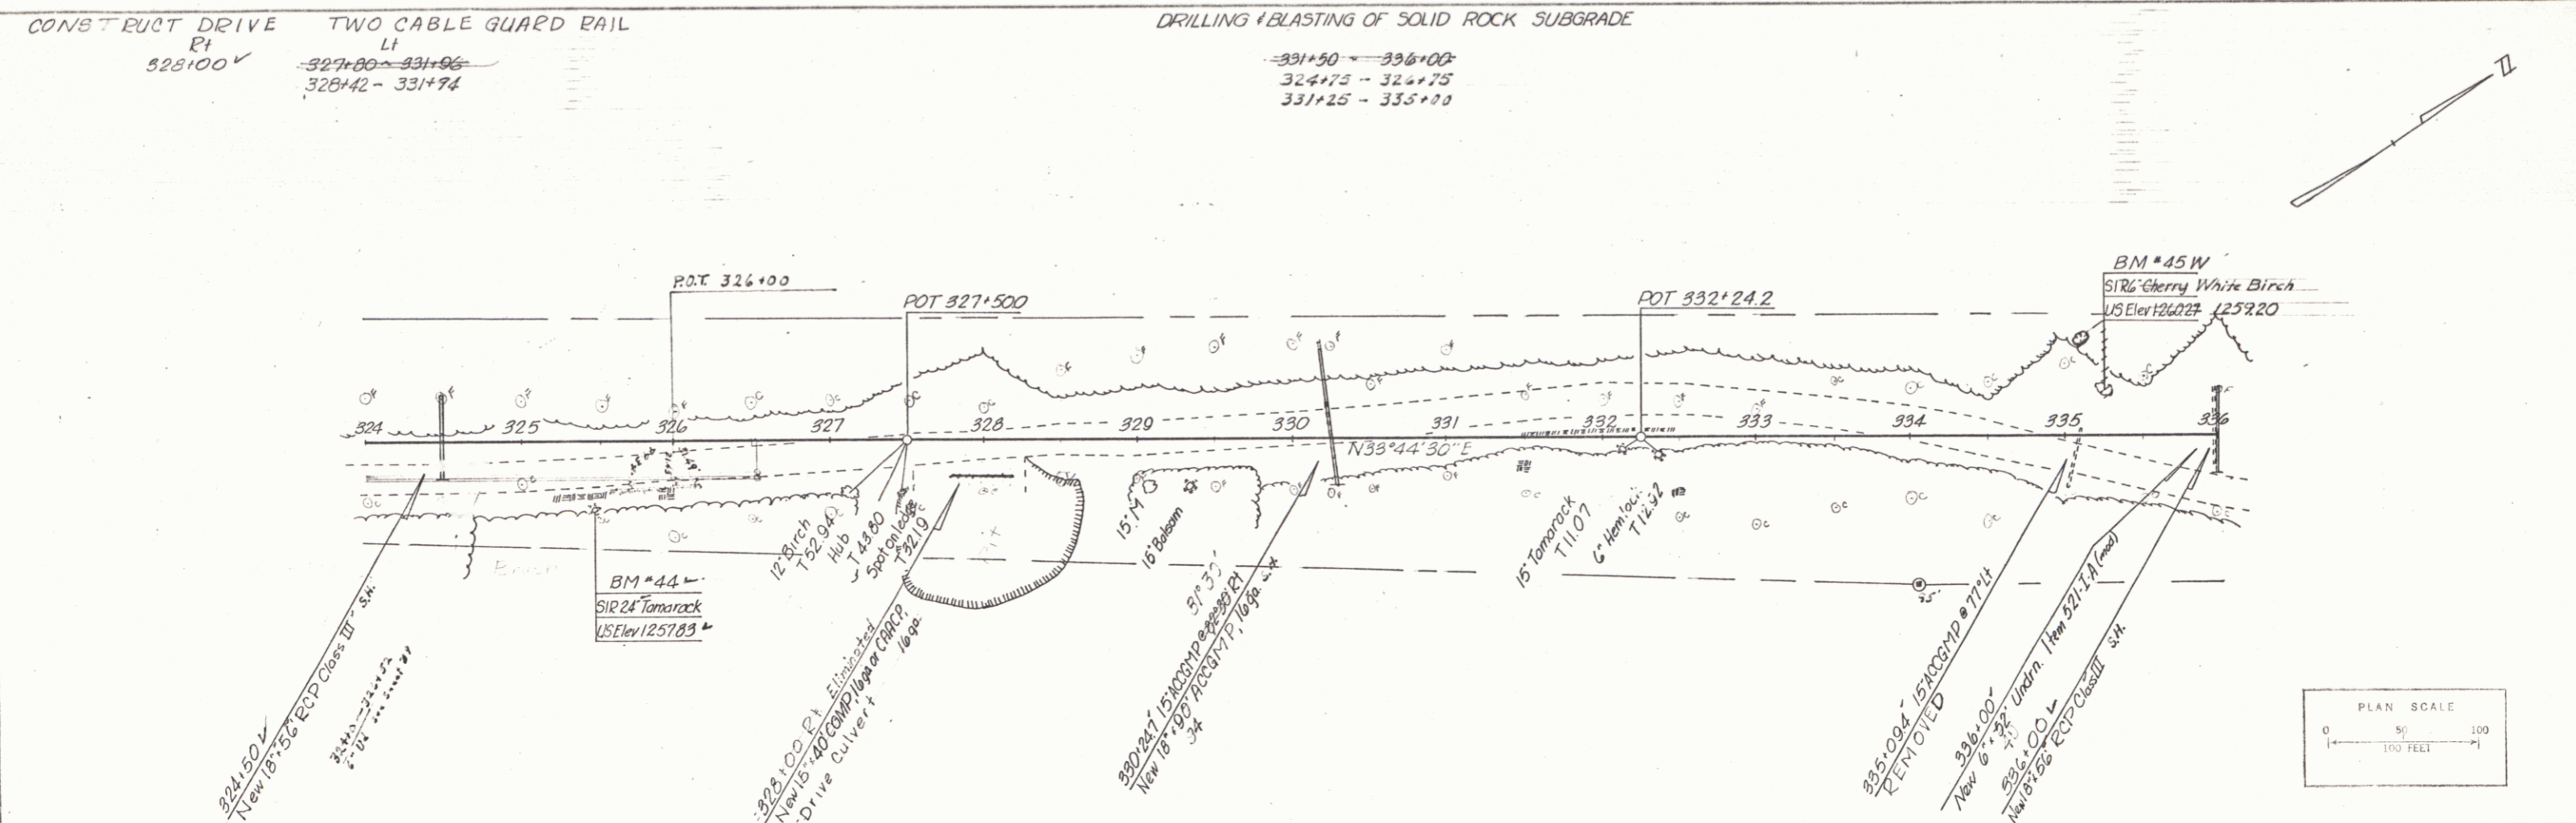

PROFILE  
DATE: 9/25/68  
BY: Smith  
CHECKED: Smith  
SCALE: 1/4" = 10' (HORIZ)  
1" = 10' (VERT)

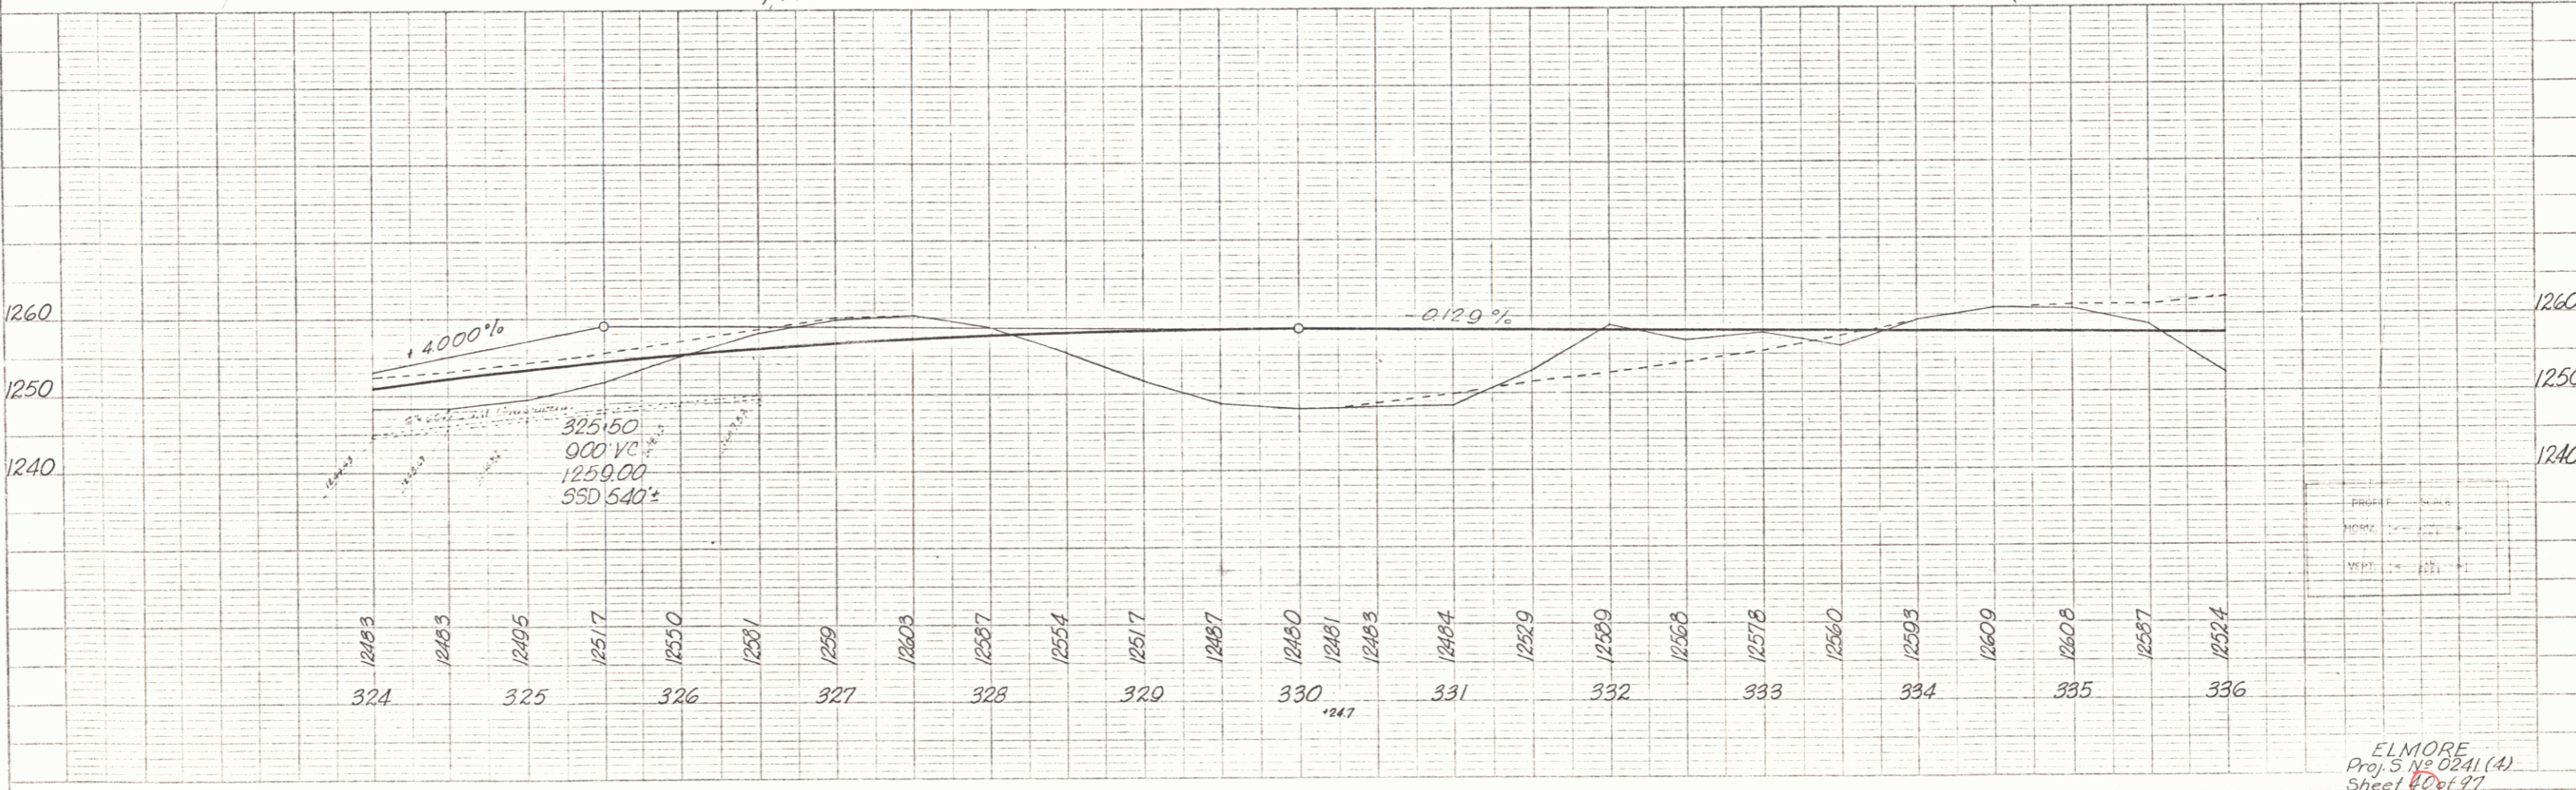

ELMORE  
Proj. S. No. 0241 (A)  
Sheet 4 of 97

PLATE 1 - PLAN PROFILE A.P.R. & R.E. STANDARD  
REVISIONS & FIELD NO. NOT SHOWN  
SHEET NO. 34 OF 97