
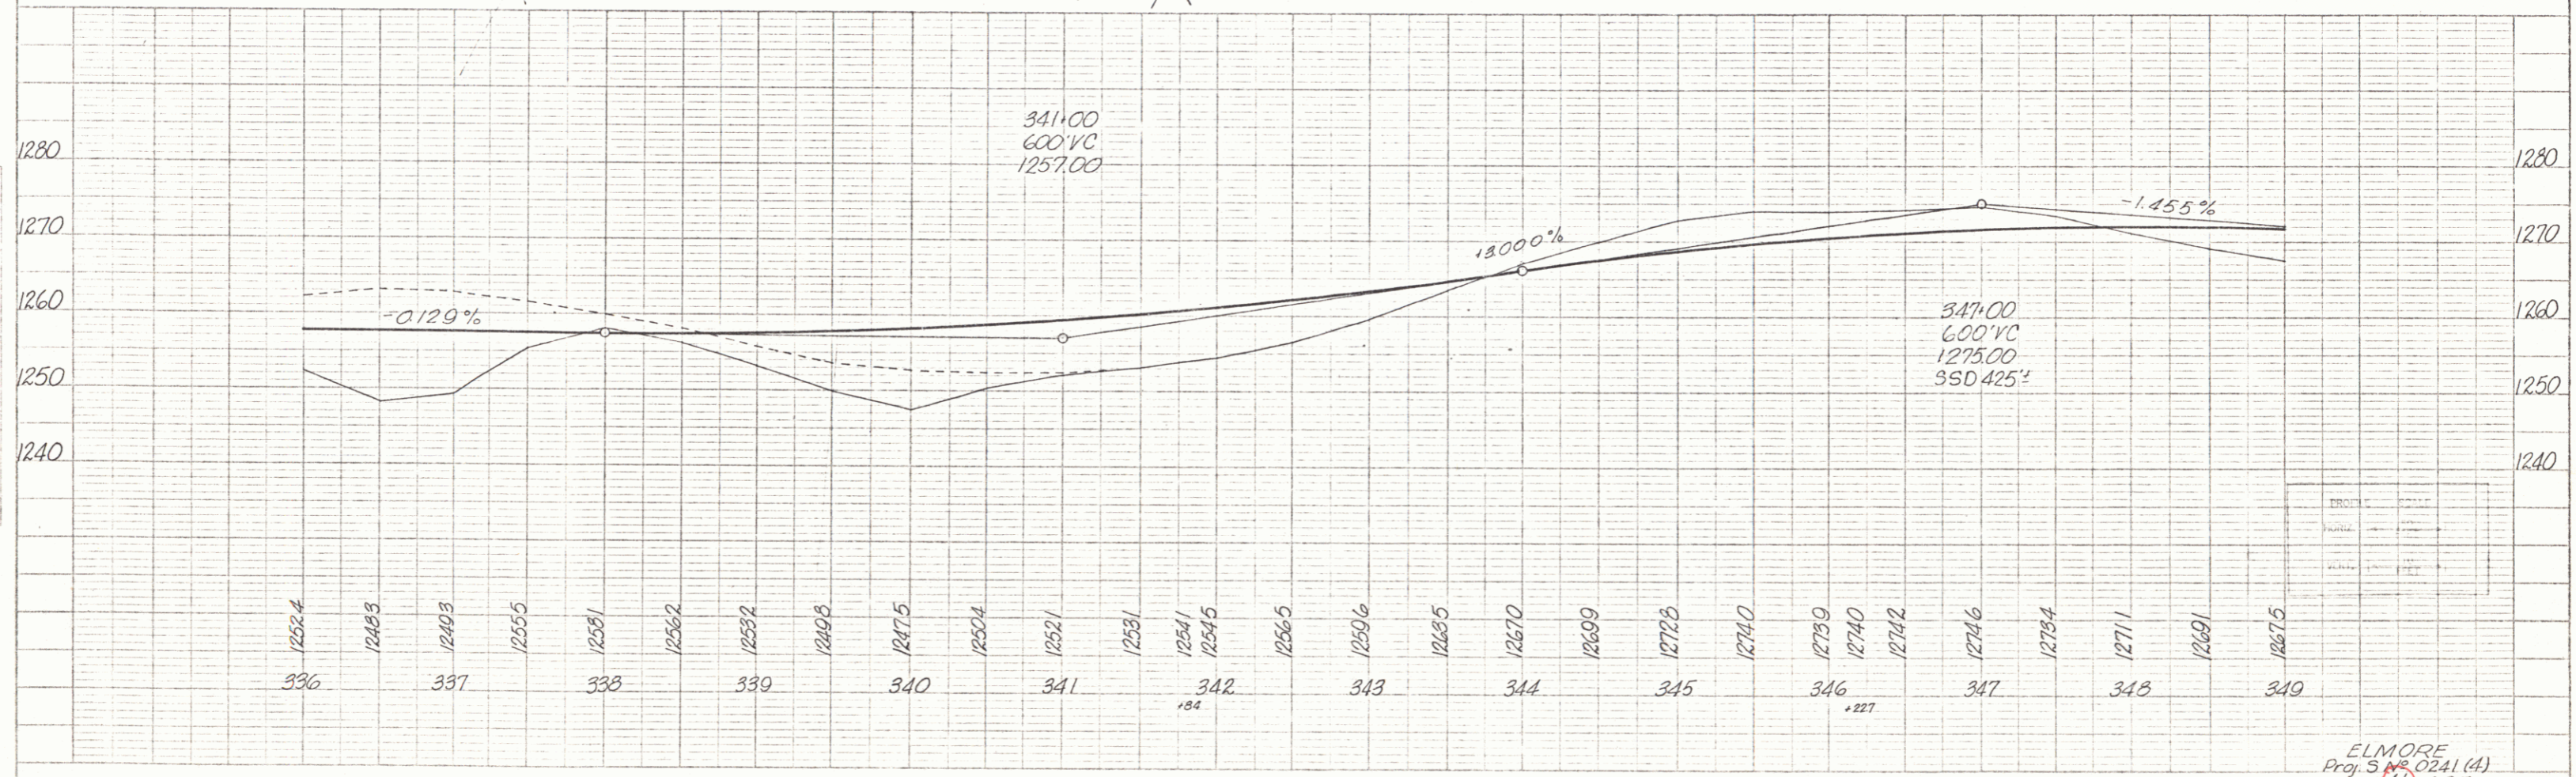


CONSTRUCT DRIVE LT 330+50
 TWO CABLE GUARD RAIL LT 336+00-339+86
 MUCK EXCAVATION 339+50-343+00
 WOOD GUIDE POSTS 347+84-348+40
 DRILLING & BLASTING OF SOLID ROCK SUBGRADE 337+25-338+75

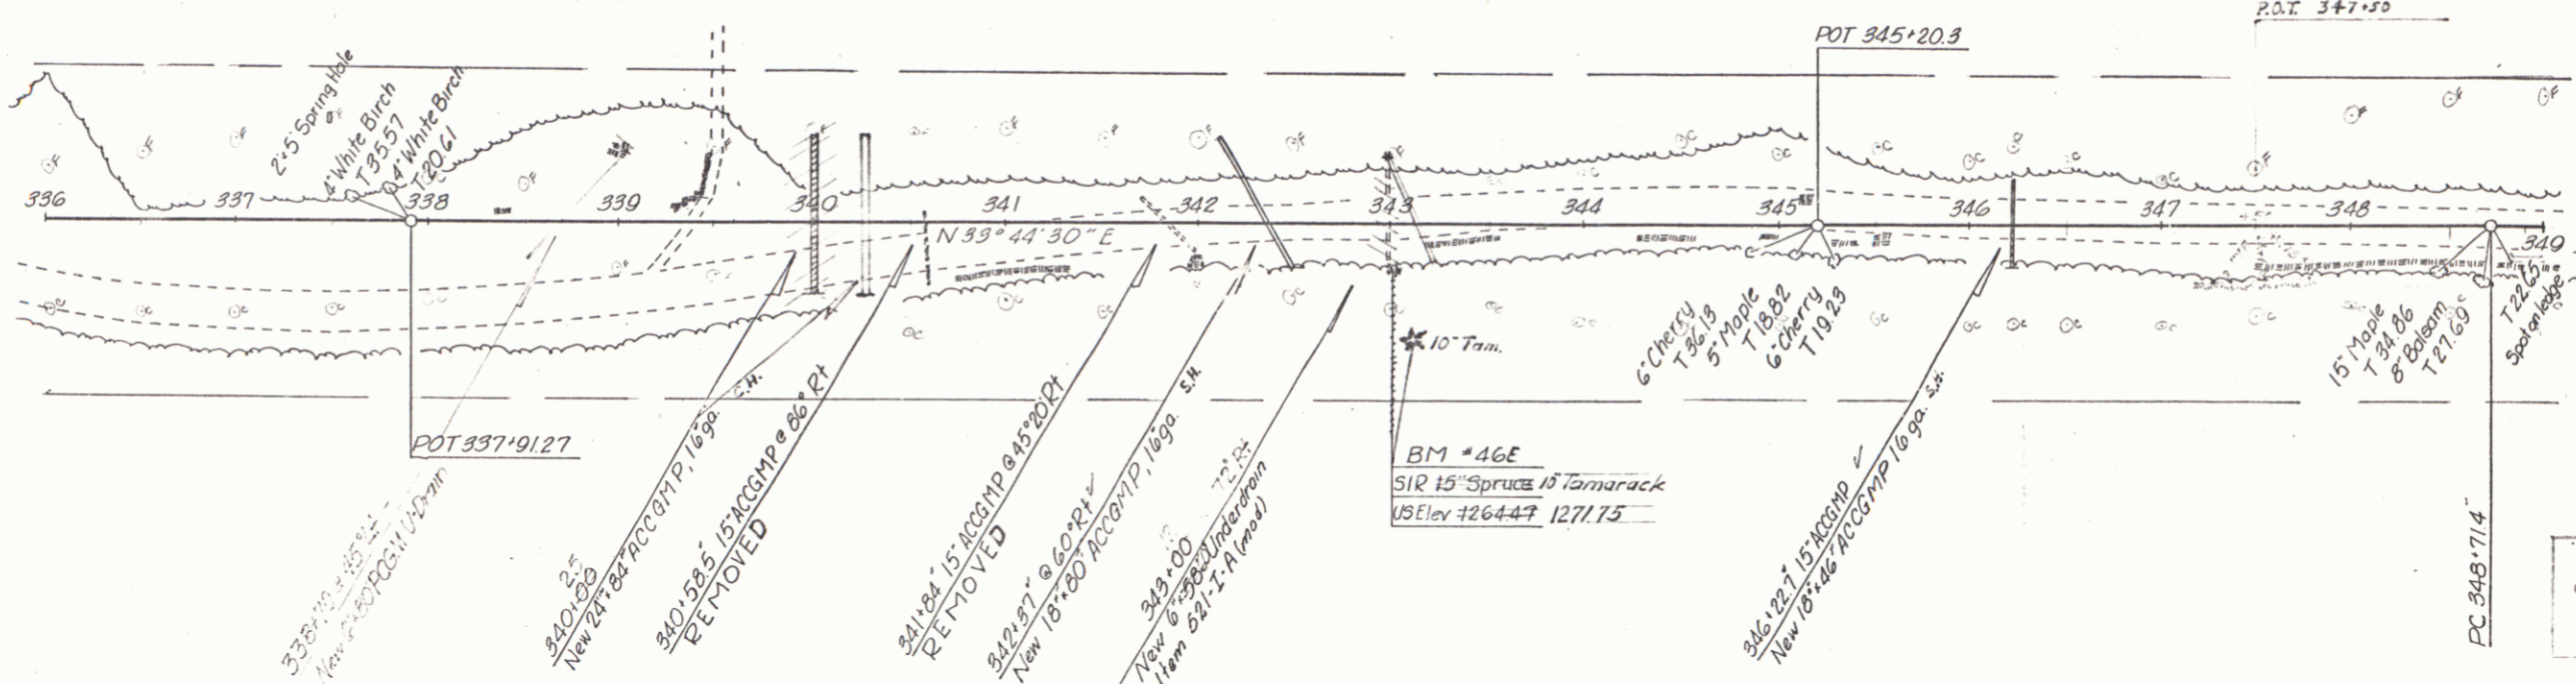

PLAN
 DATE: 11/23/12
 DRAWN BY: W. Smith
 CHECKED BY: J. Smith
 NO. 1
 TITLE: Traced

PROFILE
 DATE: 11/23/12
 DRAWN BY: W. Smith
 CHECKED BY: J. Smith
 NO. 1
 TITLE: Traced

PLATE 1 - PLAN & PROFILE OF ROAD SUBGRADE
 REVISIONS:
 1. 11/23/12

ELMORE
 Proj. 5 W. 0241 (A)
 Sheet 4 of 97