
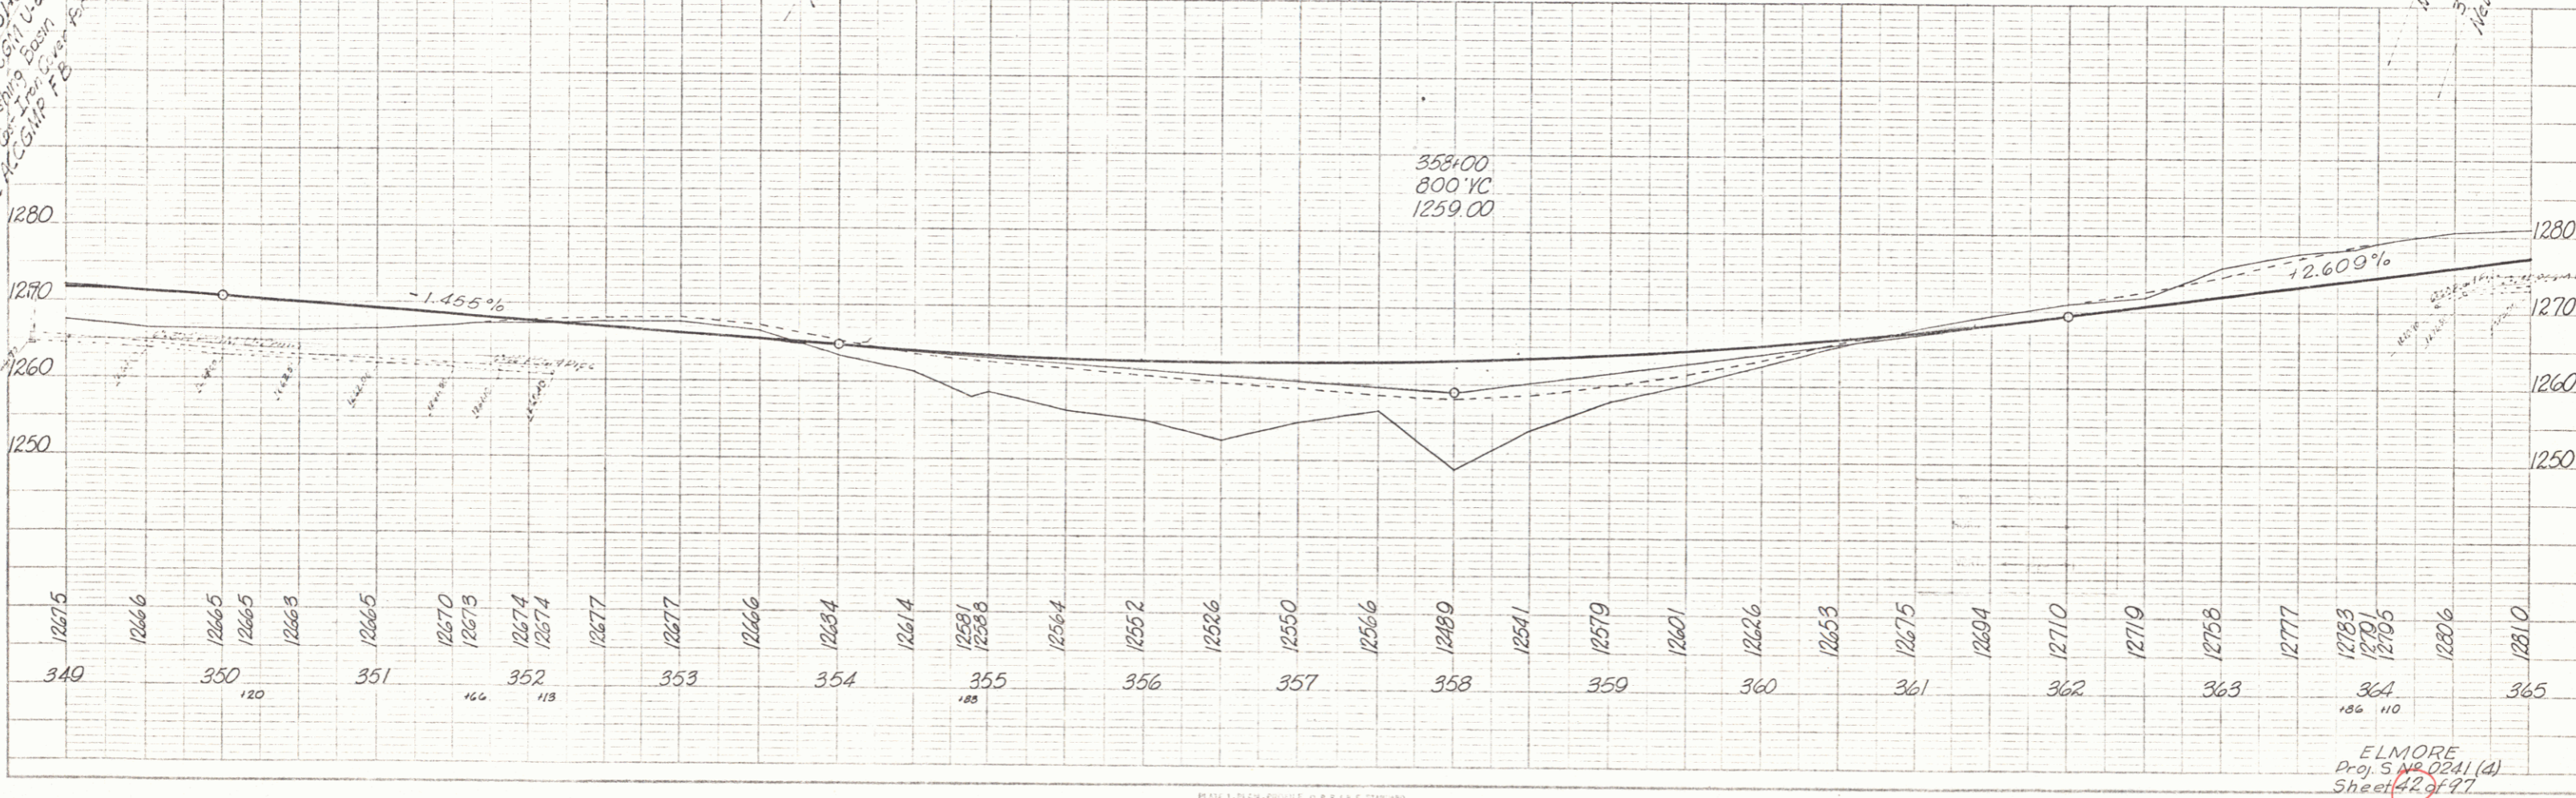


Δ
 D 11° 33' Pt V
 R 0' 45"
 T 7639.44'
 L 772.6'
 E 1540.0'
 S 83.96'
 REMOVE CROWN

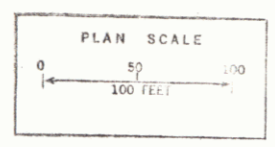

PLAN

DATE	11/13
BY	W. Smith
CHECKED	N. Smith
NO.	468

PROFILE

DATE	11/13
BY	W. Smith
CHECKED	N. Smith
NO.	468

ELMORE
 Proj. 5 No. 0241 (d)
 Sheet 42 of 77