


PLAN
 W. Smith - Attn: 9/10/93
 W. Smith - Attn: 9/10/93

PROFILE
 W. Smith
 9/10/93

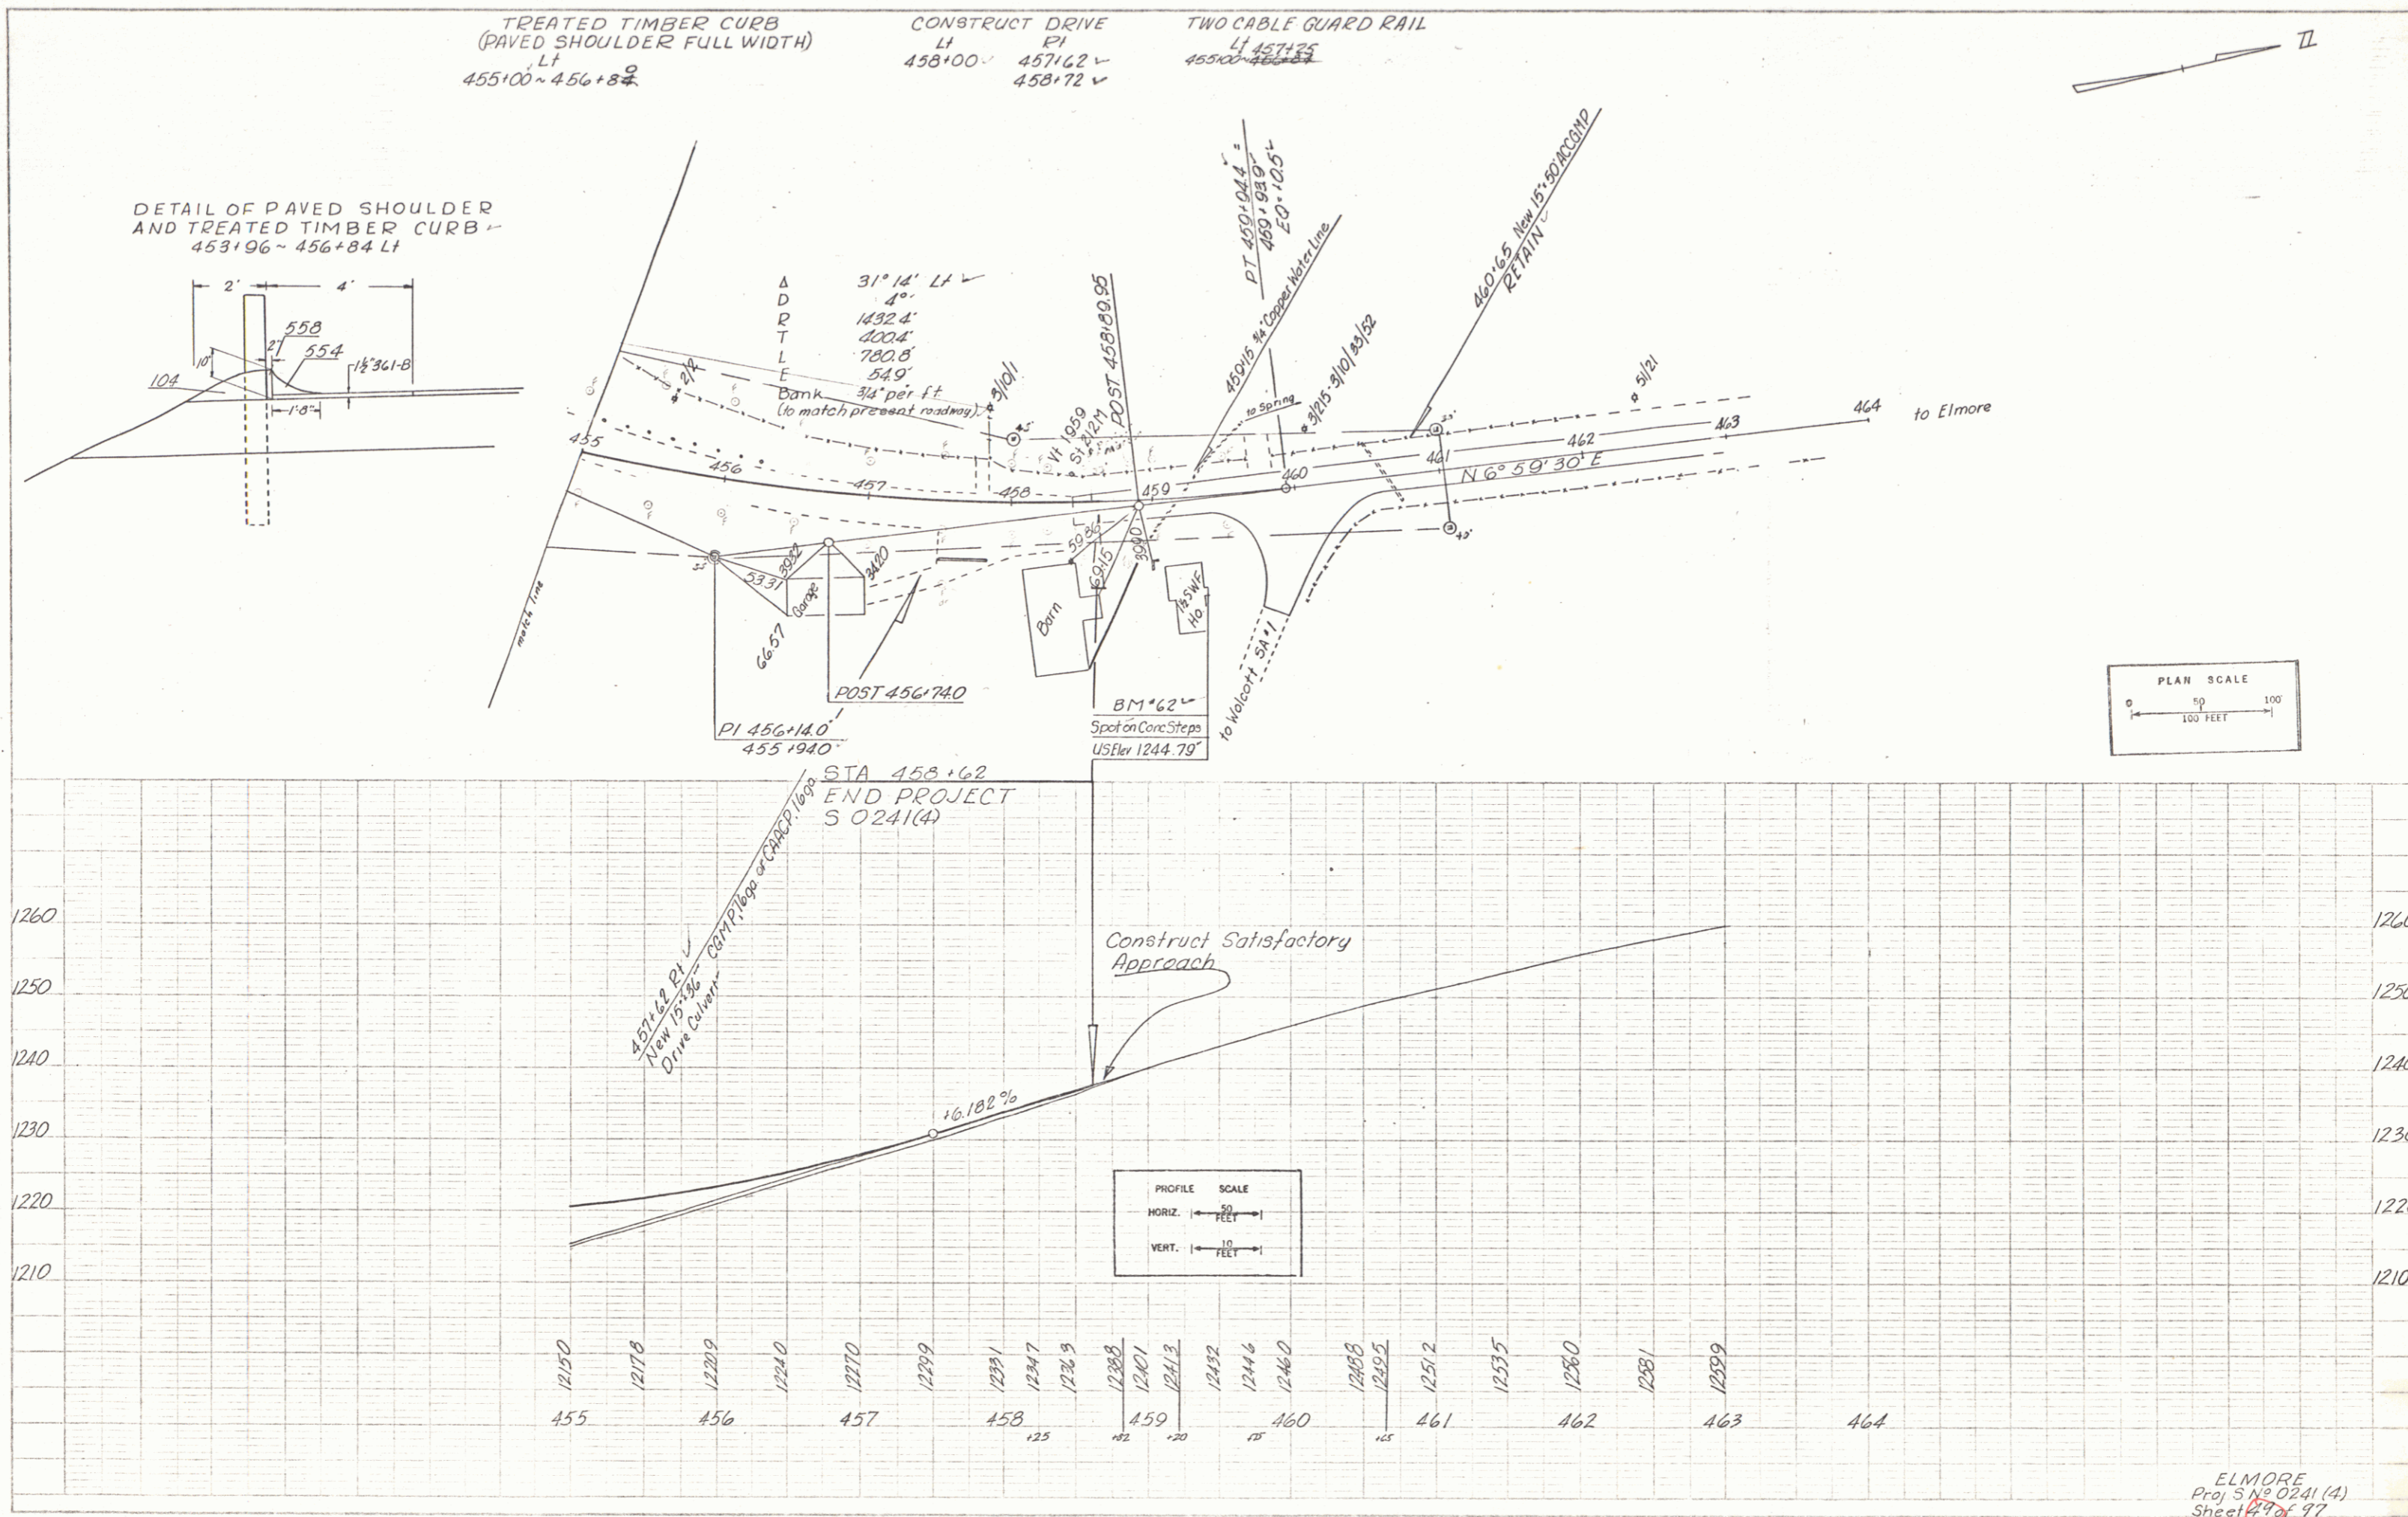

ELMORE
 Proj. No. 0241 (4)
 Sheet 29 of 97

13