
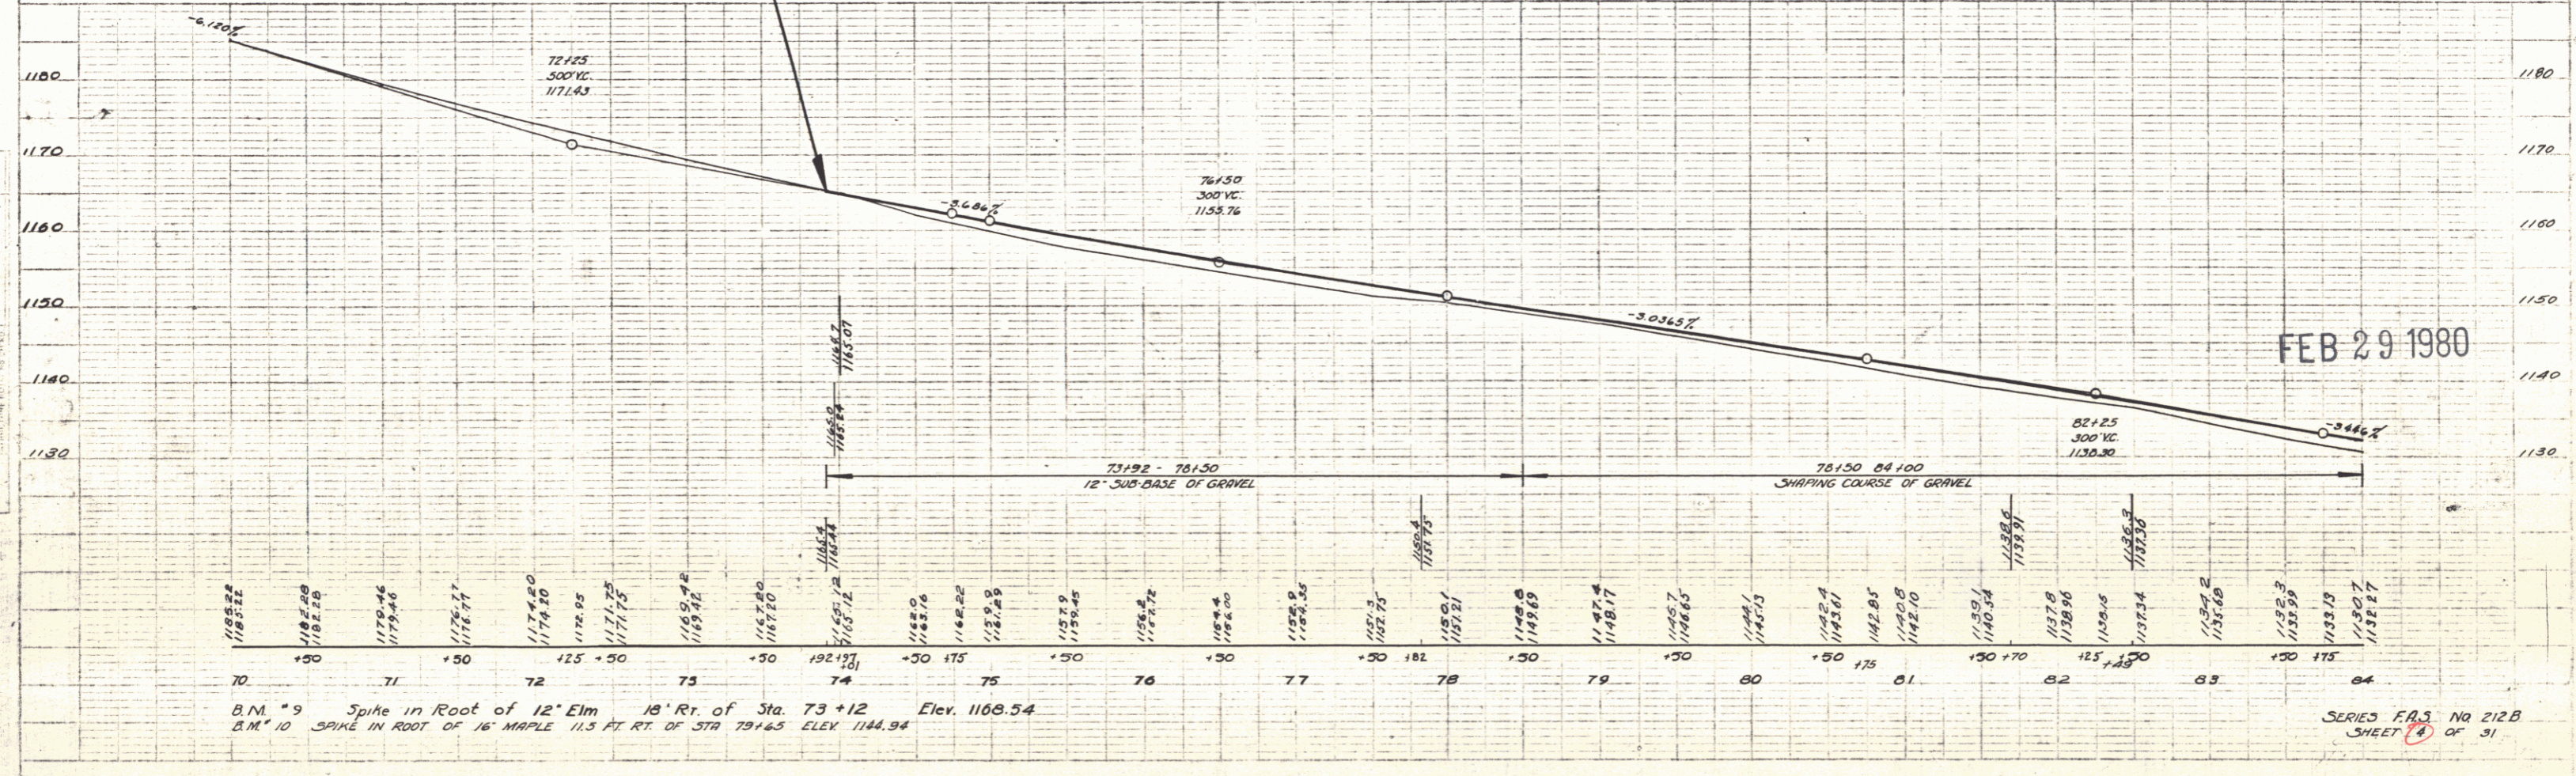


FED. ROAD DIST. NO.	STATE	F.A.S. PROJ. NO.	FISCAL YEAR	SHEET NO.	TOTAL SHEETS
2	Vt.	212B	1978	4	51

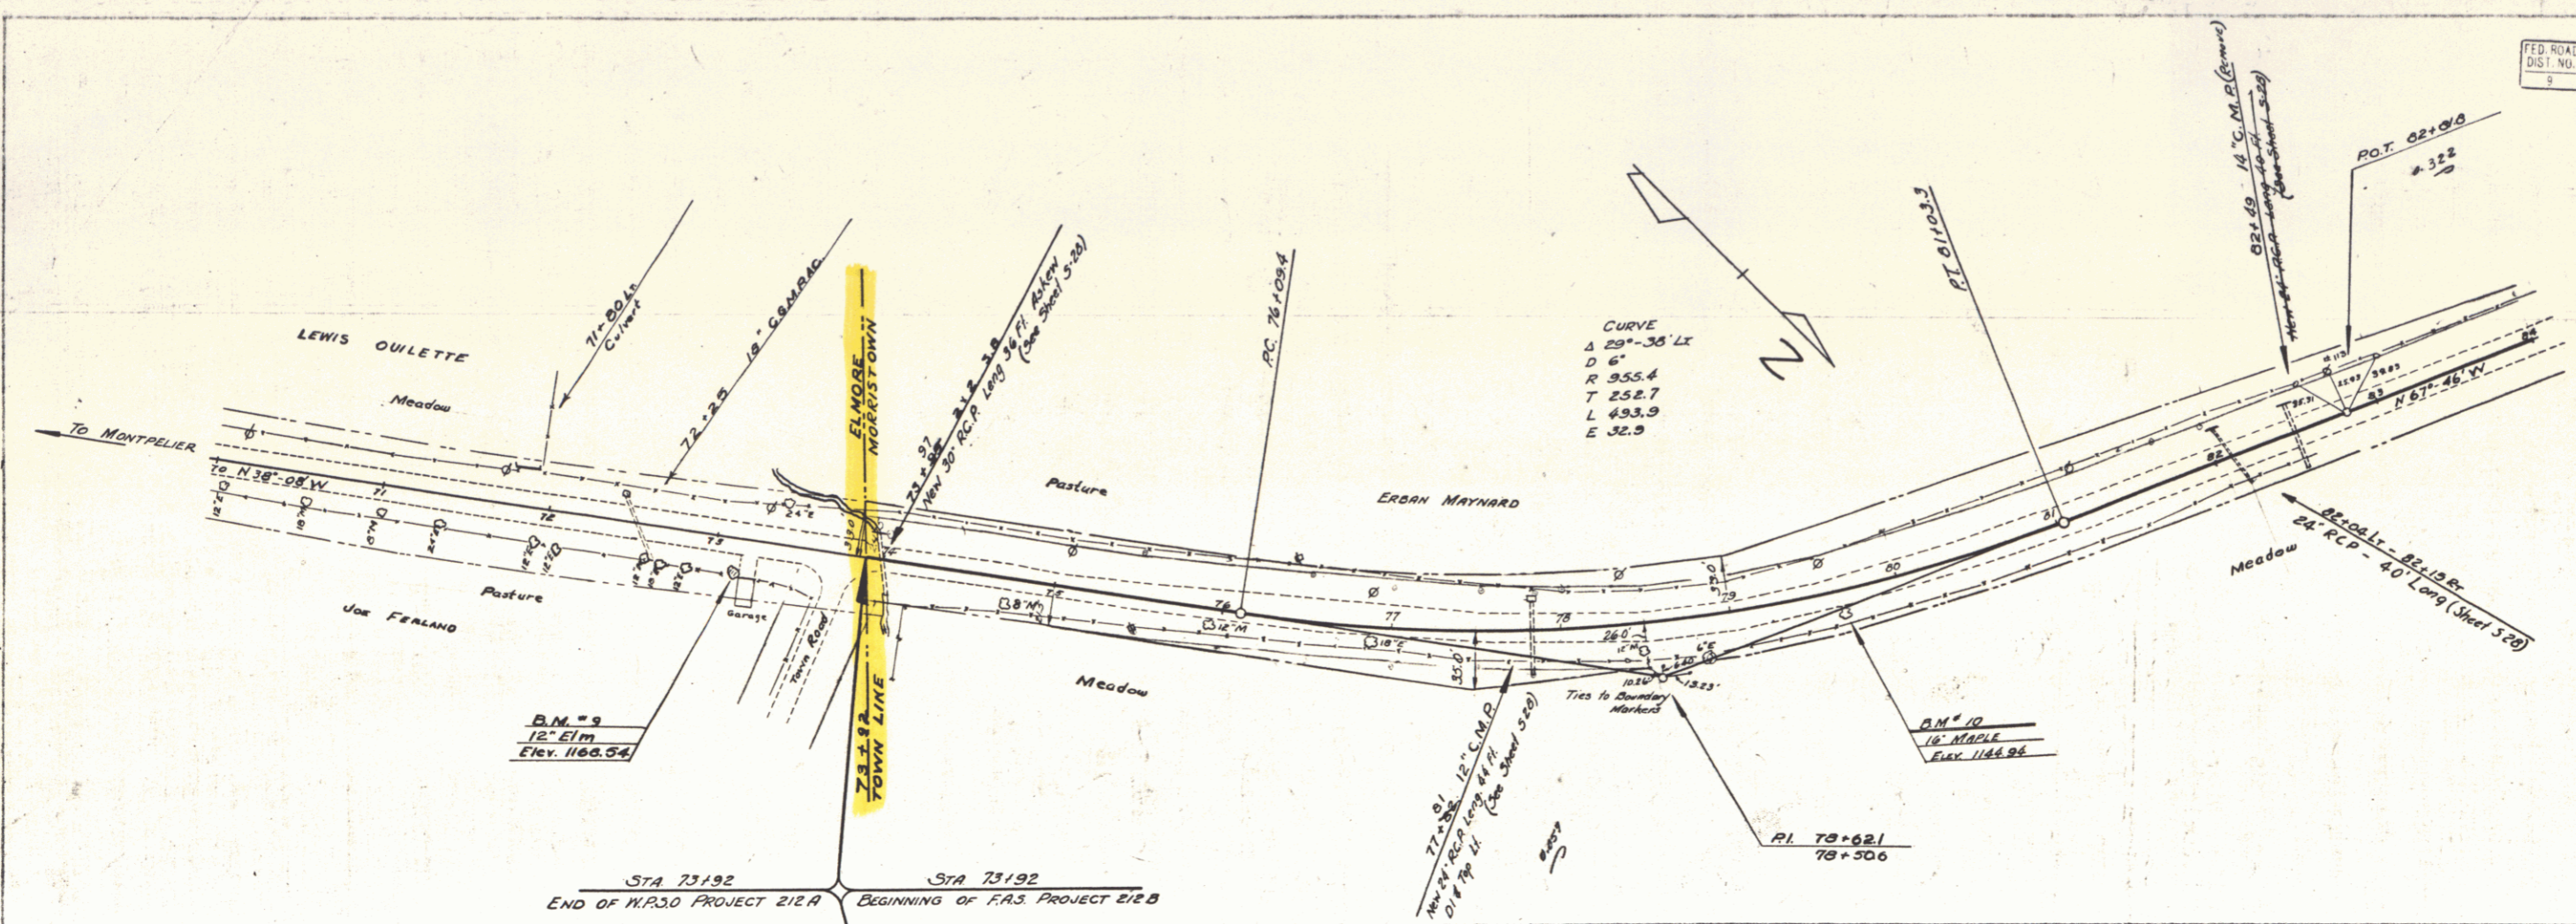

PLAN  
 PAID  
 NOTE BOOK  
 7-37

MAYNARD  
 7-37

FEB 29 1980

B.M. #9 Spike in Root of 12" Elm 18' Rt. of Sta. 73+12 Elev. 1166.54  
 B.M. #10 SPIKE IN ROOT OF 16" MAPLE 11.5 FT. RT. OF STA 79+65 ELEV. 1144.94

SERIES F.A.S. No 212B  
 SHEET 4 OF 51