
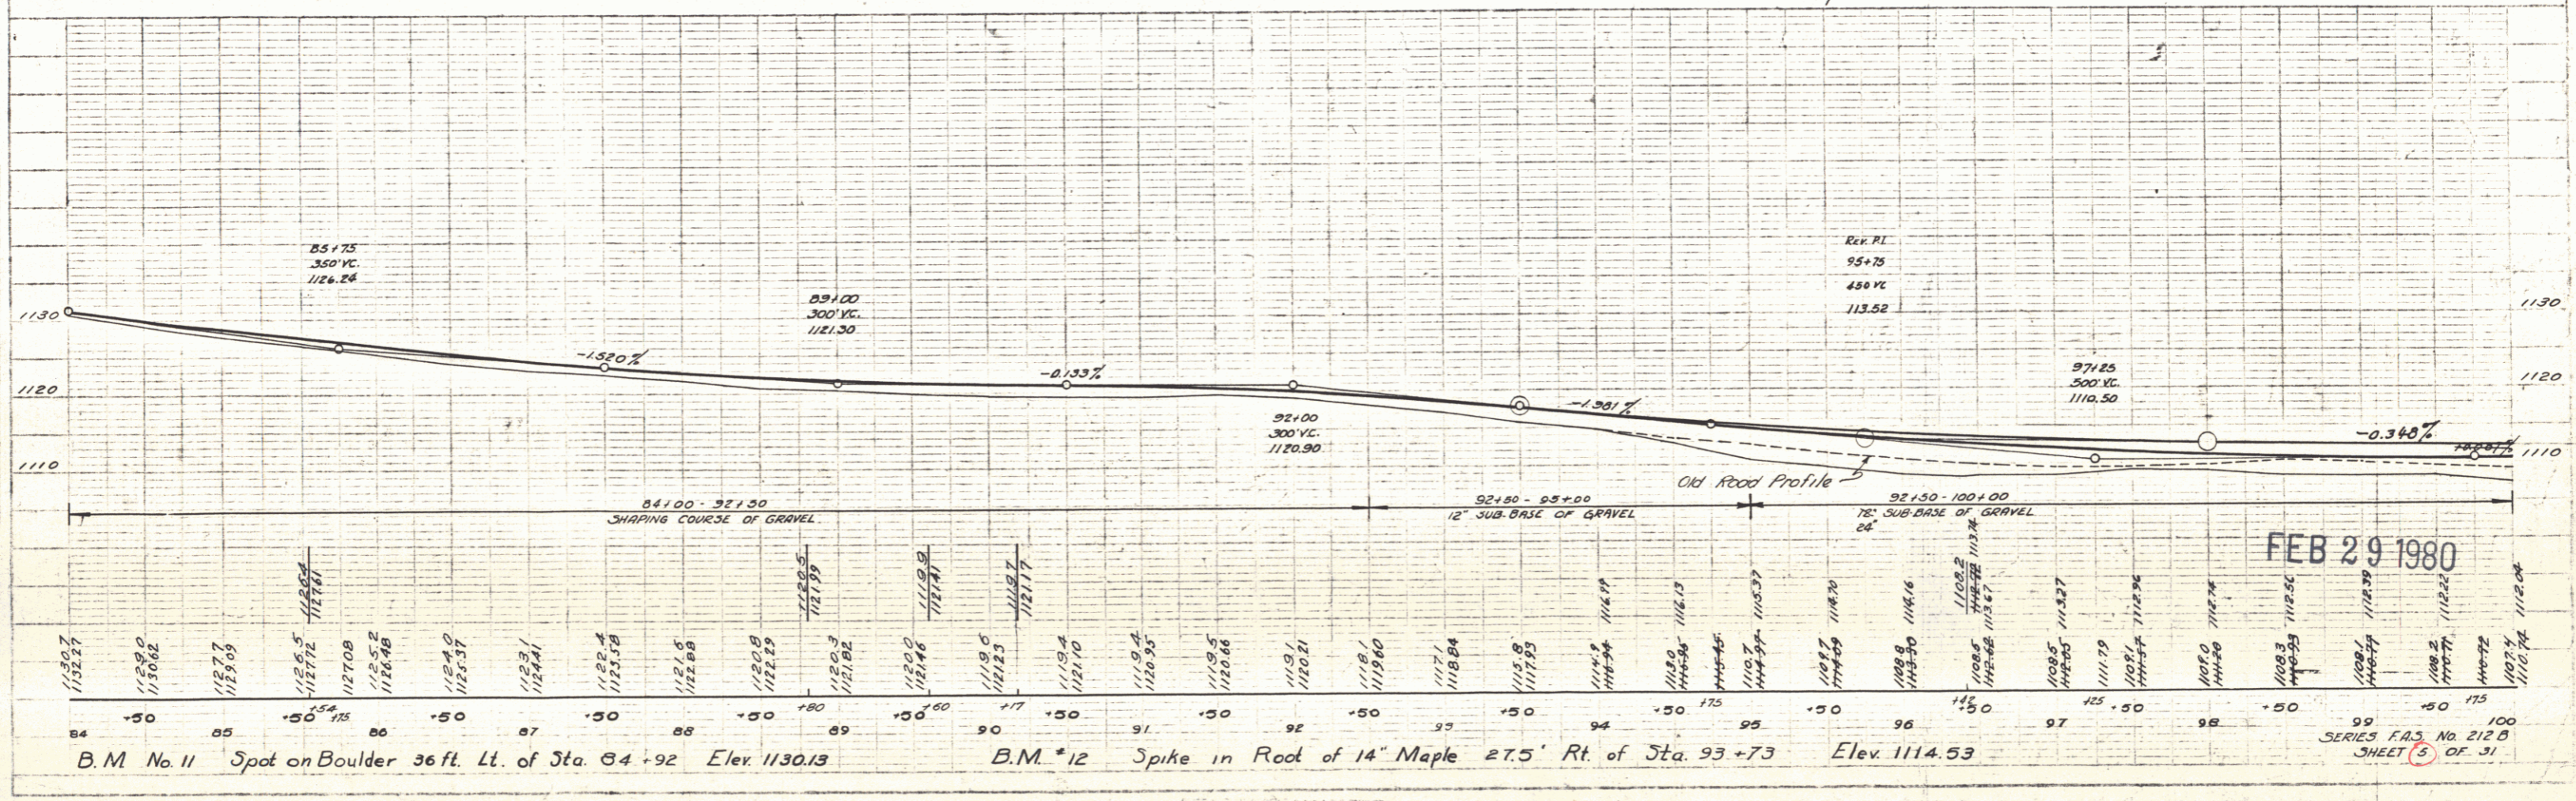


FED. ROAD DIST. NO.	STATE	F.A.S. PROJ. NO.	FISCAL YEAR	SHEET NO.	TOTAL SHEETS
212 B	VT	212 B	1958	5	31

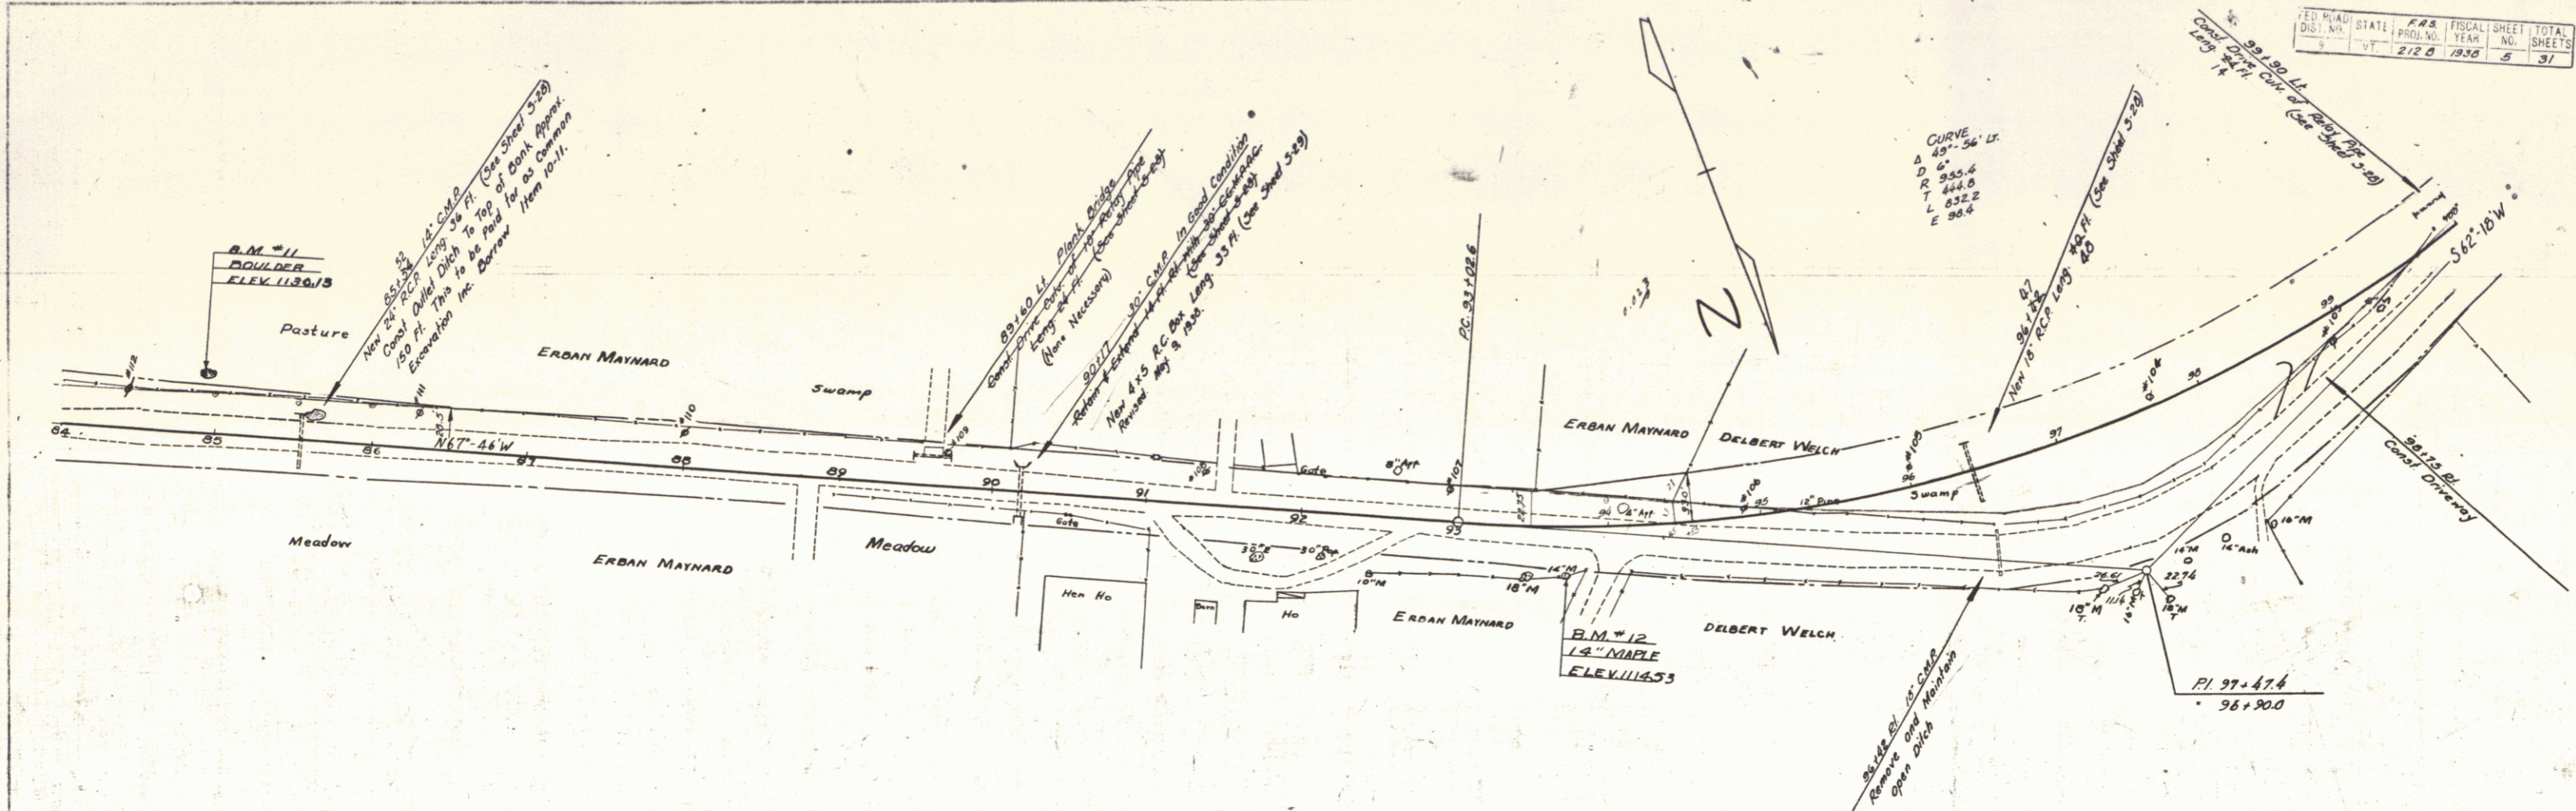

FILED
 BARRETT
 NELSON
 7-57
 TRACED
 7-57

FILED
 HARRISON
 7-57
 1120
 1110

FEB 29 1980

B.M. No. 11 Spot on Boulder 36 ft. Lt. of Sta. 84+92 Elev. 1130.13
 B.M. #12 Spike in Rod of 14" Maple 27.5' Rt. of Sta. 93+73 Elev. 1114.53

SERIES F.A.S. No. 212 B
 SHEET 5 OF 31