
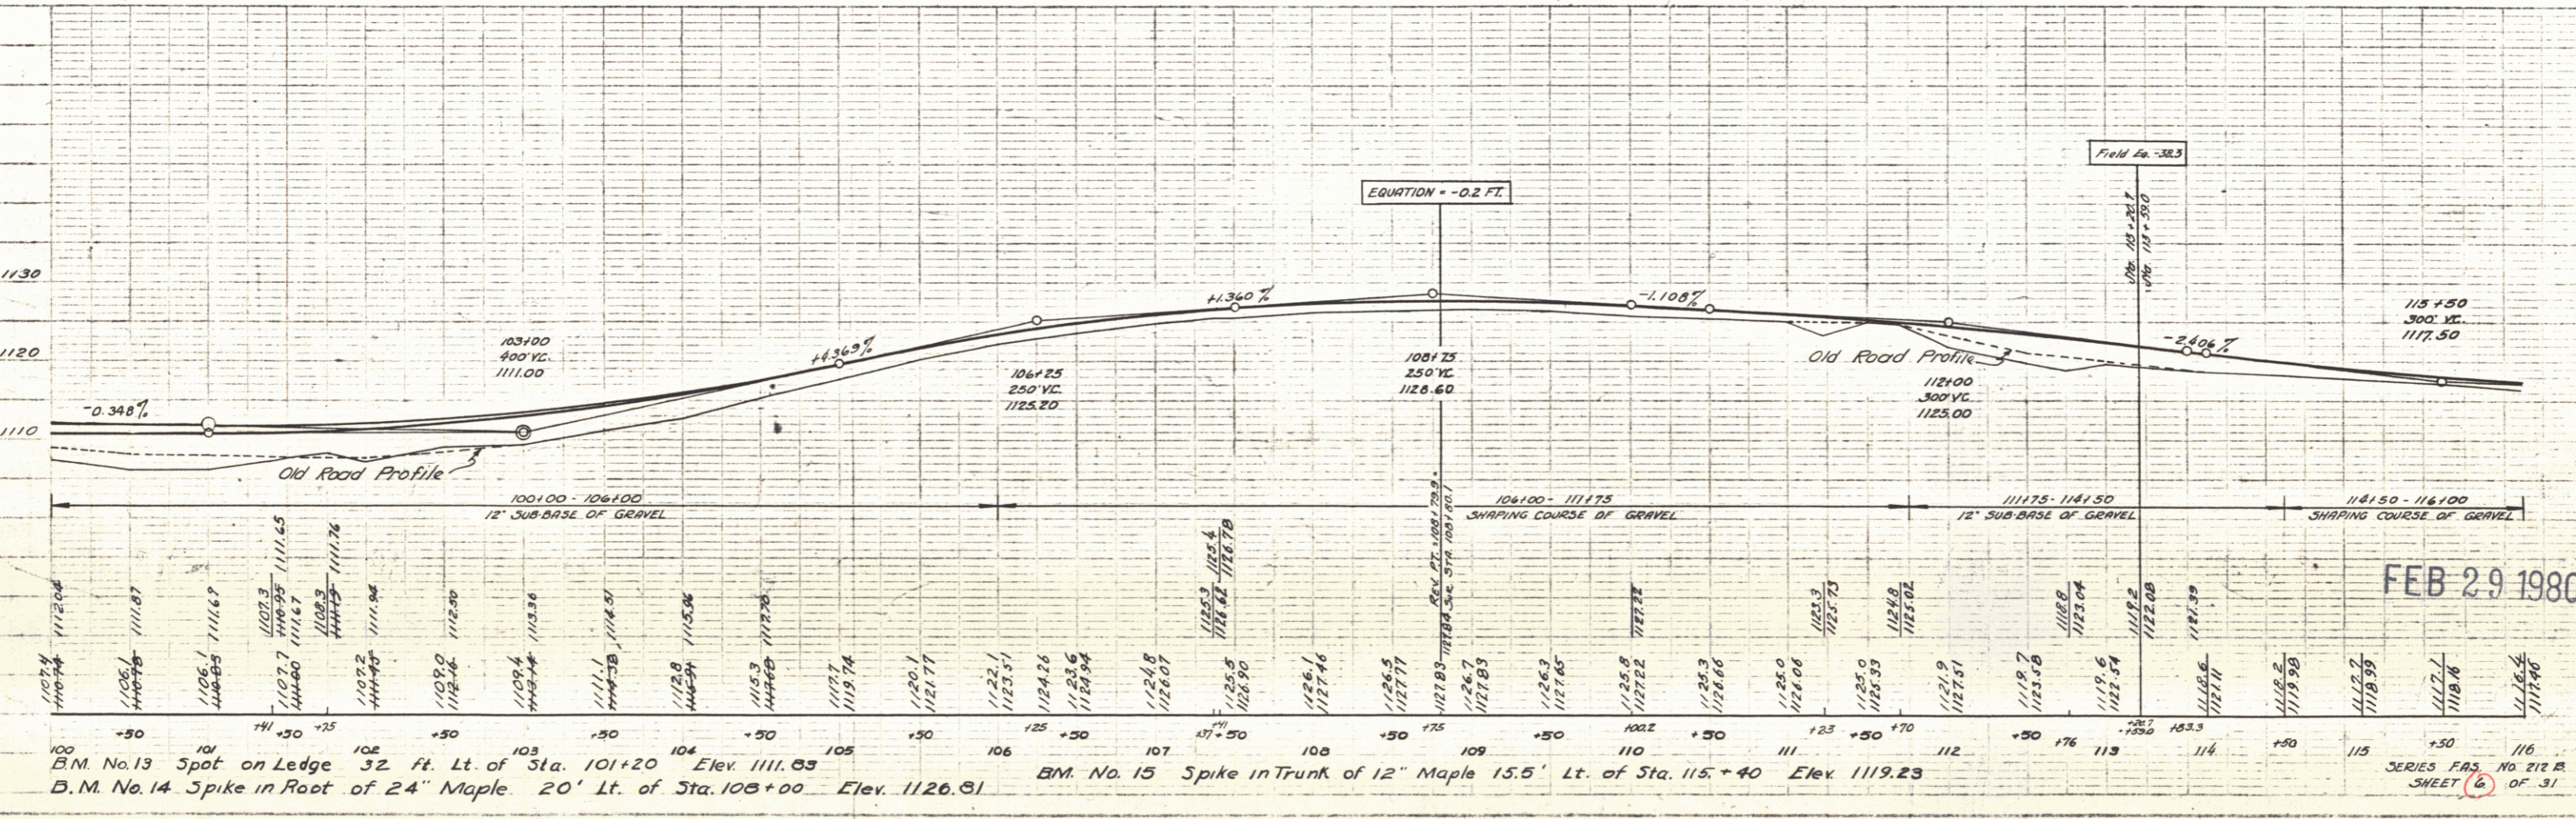


BARRETT NELSON
7-37
TRACED

BARRETT NELSON
7-37

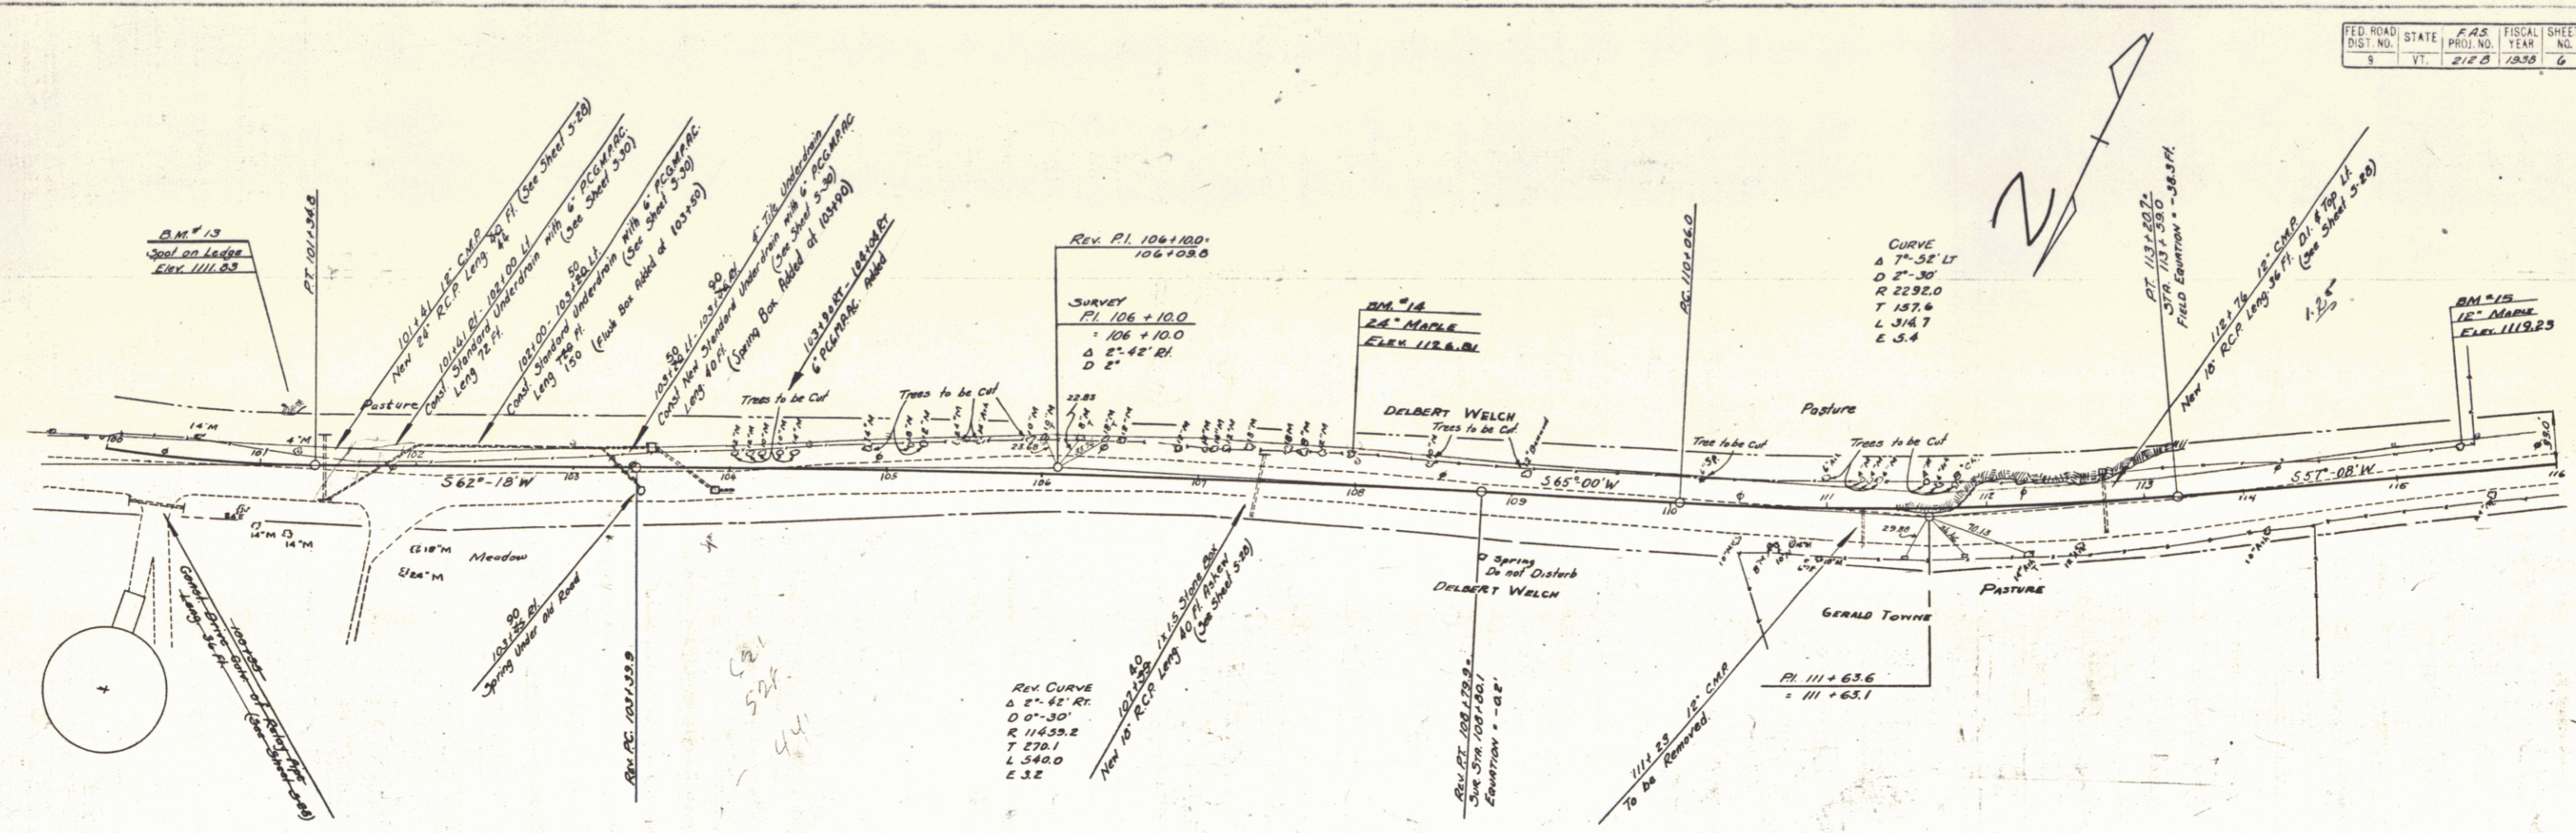

B.M. No. 13 Spot on Ledge 32 ft. Lt. of Sta. 101+20 Elev. 1111.83
 B.M. No. 14 Spike in Root of 24" Maple 20' Lt. of Sta. 108+00 Elev. 1126.81
 B.M. No. 15 Spike in Trunk of 12" Maple 15.5' Lt. of Sta. 115+40 Elev. 1119.23

FEB 29 1980

SERIES PAS NO 212 R
 SHEET 6 OF 31