
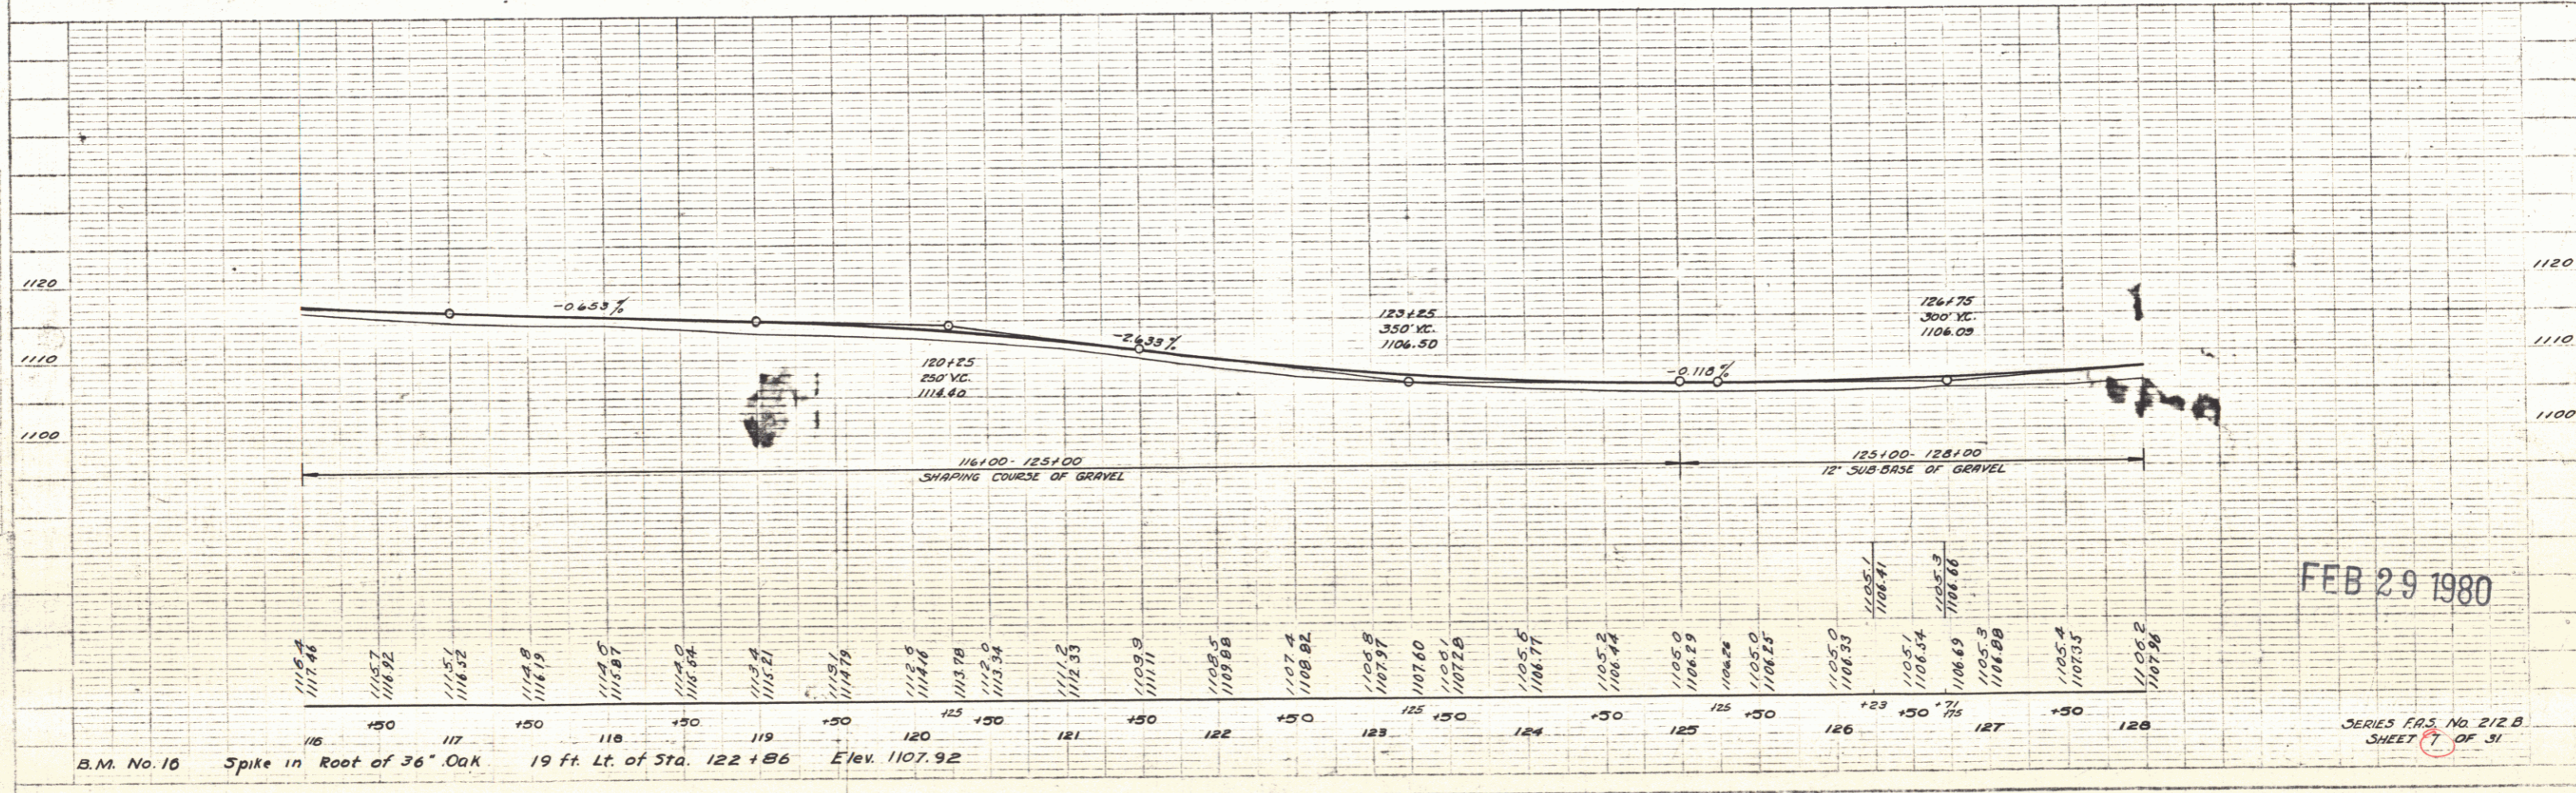


GARRETT NELSON  
 TRAKER, D.  
 7-37

MARON  
 7-37

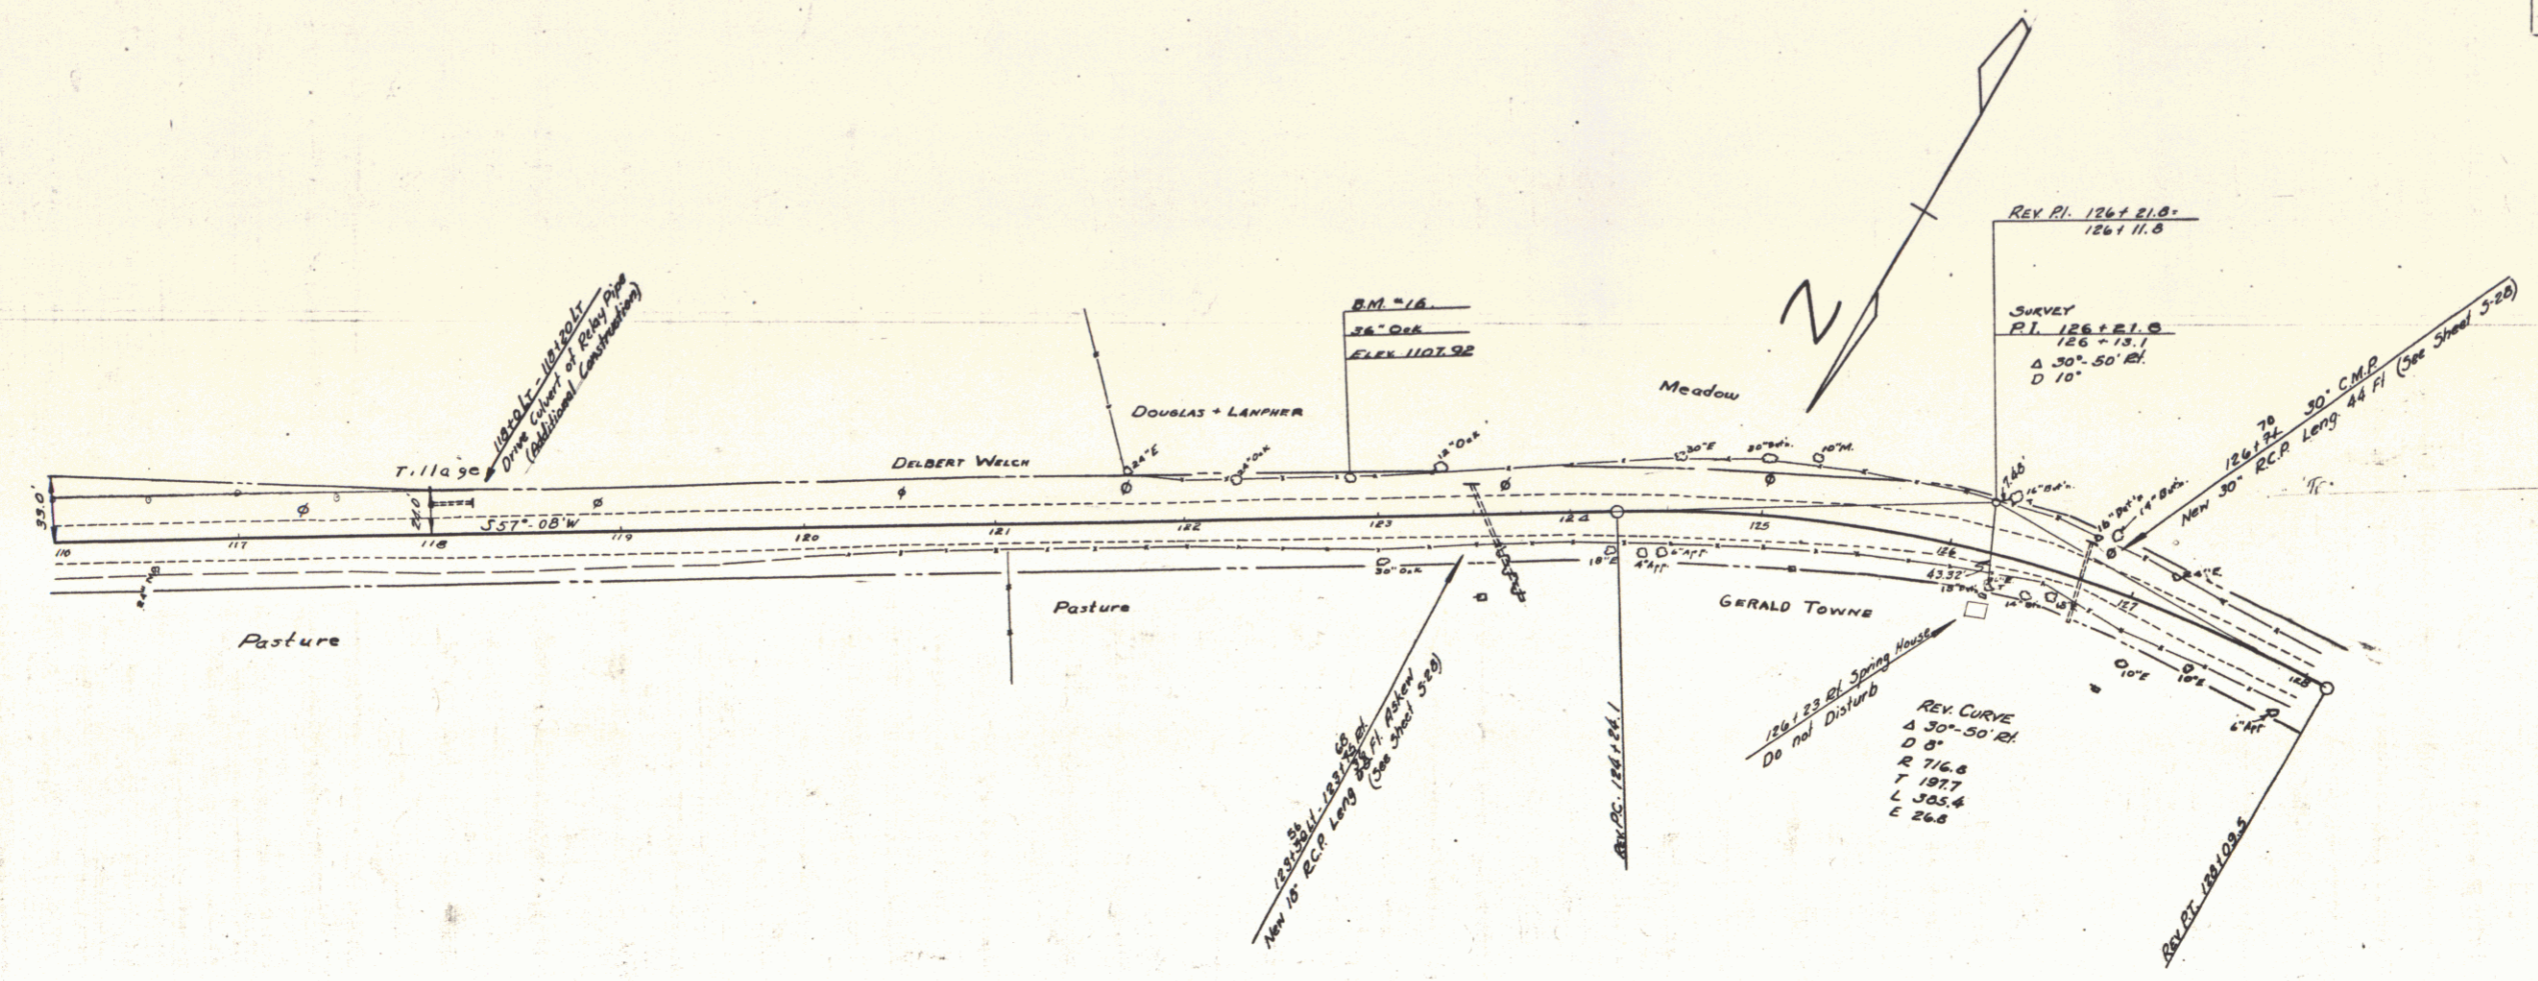

B.M. No. 10 Spike in Root of 36° Oak 19 ft. Lt. of Sta. 122+86 Elev. 1107.92

FEB 29 1980

SERIES E.O.S. NO. 212B SHEET 7 OF 31