
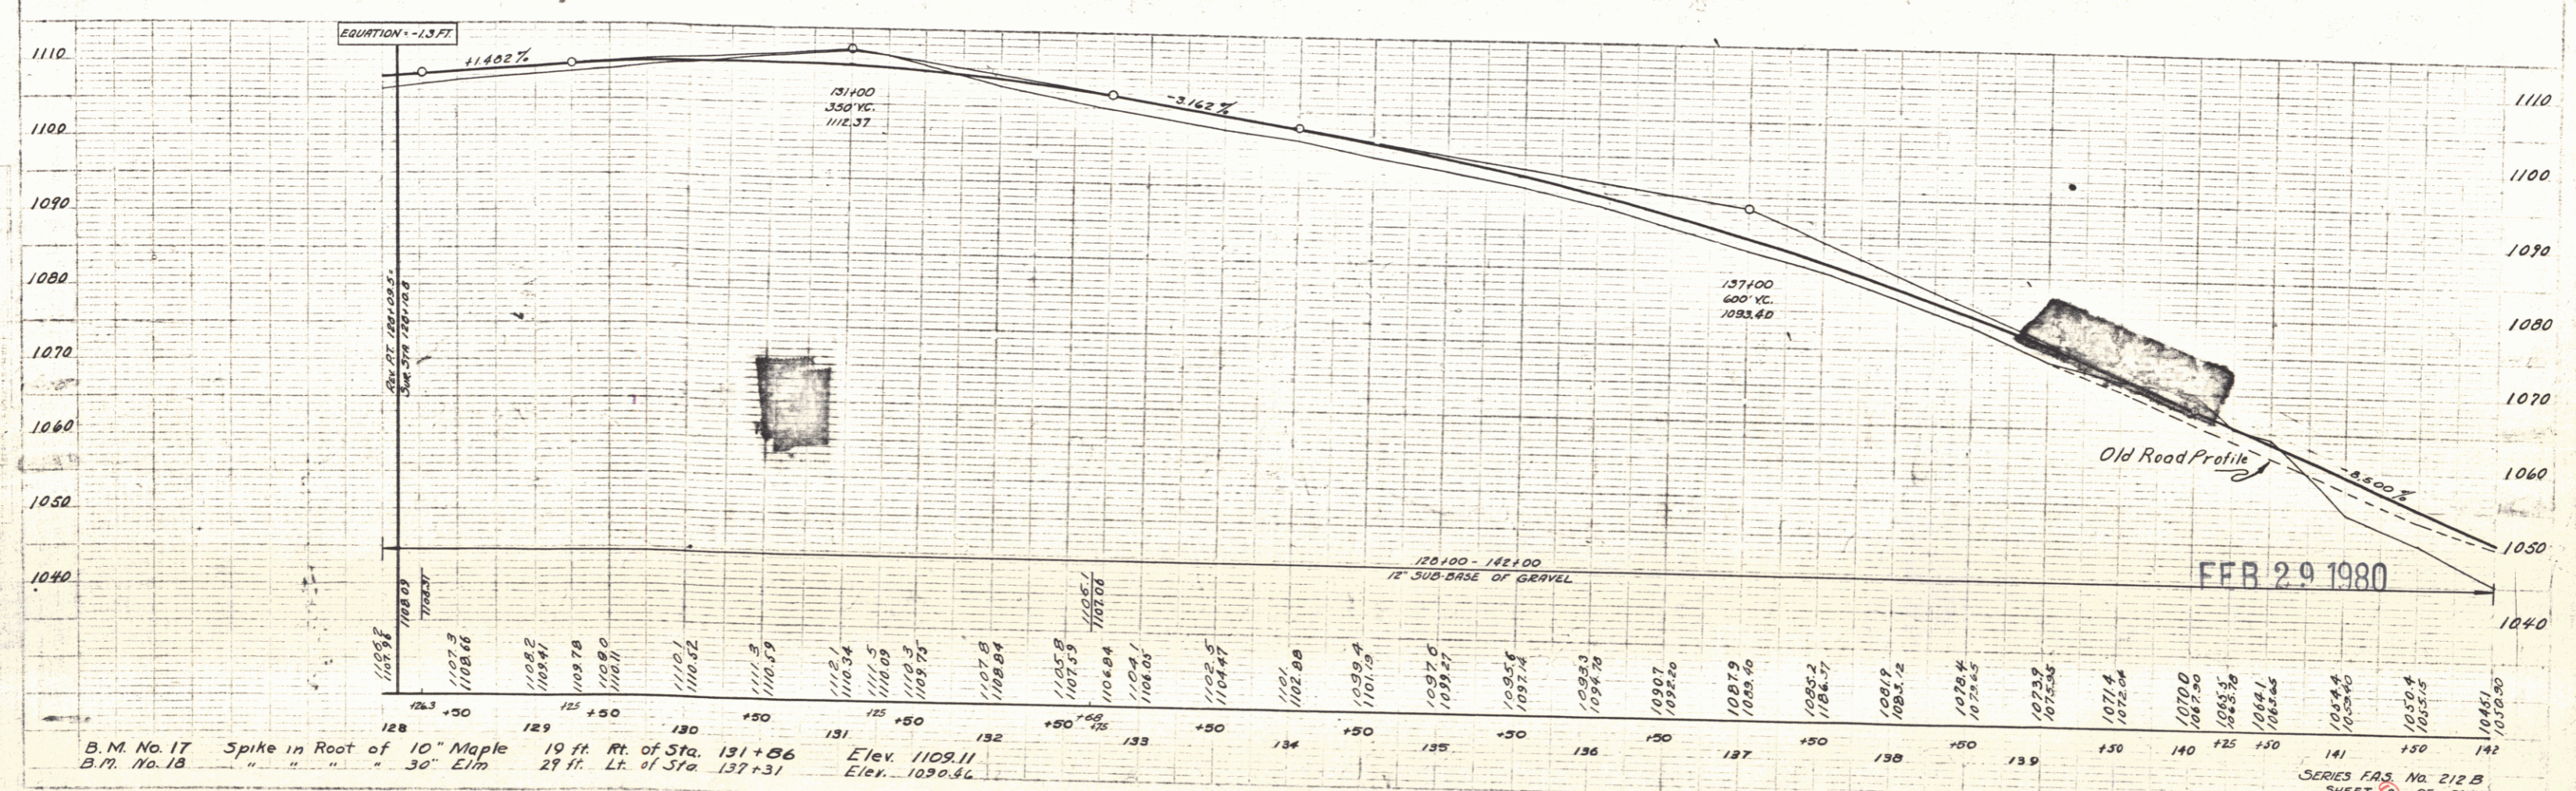


FED. ROAD DIST. NO.	STATE	P.A.S. PROJ. NO.	FISCAL YEAR	SHEET NO.	TOTAL SHEETS
1	VT	212 B	1980	8	31

PLAN  
 DATE: 2/11/80  
 DRAWN BY: WILSON  
 CHECKED BY: NELSON  
 SCALE: 1" = 40'

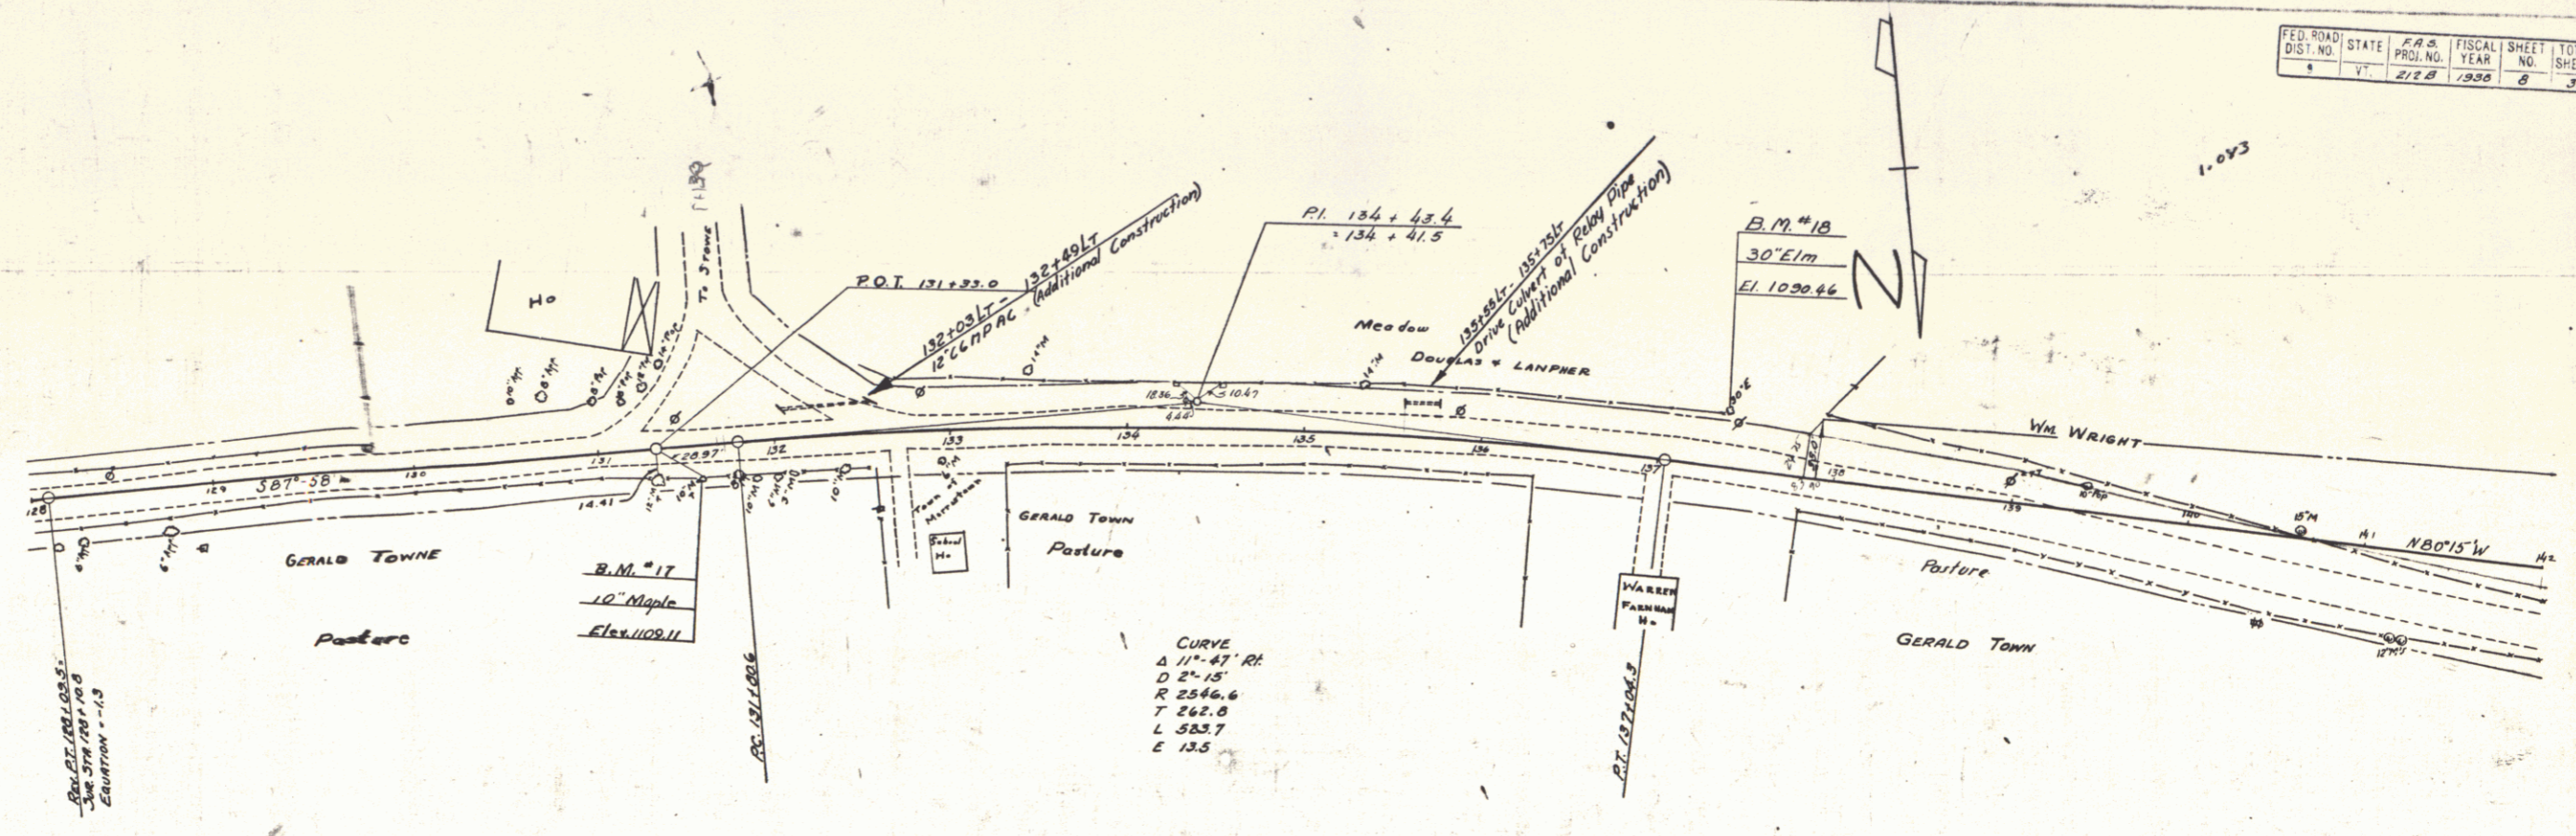

B.M. No. 17 Spike in Root of 10" Maple 19 ft. Rt. of Sta. 131+86 Elev. 1109.11  
 B.M. No. 18 " " " " 30" Elm 29 ft. Lt. of Sta. 137+31 Elev. 1090.46

SERIES P.A.S. No. 212 B  
SHEET 8 OF 31