


PLAN
 DATE
 DRAWN BY
 CHECKED BY
 APPROVED BY

Proposed
 2.0000'

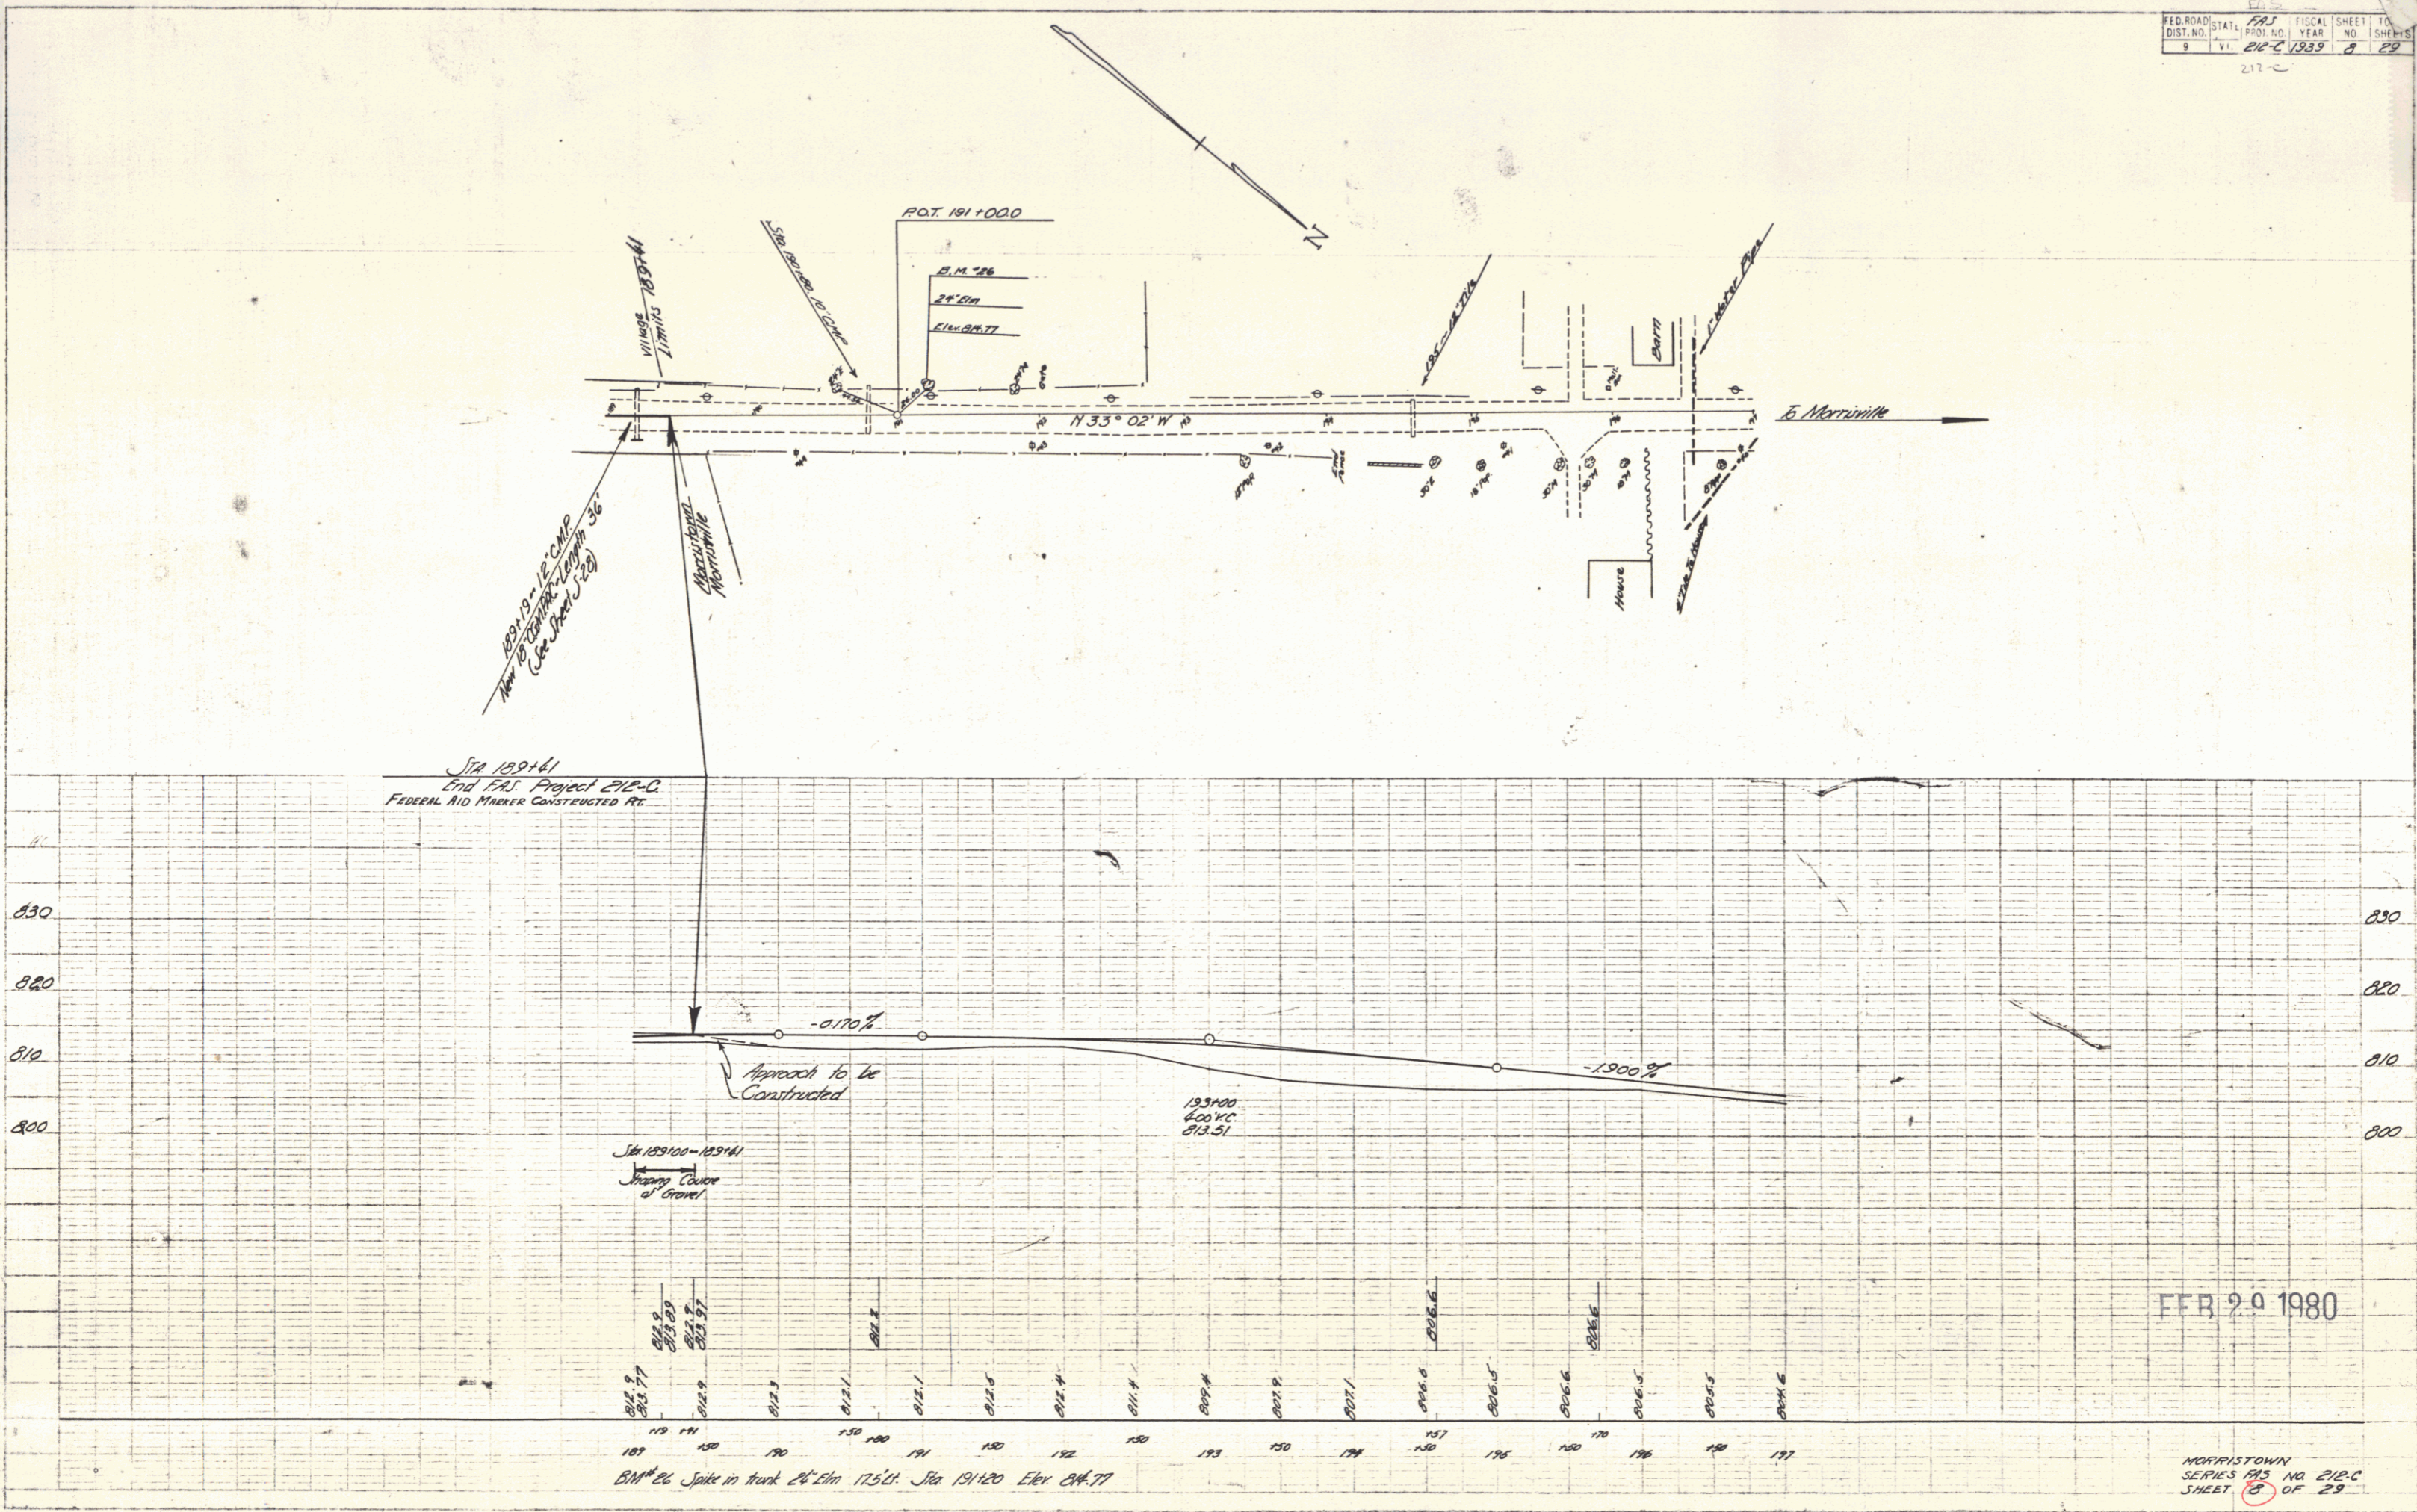

FEB 29 1980