

FAP 113A

WOOD GUARD RAIL		
STATION	LT	RT
858+00	27	24


FAP 113A

WOOD GUIDE POSTS		
STA.	LT	RT
853+77	1	1

PLAN	STATE	FED. AD.	PROJ.	SHEET	TOTAL
1113-A	PA		1936	7	10

Parcel	Kind of Instrument	Date of Grant	Grantor	Grantee	Recorded Greenfield Book Page Date	Remarks
B.C.D.E.	G.C.D.	2-1-33	C. J. Baker	Stet. H.	24 528-9	2-7-30
A. & C. Baker	"	7-31-33	Henry G. Baker	"	26 526-7	8-3-33 Cal. Sta. 858+00

NOTE:
Sta. 856+50 - 860+00
Muck and top Humus is to be removed as shown on cross-sections, and backfill is to be made of suitable borrow. Excavation and backfill is to be paid for as common excavations and borrow.

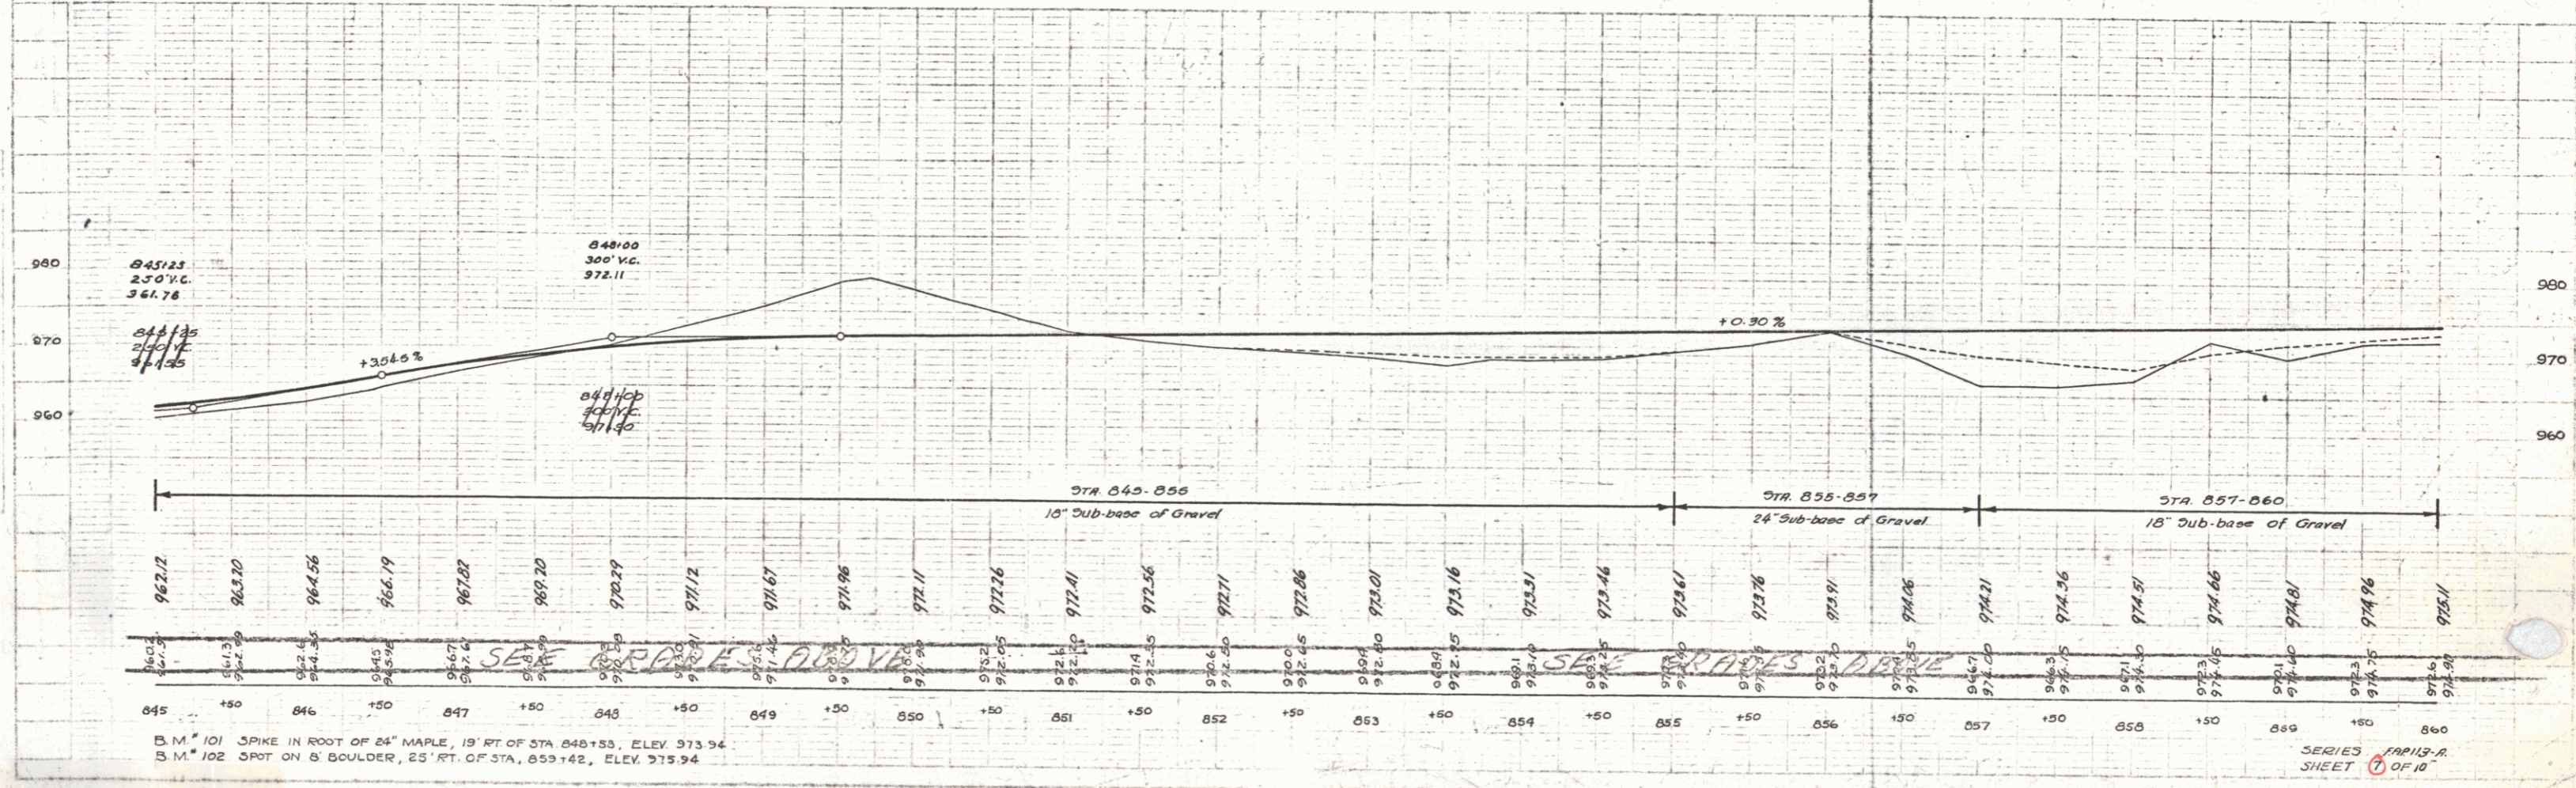

SERIES 1113-A SHEET 7 OF 10

5