

INDEX OF SHEETS

SHEET NO. 1	TITLE PAGE
" 2	TYPICAL CROSS-SECTION OF IMPROVEMENT
" 3	BANKING AND WIDENING TABLES
" 4-20	PLAN AND PROFILE SHEETS
" 21	STANDARD STRUCTURE SHEET 530 GUARD RAIL AND GUIDE POSTS
" 22-5-40	SIGNS AND LIGHTS & BACKSCREES
"	STANDARD STRUCTURE SHEET 5-30 APPROVED BY CHIEF ENGINEER ON AUGUST 15 1933

2 1/2" Gravel Mixed in Place Surface Course with Retained Top 10" 2 1/2" & 2 1/2" of
2 1/2" Plant Mixed Gravel Surface Course with Cut-Back Asphalt, Item 97.

STATE OF VERMONT
 STATE HIGHWAY DEPARTMENT

FED. ROAD DIST. NO.	STATE	F.A.P. PROJ. NO.	FISCAL YEAR	PROJECT YEAR	SHEET NO.	TOTAL SHEETS
9	VT.	78 G	1934	1	22	

(To Be Returned To E.O.W. Division)
 Form of VT-12
 PERPETUAL
 E.O.W. FILE
 RIGHT-OF-WAY DIVISION

PLAN AND PROFILE OF PROPOSED
 STATE HIGHWAY

FEDERAL AID PROJECT

TOWNS OF NORTHFIELD-ROXBURY



MONTPELIER-RANDOLPH ROAD

FROM 426 FEET SOUTH OF ITS INTERSECTION WITH ROUTE 12A, SOUTHERLY 4.317 MILES TO 350 FEET NORTHERLY OF THE EAST ROXBURY SCHOOL.

LENGTH OF PROJECT 22 795.0 FT. = 4.317 MILES

Pin# 99R 988

Rt VT12

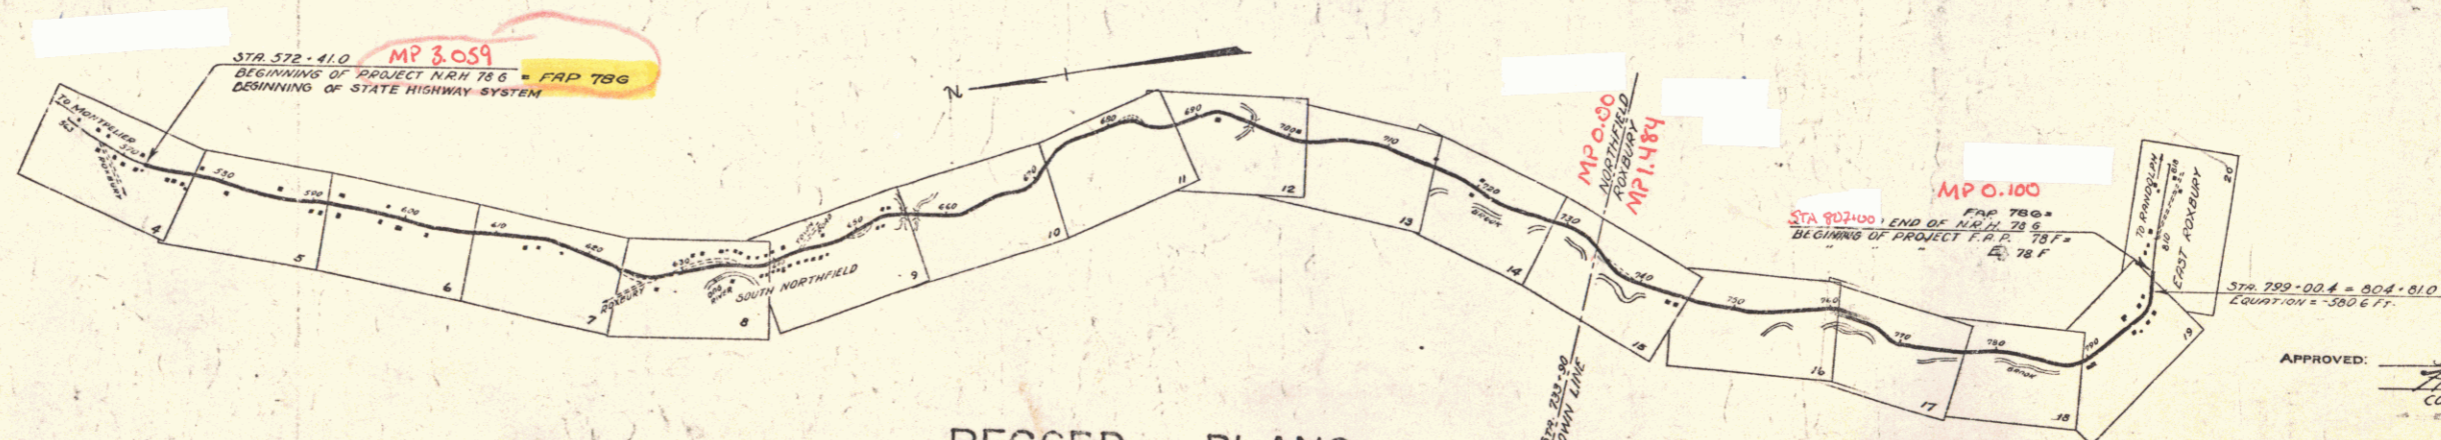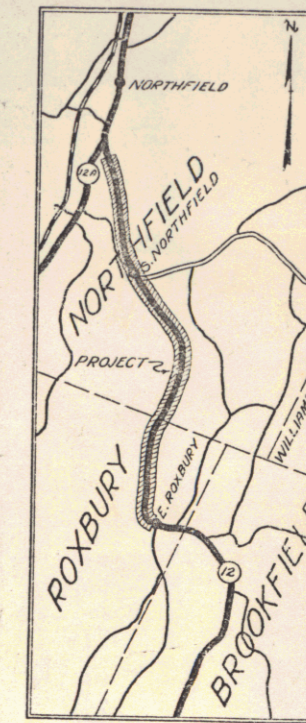

APPROVED: JULY 21, 1935 April 1, 1935
 H. S. Stewart
 COMMISSIONER OF HIGHWAYS

SUBMITTED: _____ OF THE STATE HIGHWAY DEPARTMENT

RECORD PLANS

SCALES
 TITLE 1" = 1000'
 PLAN 1" = 50'
 PROFILE HOR. 1" = 50'
 VERT. 1" = 10'

NOTE:
 NRH 78 G, YEAR 1934, CONTR. - TROY PAVING CO.
 FAP 78 G, YEAR 1937, CONTR. - CALLAN CONST. CO.

Note: The alignment and grades for this project are to be the same as on the original plans originally submitted for NRH 78 G, except that the grade is raised 2 1/2 inches.

Note: These plans are subject to such revisions as may be required by the Bureau of Public Roads or the Commissioner of Highways. Construction is to be carried on in accordance with the plans and standard road and bridge specifications of 1930 including all subsequent approved revisions, and such revised specifications and special provisions as are permitted with the plans.

CONVENTIONAL SIGNS

COUNTY LINE	GROUND ELEVATION	GRADE ELEVATION
TOWN LINE	FENCE LINE	STONE WALL
UNFENCED PROPERTY	GUARD RAIL	TRAVELED WAY
RAILROAD	RETAINING WALL	CENTER LINE
SURVEY LINE	C&P VERT.	C&P INLET
TROLLEY POLE	POWER POLE	TELEPHONE POLE
TREES	HEDGE	

CURVE DATA

DEFLECTION ANGLE	DEGREE OF CURVE	RADIUS OF CURVE	TANGENT DISTANCE	LENGTH OF CURVE	EXTERNAL DISTANCE	POINT OF INTERSECTION	POINT OF CURVE	POINT OF TANGENT	POINT ON TANGENT
Δ	D	R	T	L	E	P. I.	P. C.	P. T.	P. O. T.

RECORD PLANS

NORTHFIELD-ROXBURY FAP 78 G
 RECORD PLANS
 CONTR. - SEE BELOW
 FISCAL YEAR - SEE BELOW