



FAP 78-6			
STATION	CHANG. LT.	STATION	CHANG. LT.
592.00	0.0	597.25	5.25
592.50	0.5	598.00	7.75
593.00	1.0	599.00	10.75
594.00	2.0	600.00	13.75
595.00	3.0	601.00	16.75

FAP 78-6			
STATION	CHANG. LT.	STATION	CHANG. LT.
600.00	0.0	605.00	5.00
601.00	1.0	606.00	8.00
602.00	2.0	607.00	11.00
603.00	3.0	608.00	14.00
604.00	4.0	609.00	17.00

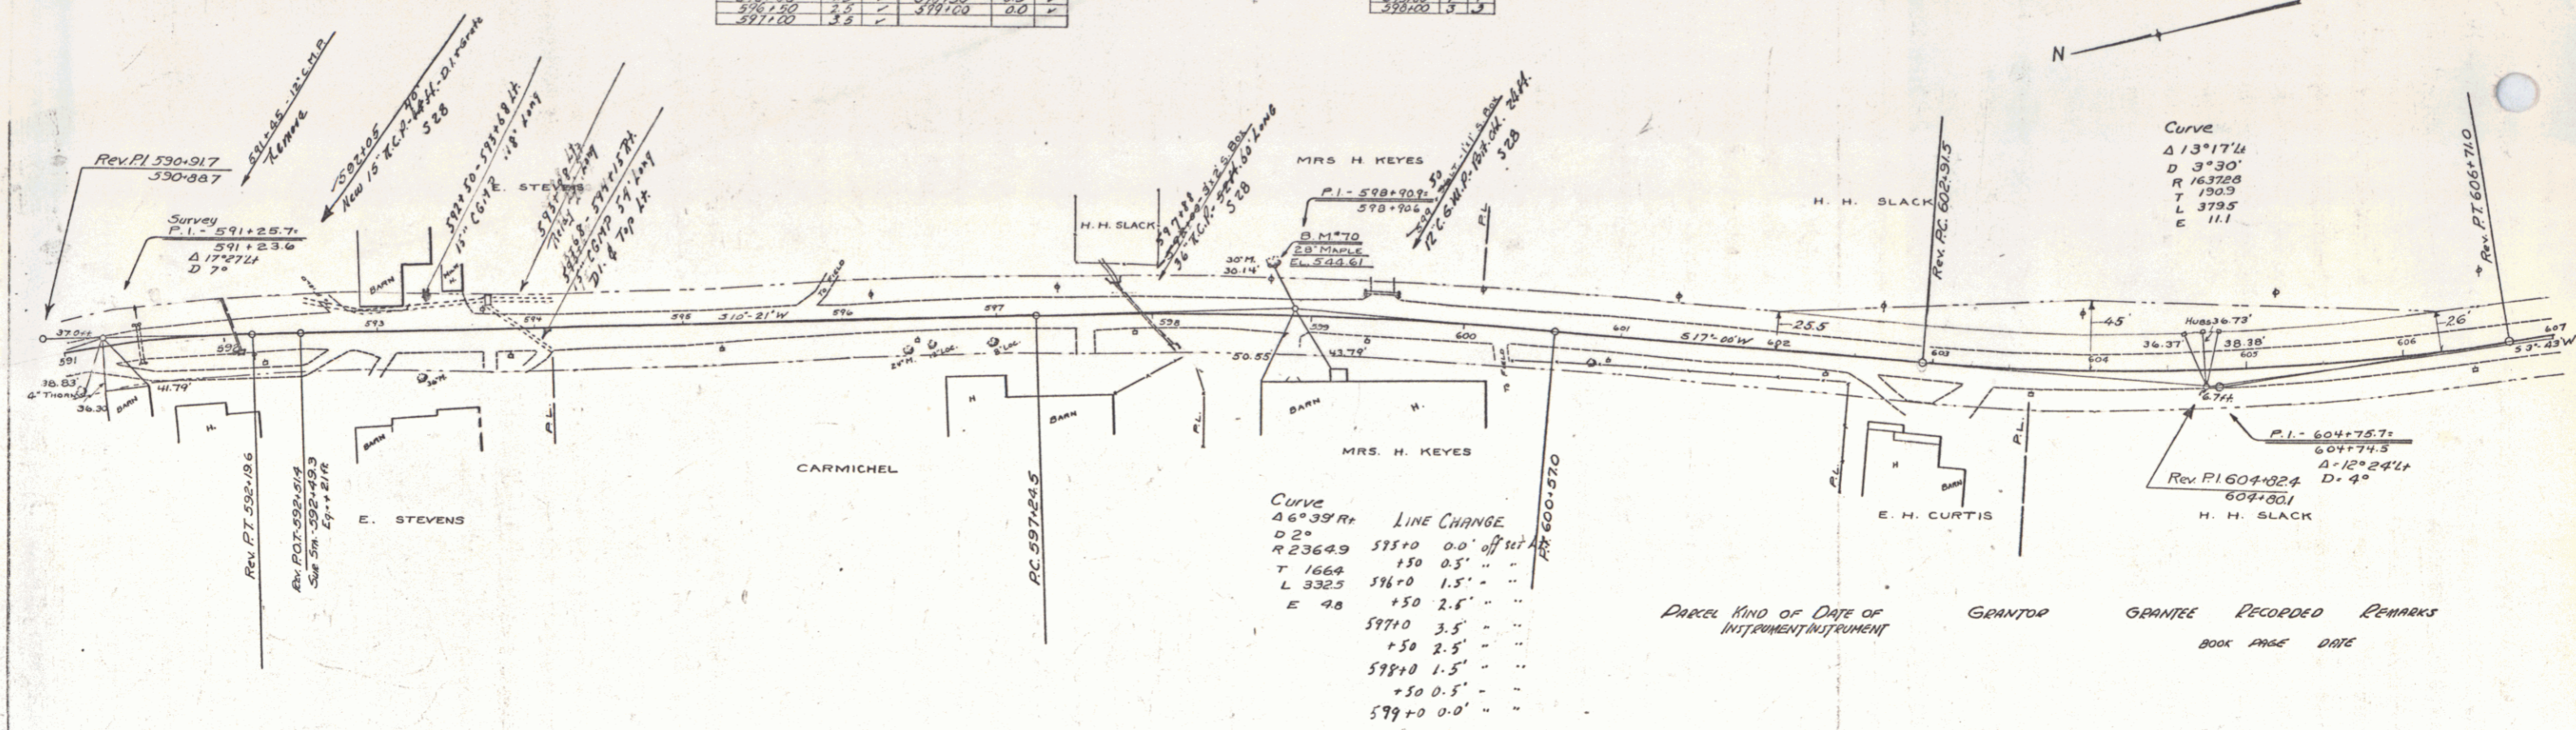

PLANNING  
 ENGINEERING  
 SURVEYING  
 CIVIL ENGINEERING  
 MECHANICAL ENGINEERING  
 ELECTRICAL ENGINEERING  
 CHEMICAL ENGINEERING  
 METALLURGICAL ENGINEERING  
 MINING ENGINEERING  
 AERONAUTICAL ENGINEERING  
 MARINE ENGINEERING  
 ARCHITECTURE  
 LANDSCAPE ARCHITECTURE  
 INTERIOR DESIGN  
 CITY PLANNING  
 ENVIRONMENTAL ENGINEERING  
 INDUSTRIAL ENGINEERING  
 AGRICULTURAL ENGINEERING  
 FOOD ENGINEERING  
 TEXTILE ENGINEERING  
 PAPER ENGINEERING  
 PETROLEUM ENGINEERING  
 CHEMICAL PROCESS ENGINEERING  
 ENVIRONMENTAL SCIENCE  
 ENVIRONMENTAL HEALTH AND SAFETY  
 ENVIRONMENTAL IMPACT ASSESSMENT  
 ENVIRONMENTAL MONITORING AND ASSESSMENT  
 ENVIRONMENTAL PLANNING AND DESIGN  
 ENVIRONMENTAL POLICY AND LEGISLATION  
 ENVIRONMENTAL QUALITY MANAGEMENT  
 ENVIRONMENTAL RECONSTRUCTION AND RESTORATION  
 ENVIRONMENTAL SCIENCE AND TECHNOLOGY  
 ENVIRONMENTAL SYSTEMS MANAGEMENT  
 ENVIRONMENTAL TOXICOLOGY AND CHEMISTRY  
 ENVIRONMENTAL WATER RESOURCES MANAGEMENT  
 ENVIRONMENTAL WASTE MANAGEMENT  
 ENVIRONMENTAL ZONING AND PLANNING  
 ENVIRONMENTAL IMPACT ASSESSMENT  
 ENVIRONMENTAL MONITORING AND ASSESSMENT  
 ENVIRONMENTAL PLANNING AND DESIGN  
 ENVIRONMENTAL POLICY AND LEGISLATION  
 ENVIRONMENTAL QUALITY MANAGEMENT  
 ENVIRONMENTAL RECONSTRUCTION AND RESTORATION  
 ENVIRONMENTAL SCIENCE AND TECHNOLOGY  
 ENVIRONMENTAL SYSTEMS MANAGEMENT  
 ENVIRONMENTAL TOXICOLOGY AND CHEMISTRY  
 ENVIRONMENTAL WATER RESOURCES MANAGEMENT  
 ENVIRONMENTAL WASTE MANAGEMENT  
 ENVIRONMENTAL ZONING AND PLANNING

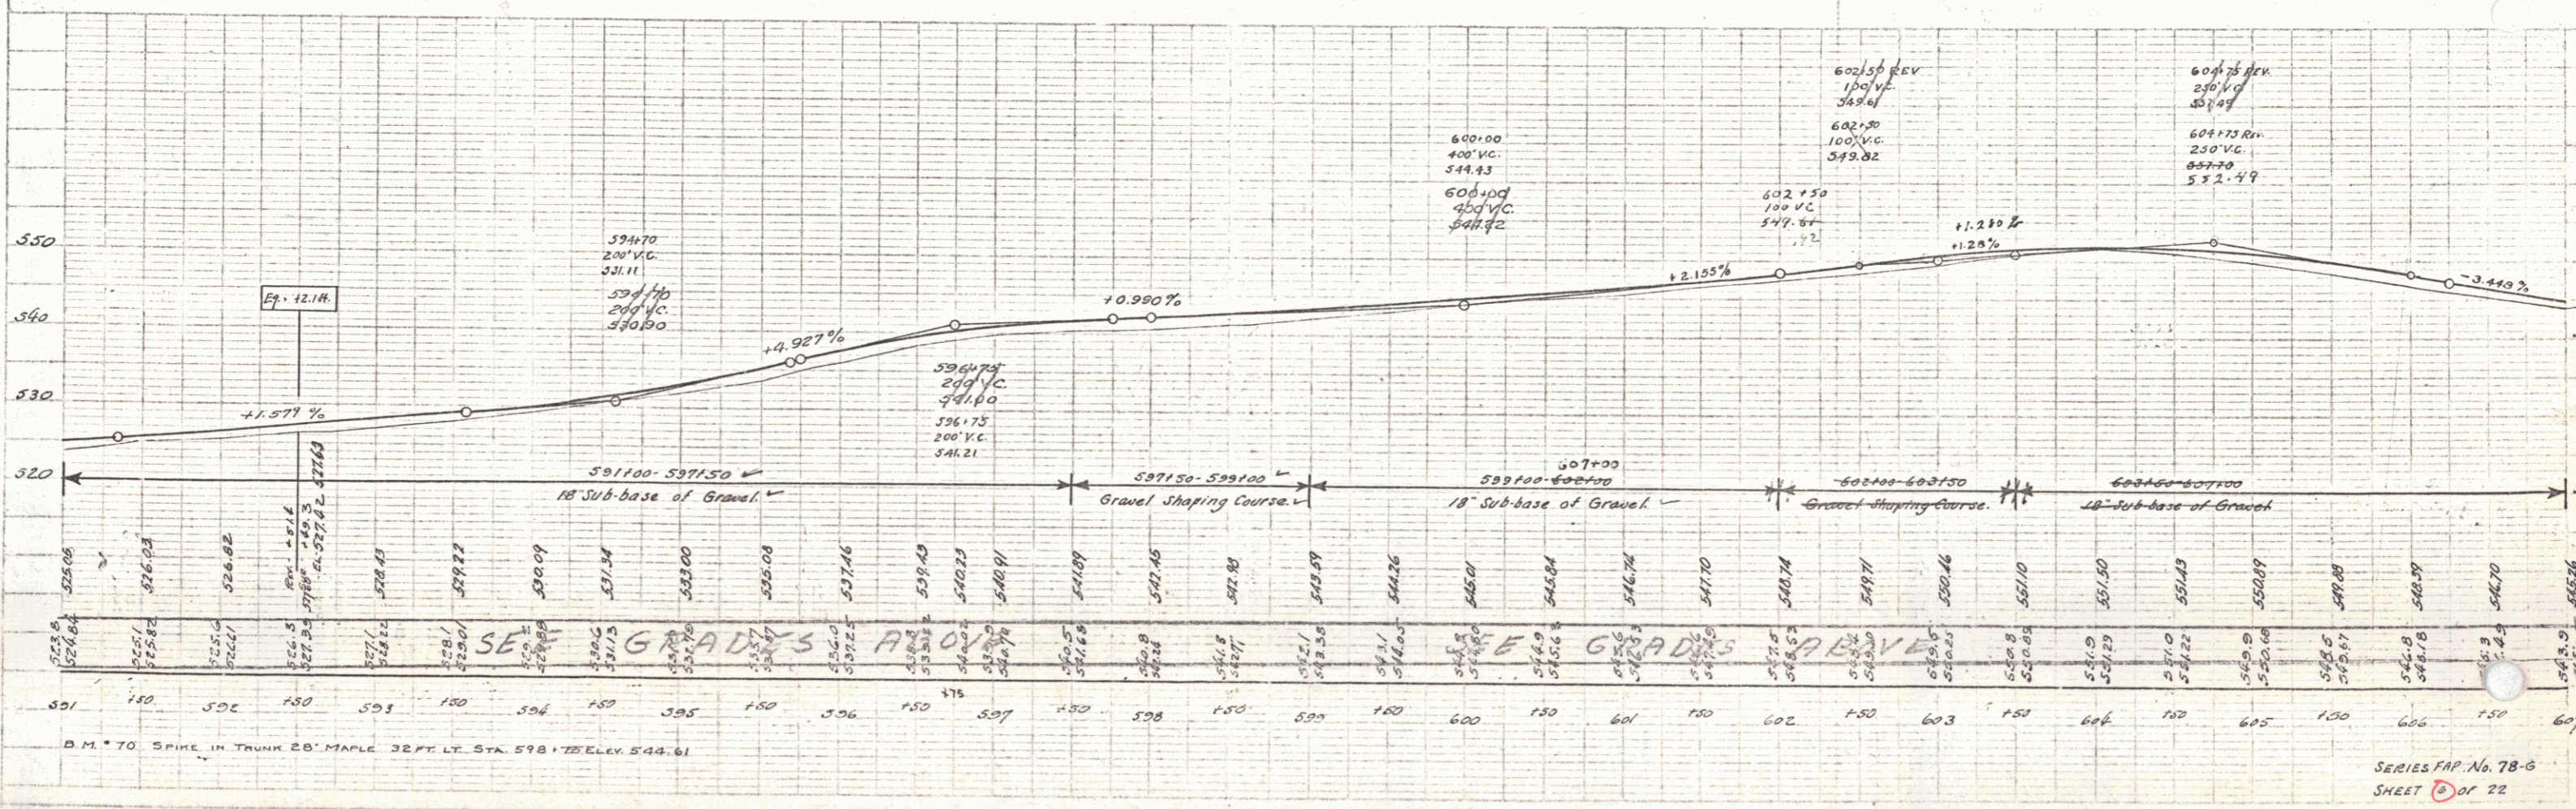

4