


STATION	LT	RT
610.00	1	0
610.25	1	0
610.50	1	0
610.75	1	0
611.00	1	0


STATION	STATION	LT	RT
610.00	610.00	1	0
610.25	610.25	1	0
610.50	610.50	1	0
610.75	610.75	1	0
611.00	611.00	1	0

STATE OF VT. 7-6-1928

DATE: 7/28/28
 DRAWN BY: [Signature]
 CHECKED BY: [Signature]

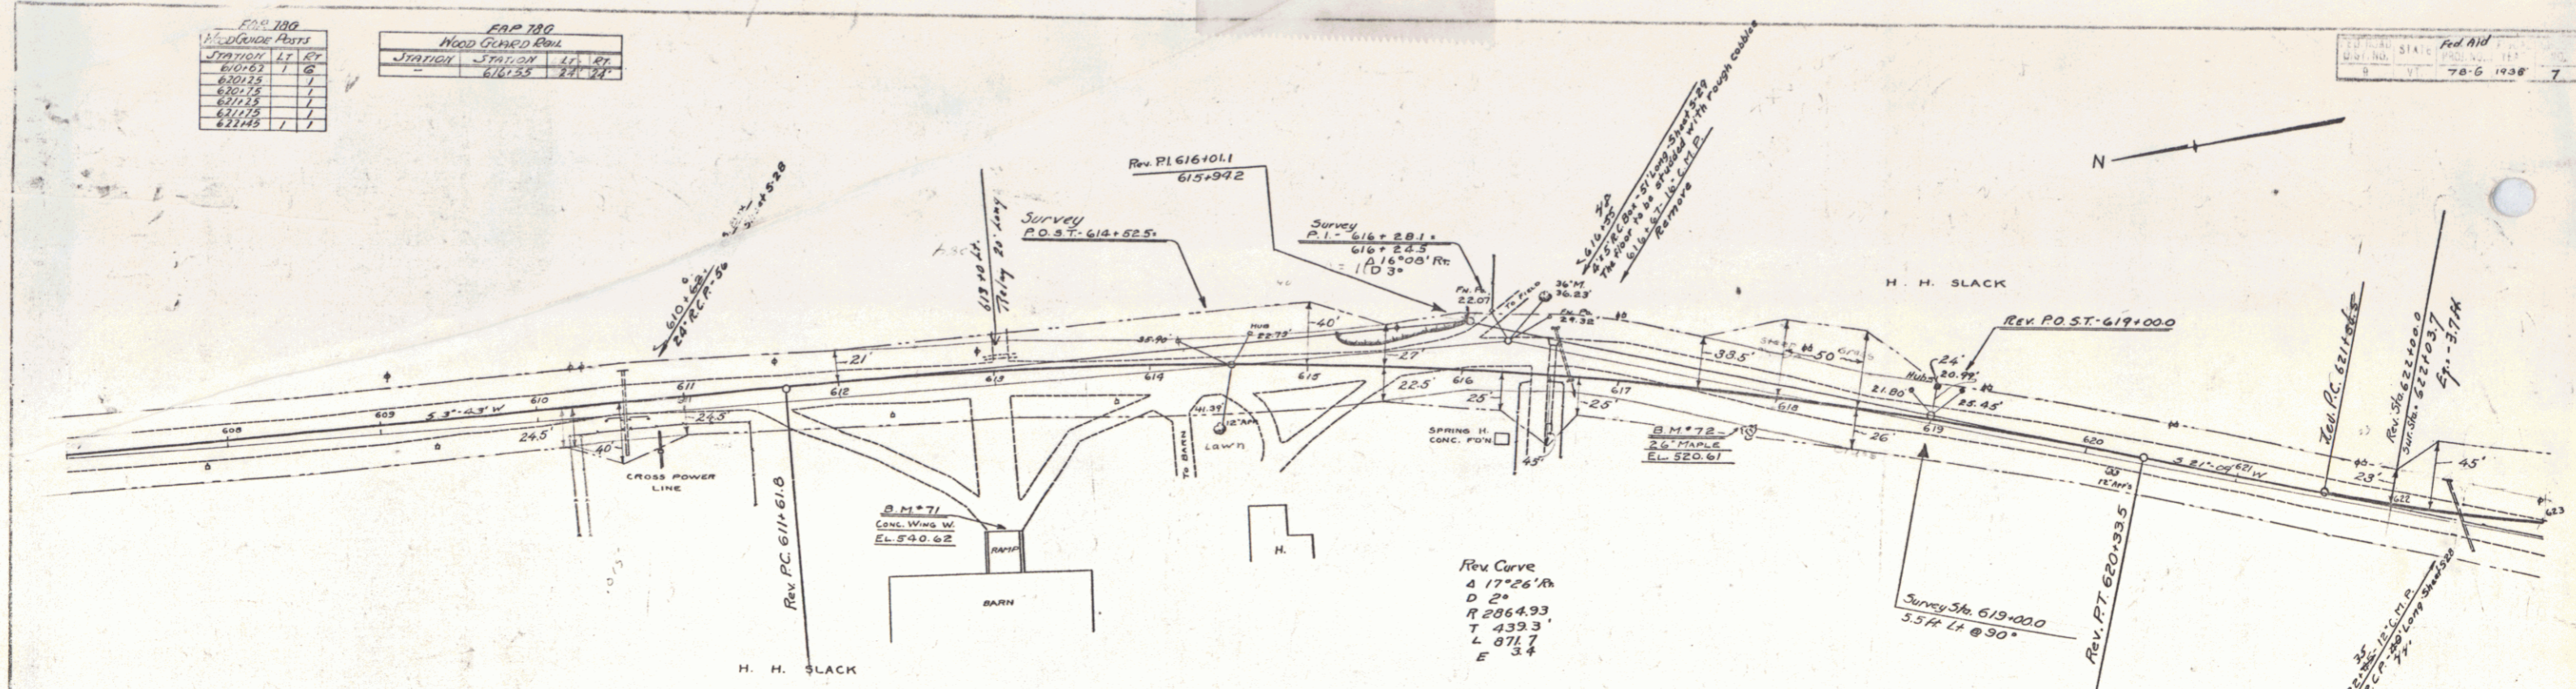

Parcel Kind of Date of Instrument Instrument GRANTEE GRANTEE RECORDED BOOK PAGE DATE

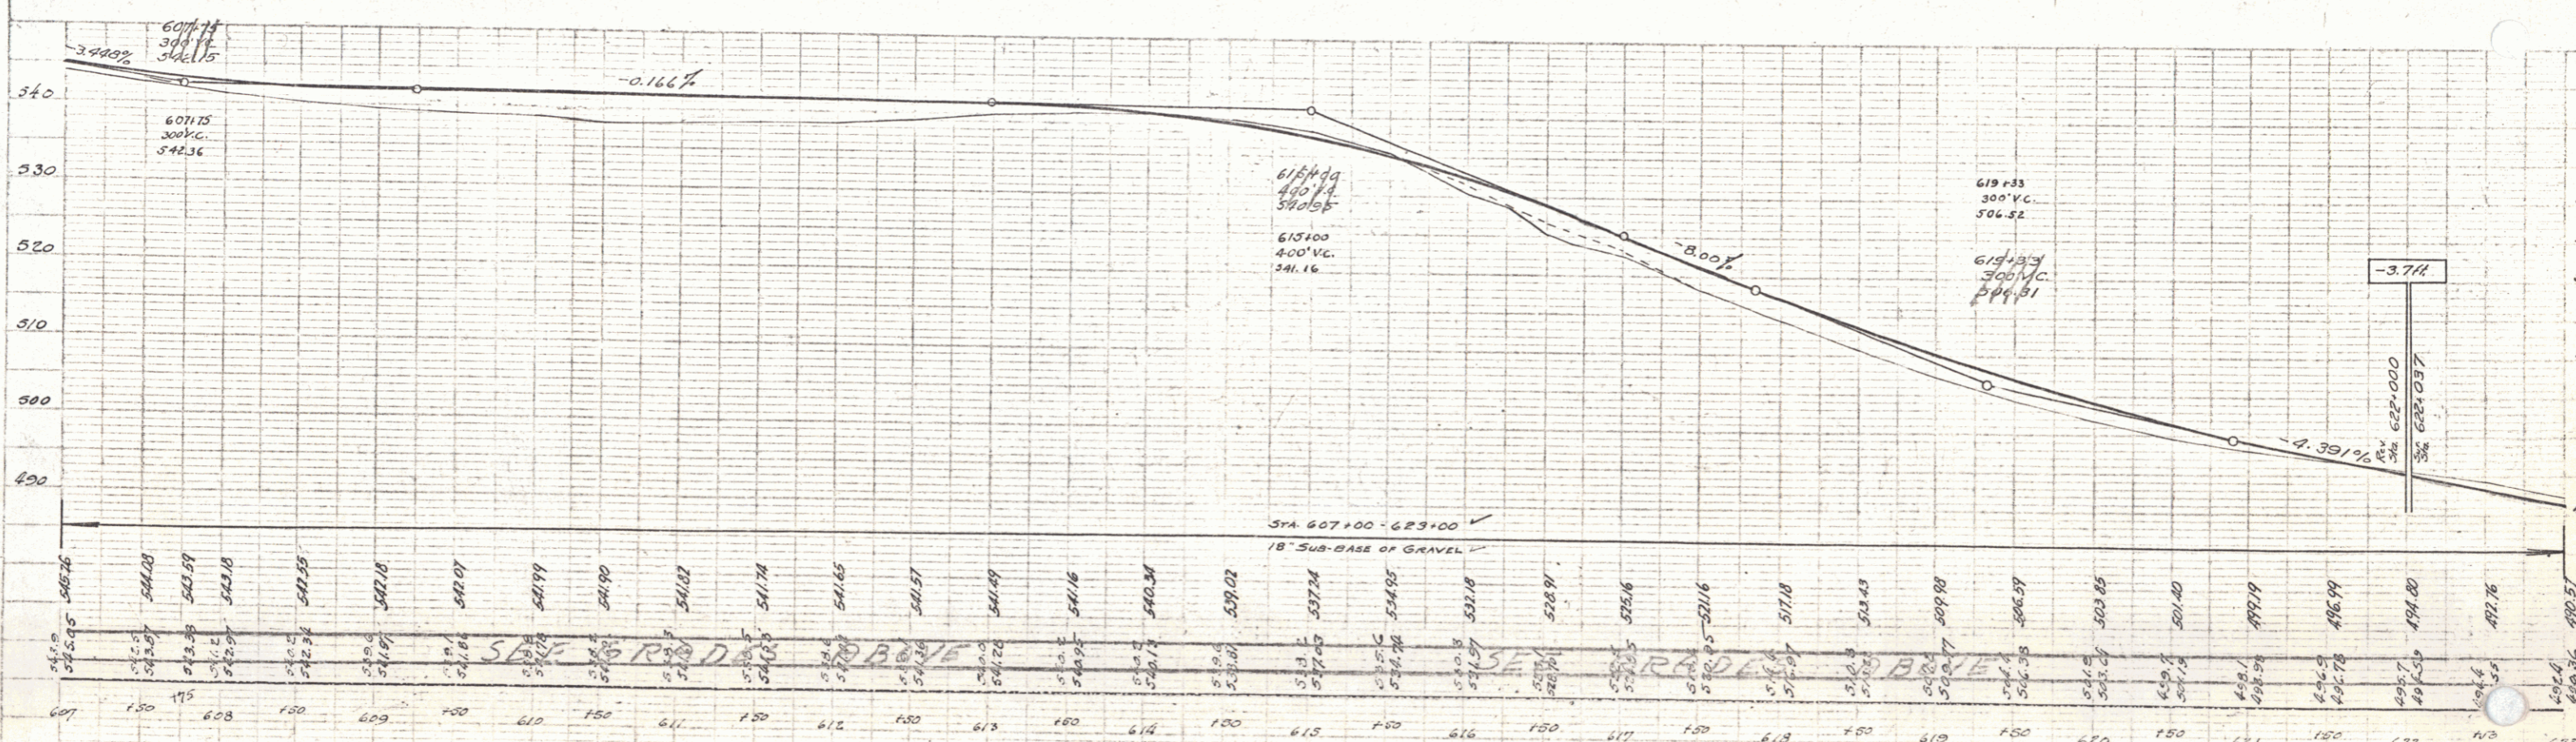

B.M. *71 PAINT SPOT ON CONC WING WALL 95 FT. RT. STA. 61307.00 ELEV. 540.62
 B.M. *72 SPIKE IN ROOT 26' MAPLE 21 FT. RT. STA. 61781.00 ELEV. 520.61

SERIES P.P. No. 786
 SHEET 7 OF 22