

629 148.3
407.4
625 40.7


PLAN
SECTION
SCALE
1" = 100'
1" = 10'

FAP 788 Cable Guard Rail					FAP 789 Wood Guard Rail					FAP 789 Wood Guard Rail				
Station	Station	Lt	Rt	Interval	Station	Station	Lt	Rt	Interval	Station	Station	Lt	Rt	Interval
62300	63164			100'	626176	627120			100'	626176	627120			100'
62300	63150			150'										


37477
31743
634

Tea Curve
431'45"
D 61'
T 743.27
L 793.0
E 36.0
Curve to be cut back inside
for visibility. See section.

APPROXIMATE
1764
CROSSING
R20204(1)
574.38+46
EL 1172

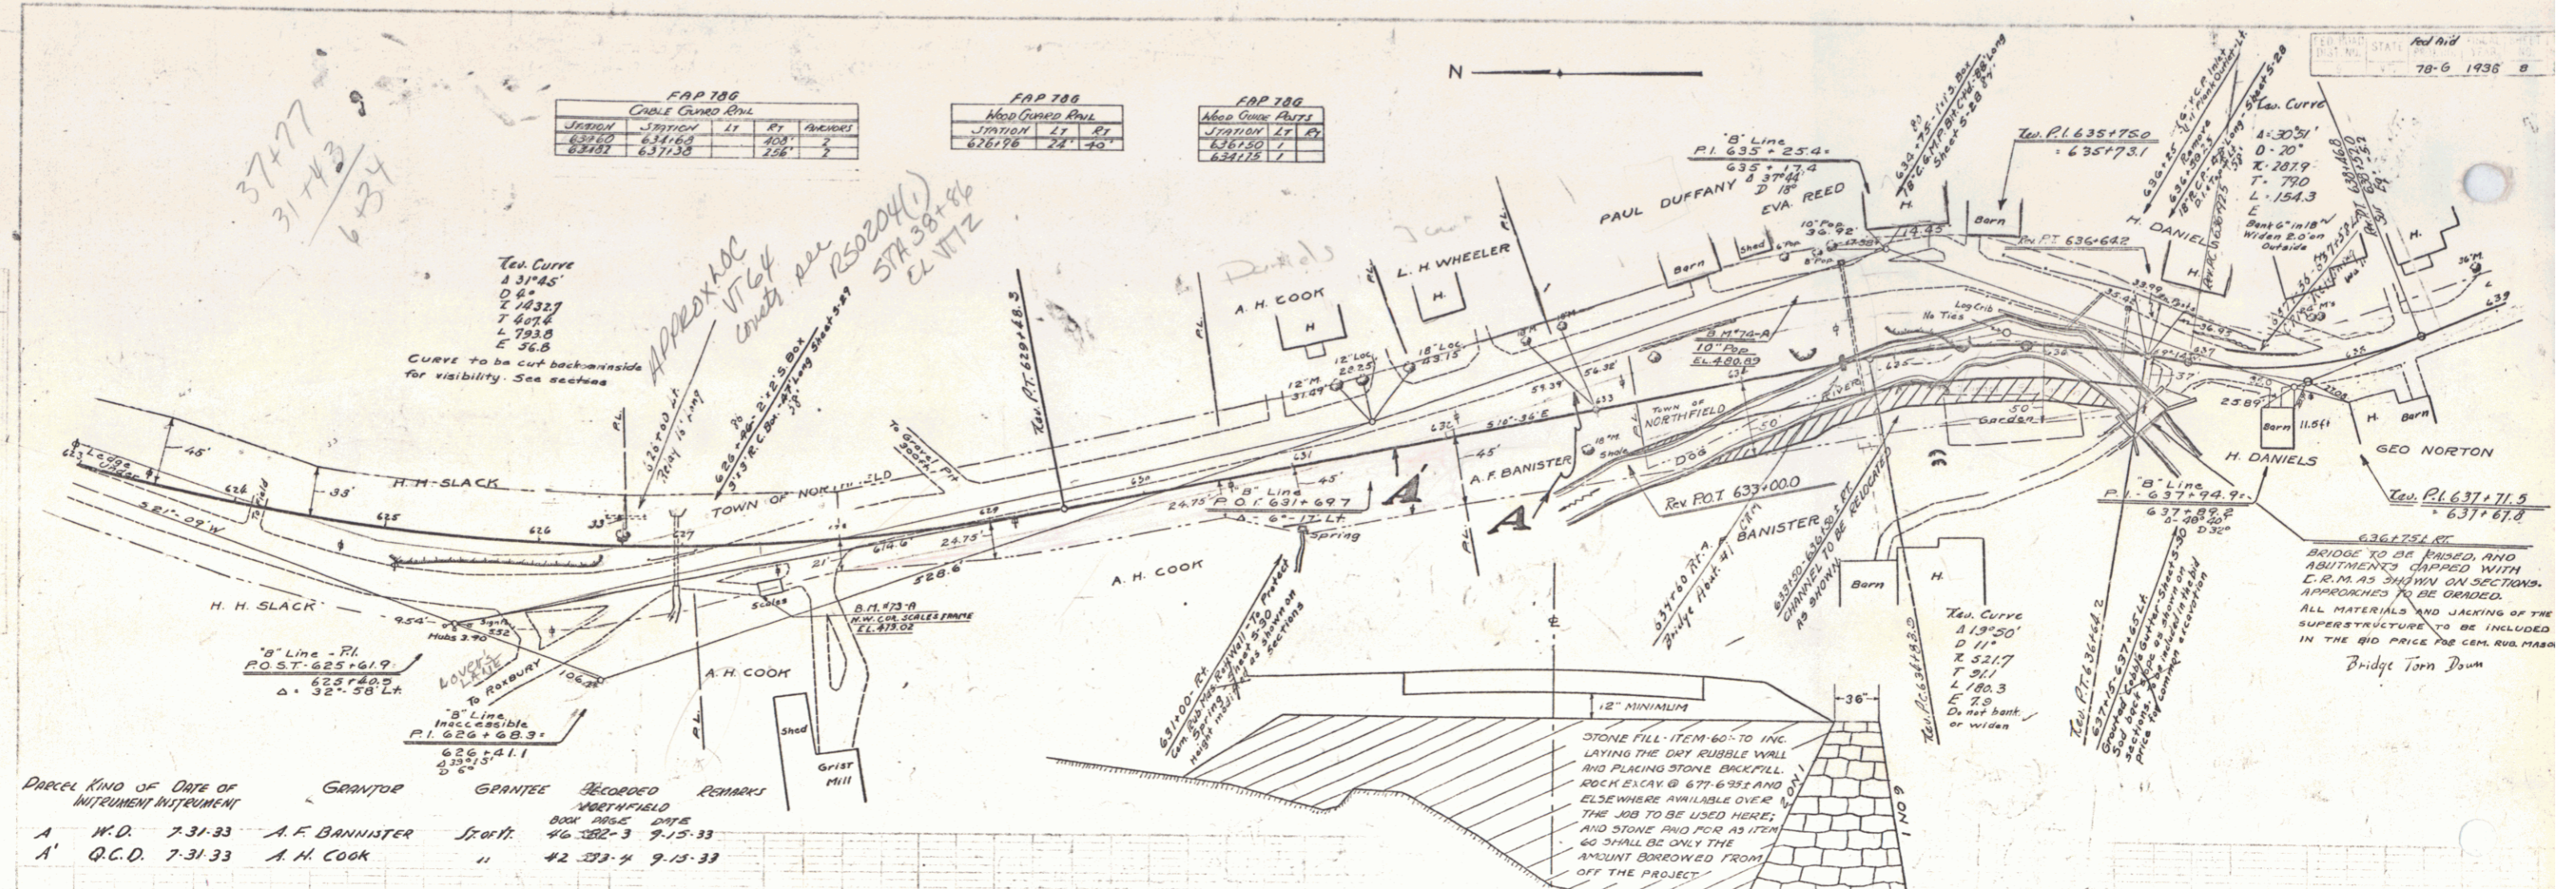

PARCEL	KIND OF INSTRUMENT	DATE OF INSTRUMENT	GRANTOR	GRANTEE	RECORDED	REMARKS
A	N.D.	7-31-33	A. F. BANISTER	St. 11	46-382-3	9-15-33
A'	Q.C.D.	7-31-33	A. H. COOK	"	42-373-4	9-15-33

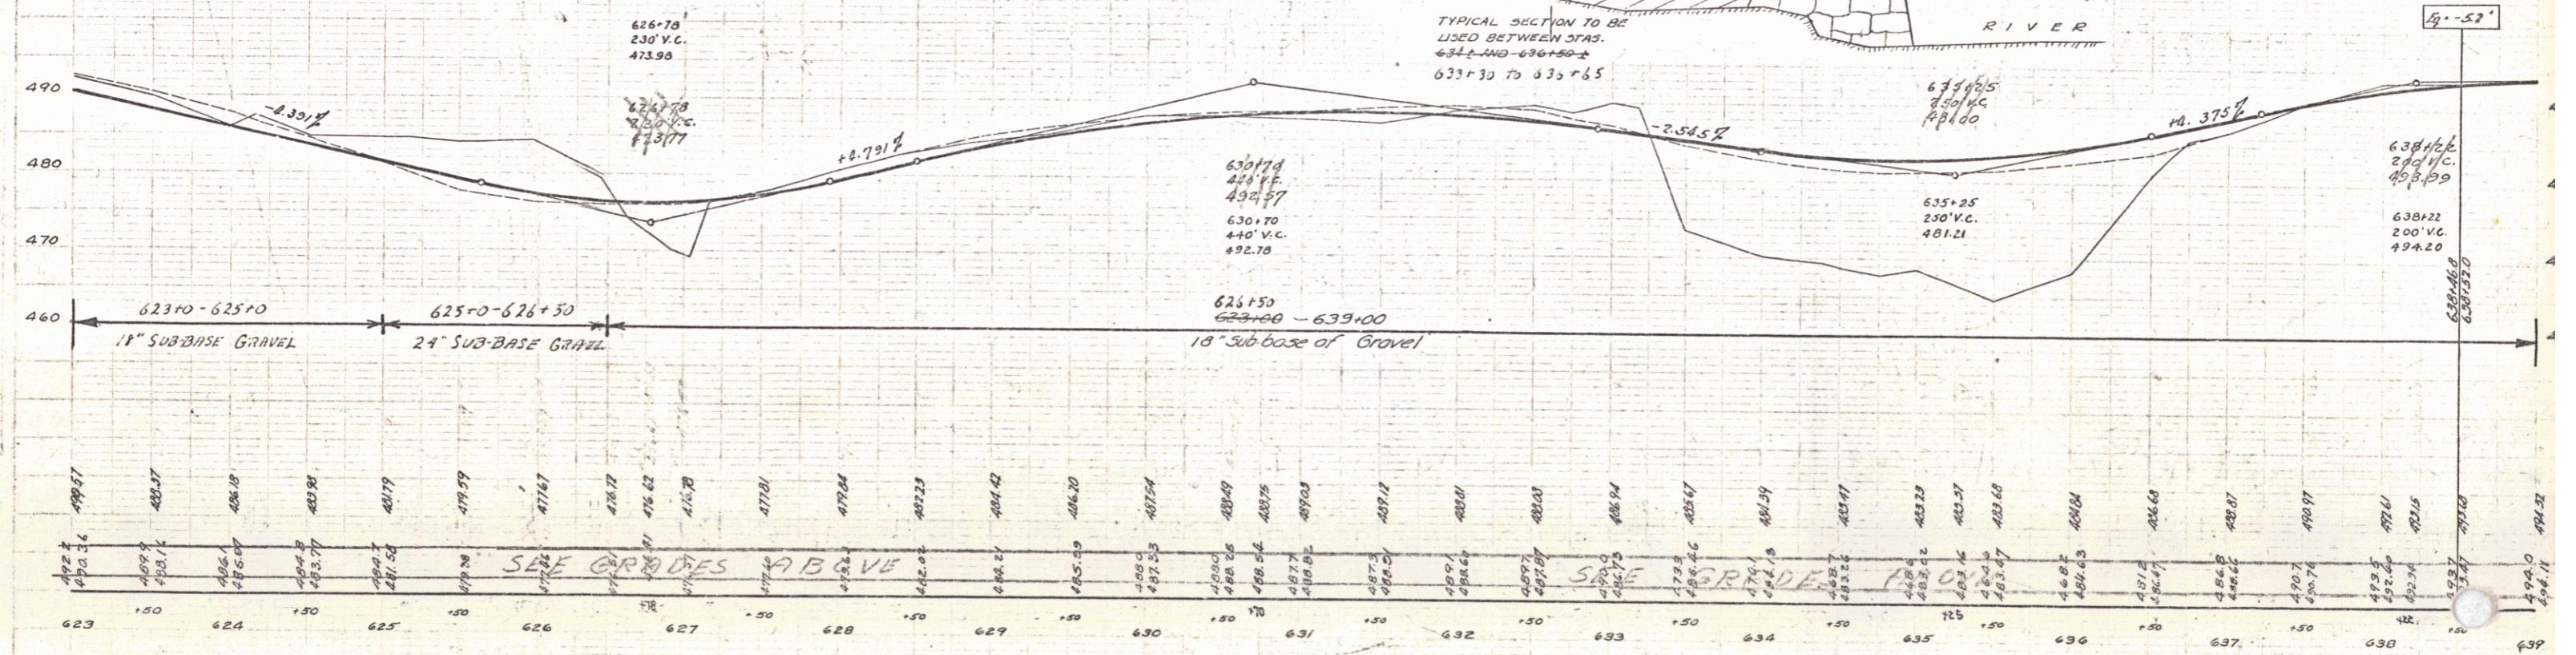

B.M. 73A N.W. Corner of Scale Mass St. Rt Sta 627+50 Elev. 478.2
B.M. 74A Spike in Roof of 10' Pop 71 ft. Sta 638+45 Elev. 480.3

6