

FAP 700

| STATION | STATION | LT | RT | ADJUST |
|---------|---------|----|-----|--------|
| 640.00 | 607.00 | - | 322 | |


FAP 700

| STATION | STATION | LT | RT | ADJUST |
|---------|---------|----|-----|--------|
| 641.00 | 607.00 | - | 322 | |

Vert. Curve
 0 20' 44"
 0 6'
 1 143.27
 2 242.1
 3 518.3
 4 24.3
 5 24.3
 Not Banked

LINE CHARGE
 672+50 0.0
 673+0 0.5 offset Lt.
 150 1.0
 677+0 0.5
 +30 0.10

| STATION | STATION | LT | RT | ADJUST |
|---------|---------|----|-----|--------|
| 641.00 | 607.00 | - | 322 | |

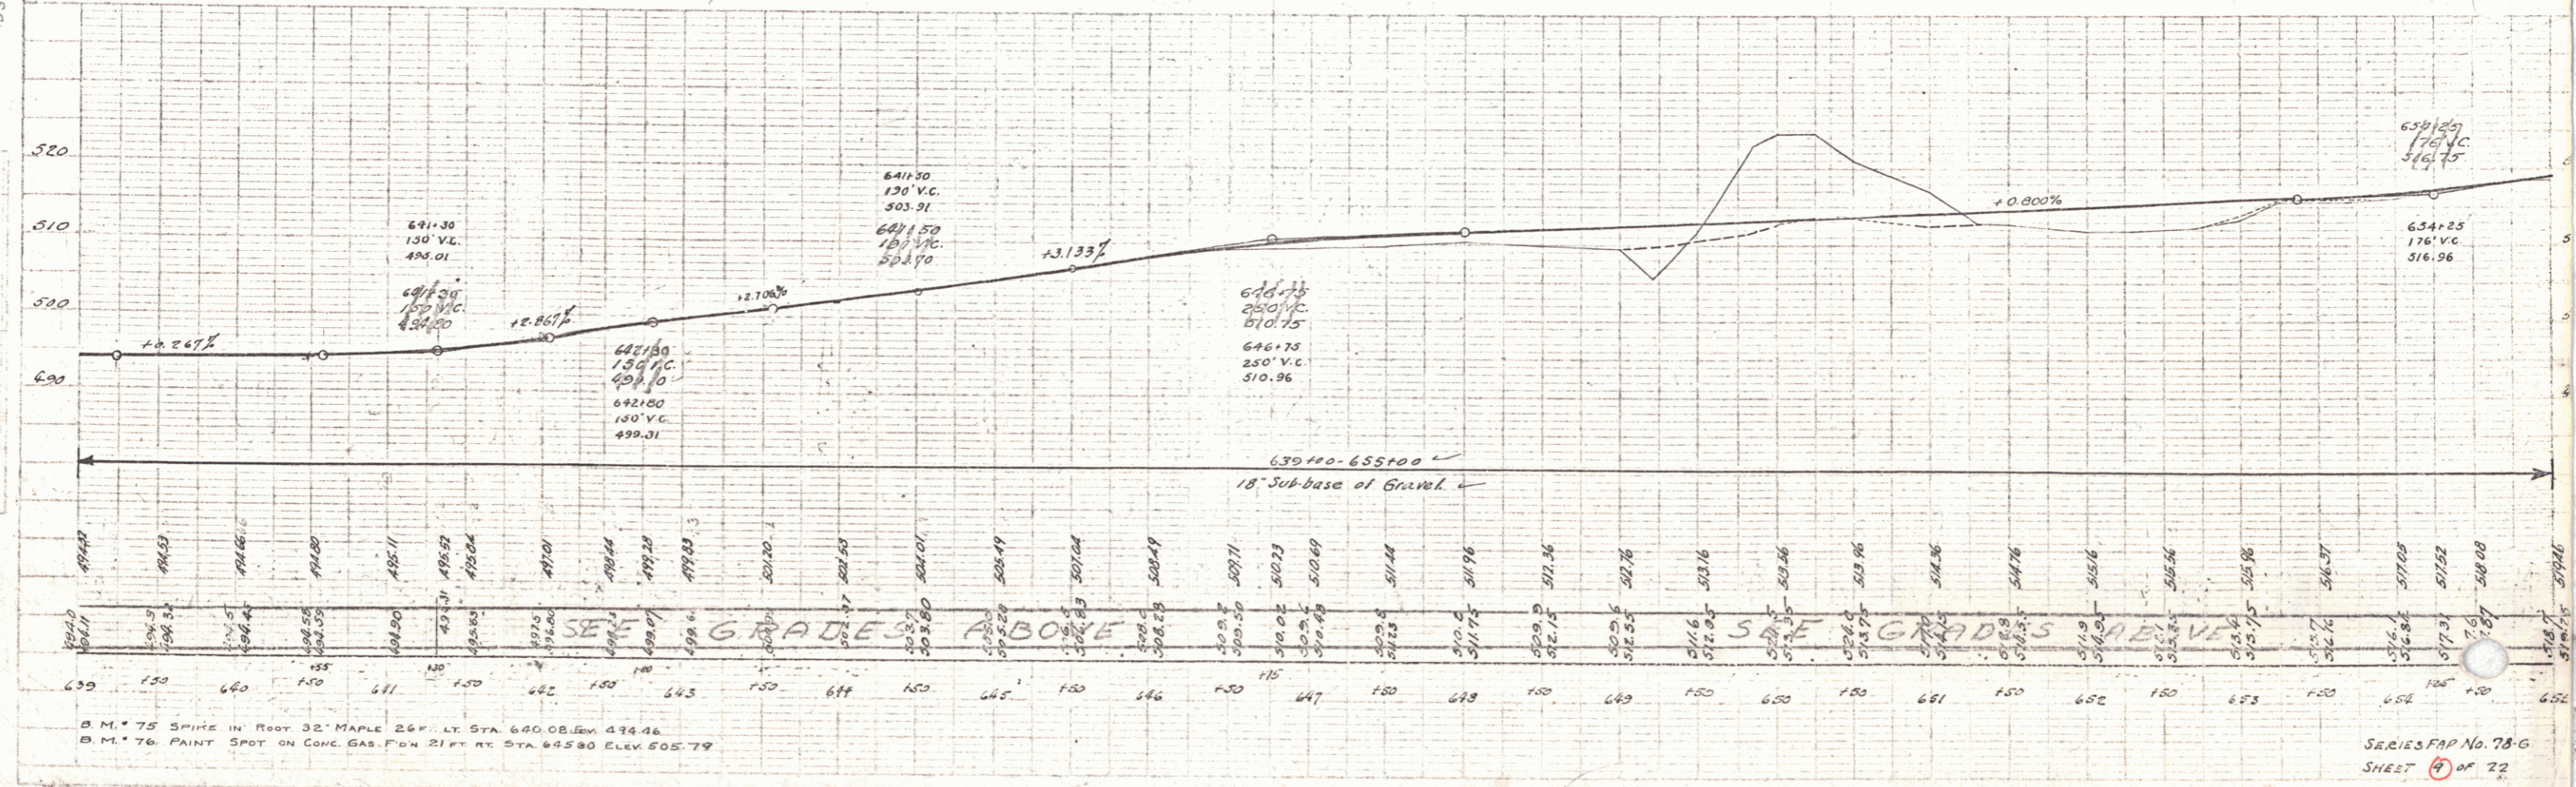

B.M. 75 SPIKE IN ROOT 32' MAPLE 26' LT. STA. 640.08 ELEV. 474.46
 B.M. 76 PAINT SPOT ON CONC. GAS. FOR 21' RT. STA. 645.80 ELEV. 505.79

SERIES FAP No. 78-G
 SHEET 22 OF 22

8