

**BRIDGE NOTES:-**  
 Station 653+77.8-656+00  
 Station 656+91.3-657+13.8  
 Concrete slab with gravity abutments  
 Length overall 230.07  
 Clear span 200.00  
 Roadway width 20.00  
 Constructed as F.T.R.-12F-1928  
 Very good condition  
 To be retained  
 Not to be included in length of Project

**FAP 780**  
 Cable Guard Rail



Station	Station	LT	RT
666+14	671+00	415	1

**FAP 780**  
 Wood Guard Rail

Station	Station	LT	RT
660+1	663+7	1	1

**FAP 780**  
 Code Book Roll (RESET)

Station	Station	LT	RT
655+24	655+72	1	1
657+62	657+72	1	1
658+00	658+00	1	1
658+50	658+50	1	1
658+57	658+57	1	1
657+11	658+62	136	1
657+11	657+62	1	1

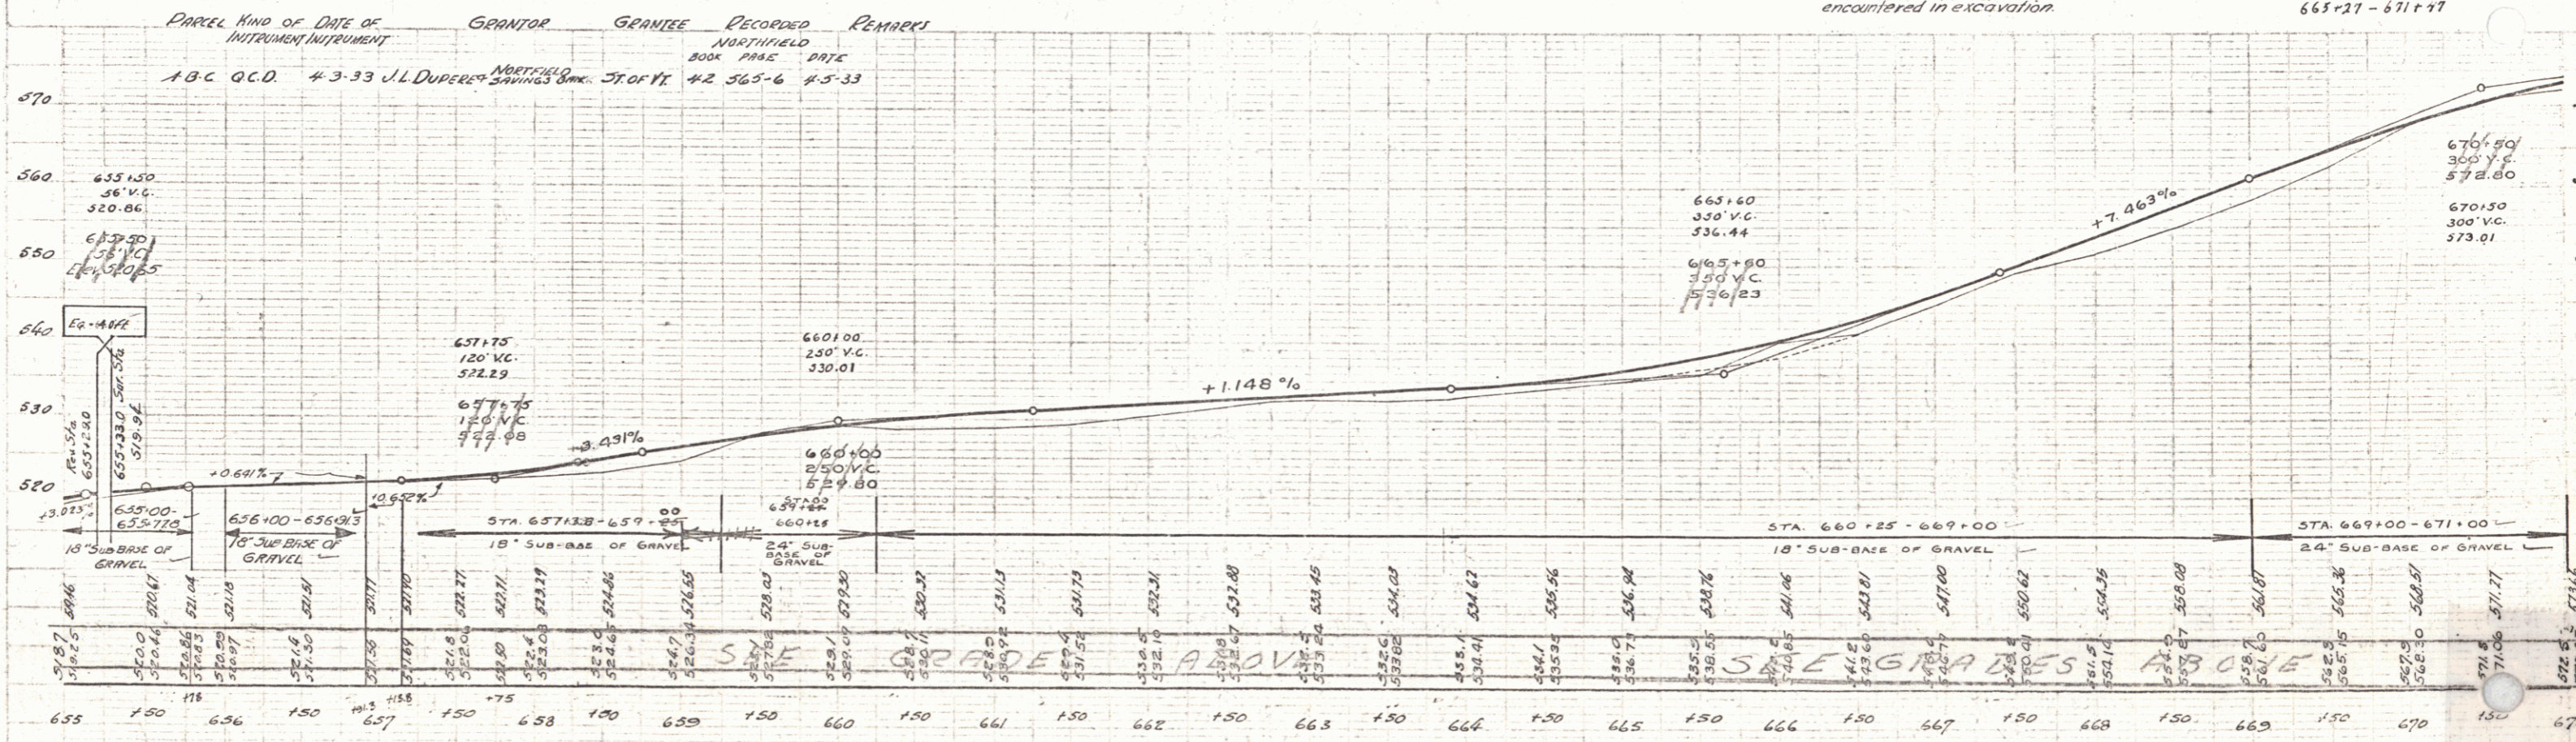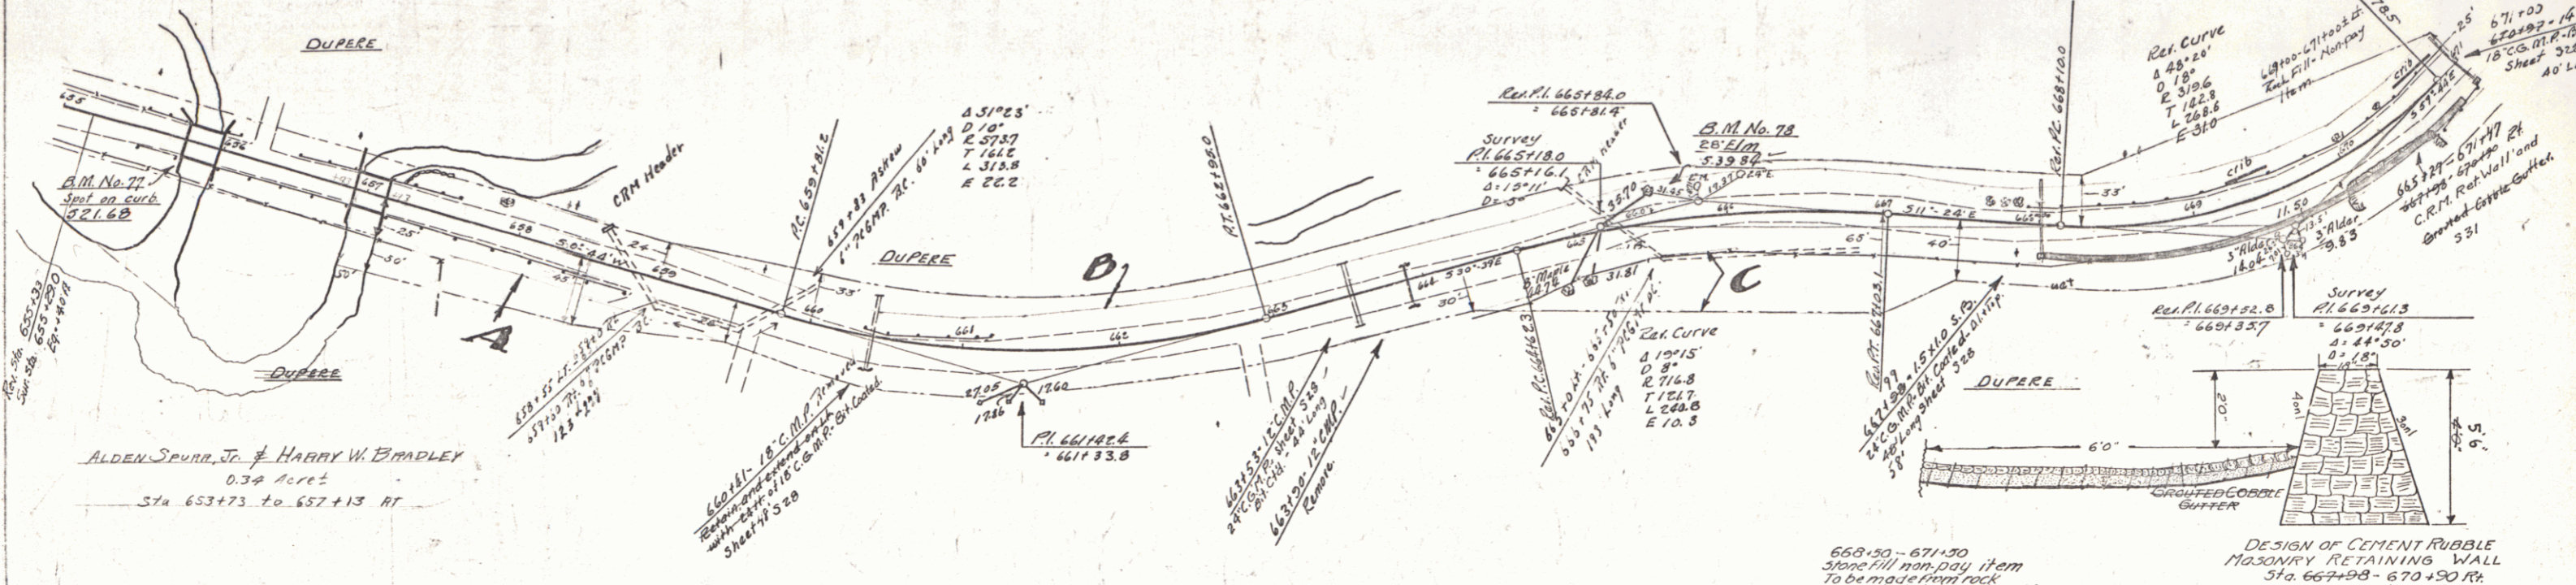

18" x 77" PAINT SPOT ON CONC. BRIDGE RAIL 10 FT RT STA. 655+77.8 ELEV. 521.68  
 18" x 78" SPINE IN ROOF 28' ELM. 26 FT LT STA. 665+48 ELEV. 539.88

SERIES FAP No. 78-G  
 SHEET 10 OF 22