



| FAP 78G |            |     |    |         |
|---------|------------|-----|----|---------|
| STATION | INSTRUMENT | LT  | RT | REMARKS |
| 676+00  | 68000      | 488 |    |         |
| 683+10  | 68700      | 370 |    |         |

| FAP 78G |            |    |    |         |
|---------|------------|----|----|---------|
| STATION | INSTRUMENT | LT | RT | REMARKS |
| 676+33  |            |    |    |         |
| 677+15  |            |    |    |         |
| 684+33  |            |    |    |         |

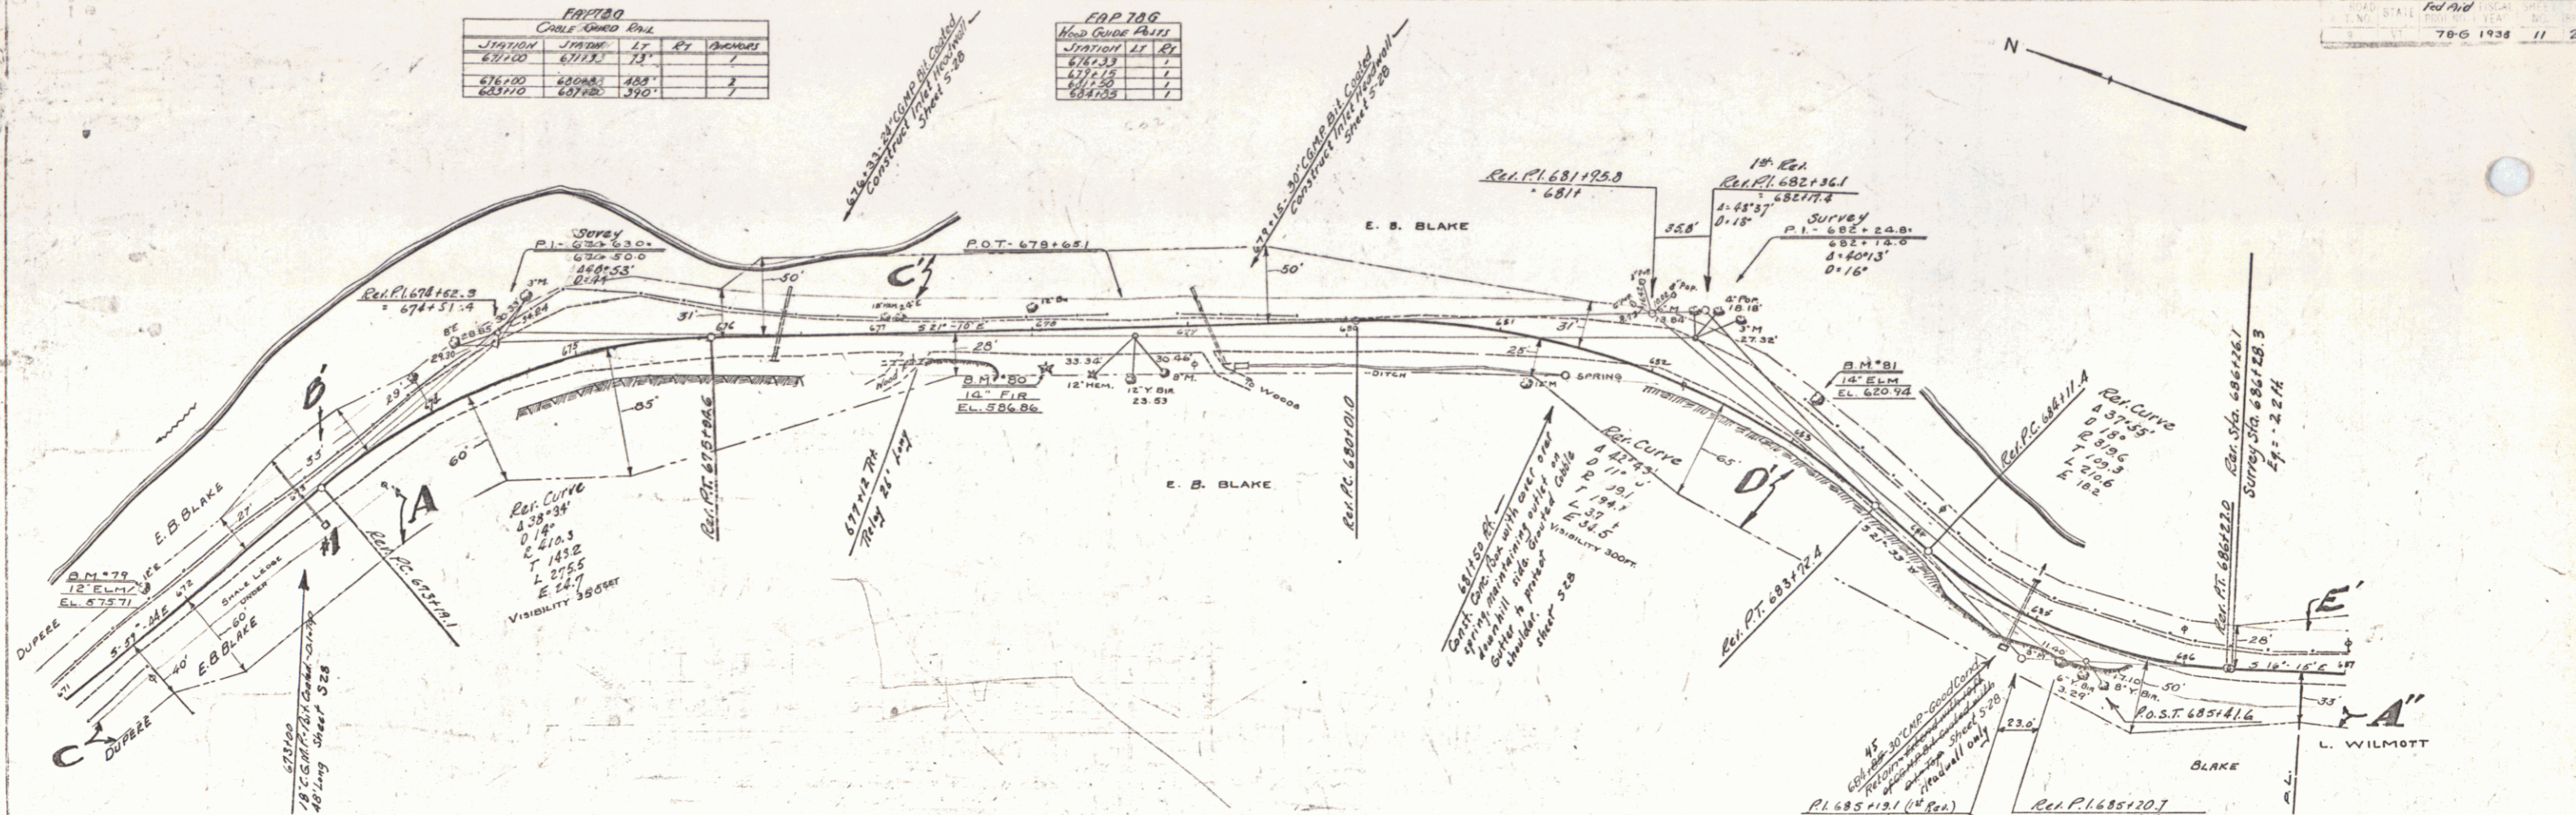

| PARCEL      | KIND OF INSTRUMENT | DATE OF INSTRUMENT | GRANTOR                              | GRANTEE                 | BRITISH RECORD | REMARKS          |
|-------------|--------------------|--------------------|--------------------------------------|-------------------------|----------------|------------------|
| A B C       | Q.C.D.             | 4-3-33             | J.L. DUPRE & NORTHFIELD SHIMMUS BANK | NORTHFIELD SHIMMUS BANK | 42 565-6       | 4-5-33 CUL. STA. |
| A' B' C'    | Q.C.D.             | 4-4-33             | E.B. BLAKE & G.E. BAILEY             | G.E. BAILEY             | 42 563-4       | 4-5-33 21 673+00 |
| A'' B'' C'' | Q.C.D.             | 4-3-33             | L.J. WILMOTT & G.E. BAILEY           | G.E. BAILEY             | 42 567-8       | 4-5-33 42 670+43 |

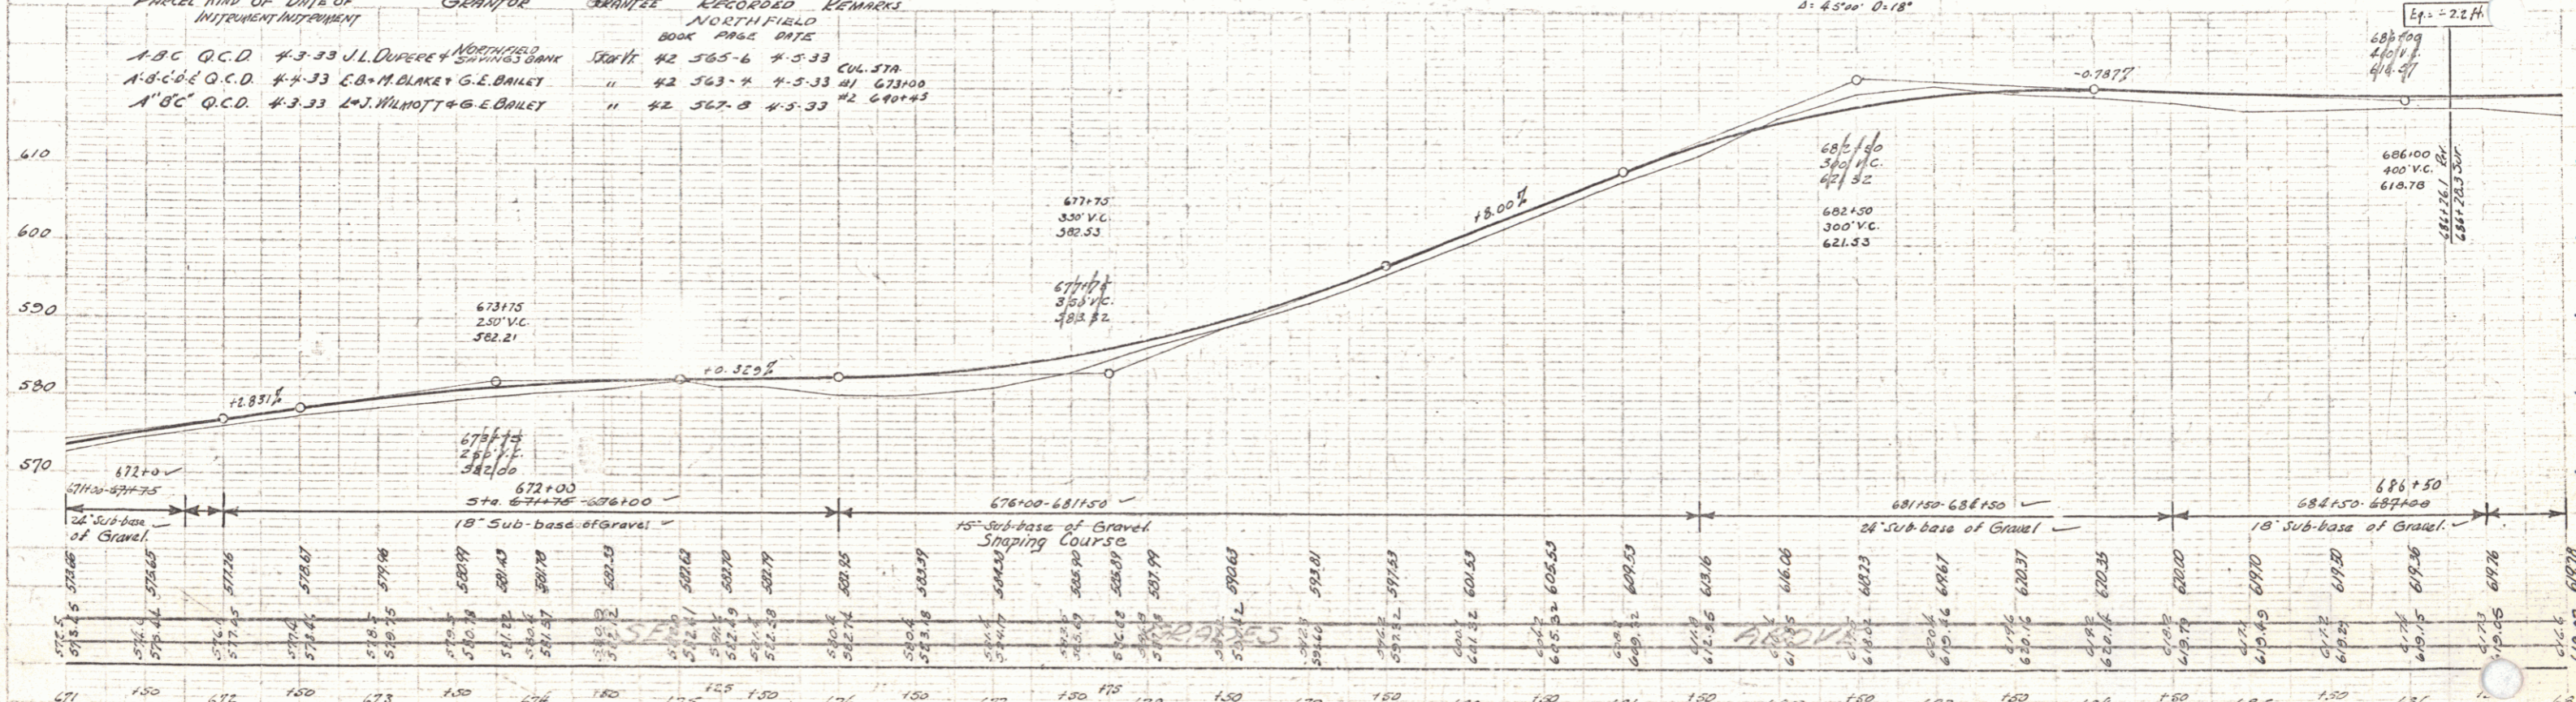

B.M. 79 SPIKE IN TRUNK 12' ELM 19 FT. LT. STA. 671+37 ELEV. 575.71  
 B.M. 80 SPIKE IN ROOT 10' FIR 25 FT. RT. STA. 678+07 ELEV. 508.86  
 B.M. 81 SPIKE IN TRUNK 10' ELM 20 FT. LT. STA. 683+00 ELEV. 620.98

SERIES FAP No. 78-G  
 SHEET 11 OF 22