


STATION	CHANG	LT	STATION	CHANG	LT
691.00	0.0	-	692.00	1.0	-
691.50	0.0	-	692.50	1.0	-
692.00	0.0	-	692.50	0.0	-

STATION	CHANG	LT	STATION	CHANG	LT
691.00	0.0	-	692.00	1.0	-
691.50	0.0	-	692.50	1.0	-
692.00	0.0	-	692.50	0.0	-

STATION	CHANG	LT	STATION	CHANG	LT
691.00	0.0	-	692.00	1.0	-
691.50	0.0	-	692.50	1.0	-
692.00	0.0	-	692.50	0.0	-

PLAN  
 DATE: 8/12/32  
 BY: B. BLAKE  
 CHECKED: H. BLAKE  
 TITLE: ROAD RECONSTRUCTION  
 SHEET NO. 12 OF 22

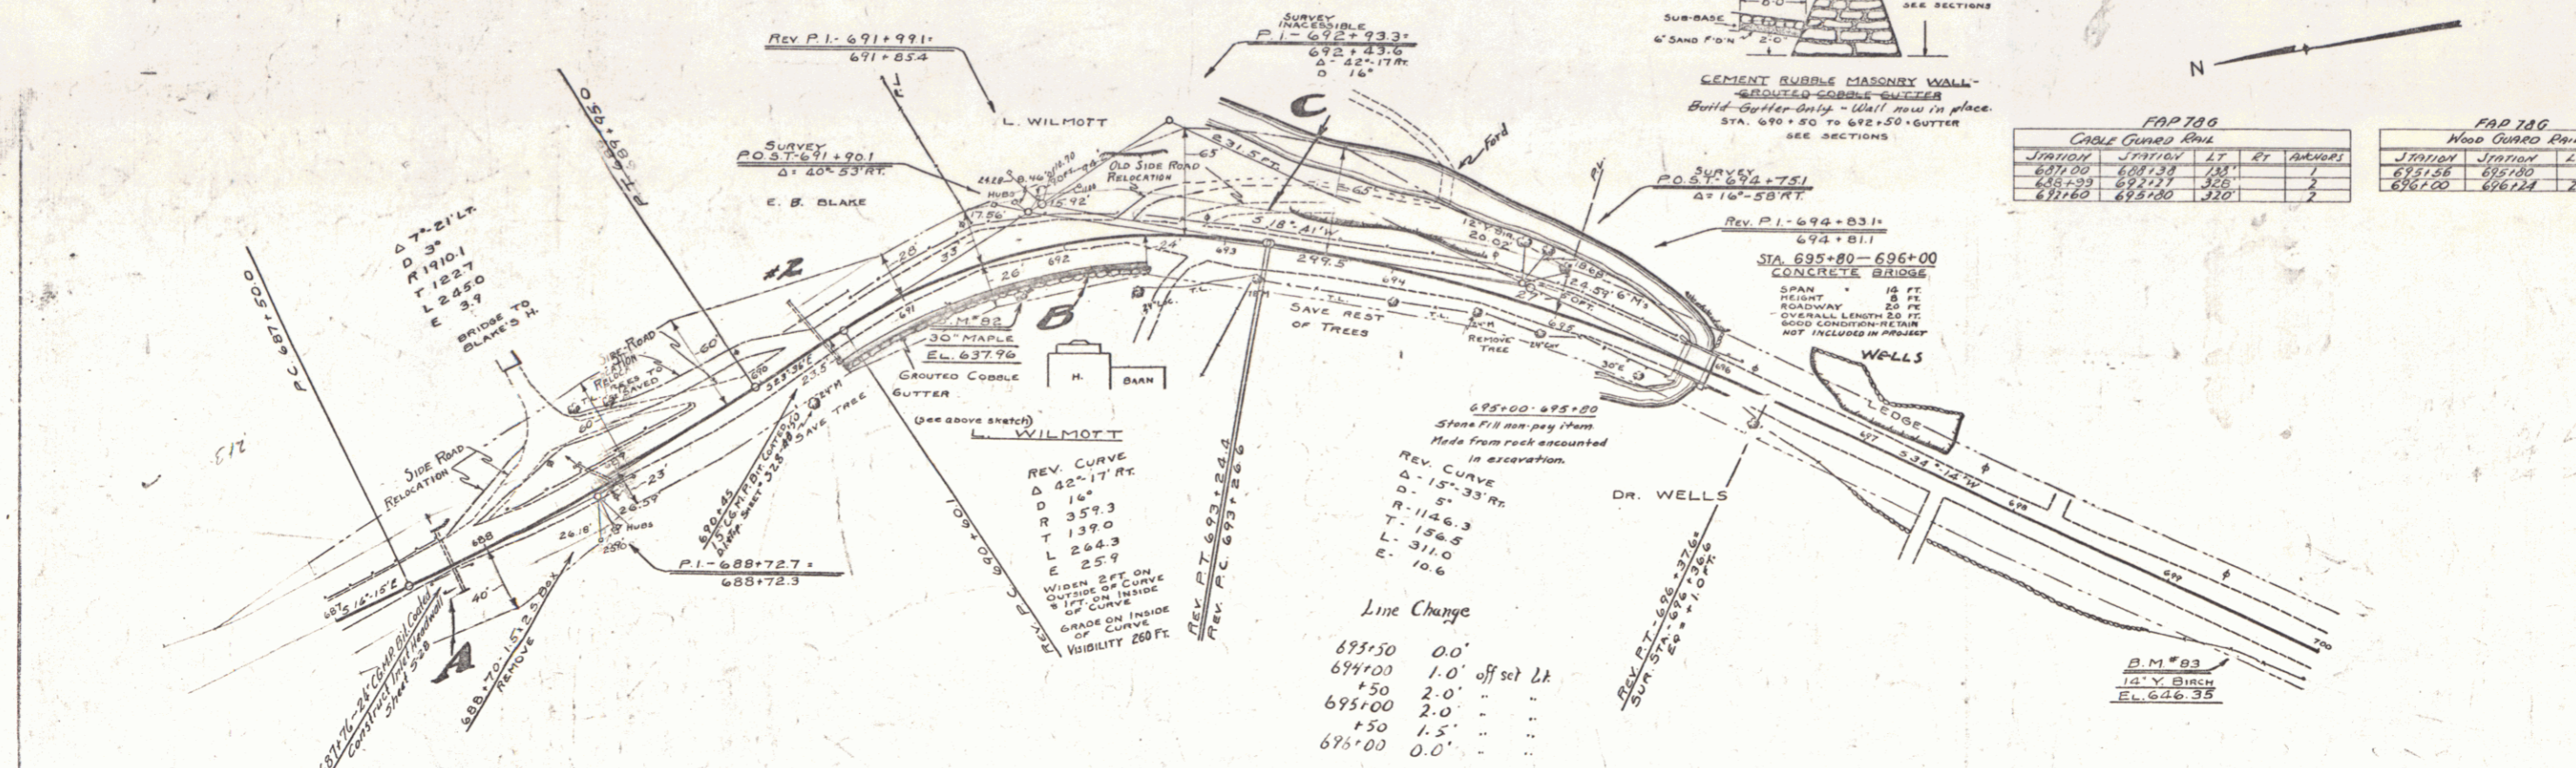

PARCEL	NO.	DATE OF INSTRUMENT	GRANTOR	GRANTEE	RECORDED	REMARKS
A	Q.C.D.	4-3-33	L. & J. WILMOTT & G. E. BAILEY	ST. 11	BOOK 4875	P. 117
B	Q.C.D.	4-4-33	E. B. & H. BLAKE & G. E. BAILEY	"	42 563-4	4-5-33 GR. 11-5

