


DESIGN OF REINFORCED CONCRETE CLASS A RETAINING WALL  
Sta. 700+00 - Sta. 701+30

FAP 188			
WOOD GRADE P.W.			
STATION	STATION	LT	RT
701+30	703+30	100'	100'
703+30	705+30	200'	200'

FAP 186			
WOOD GRADE P.W.			
STATION	STATION	LT	RT
701+30	703+30	100'	100'
703+30	705+30	200'	200'

70-G 1938 13

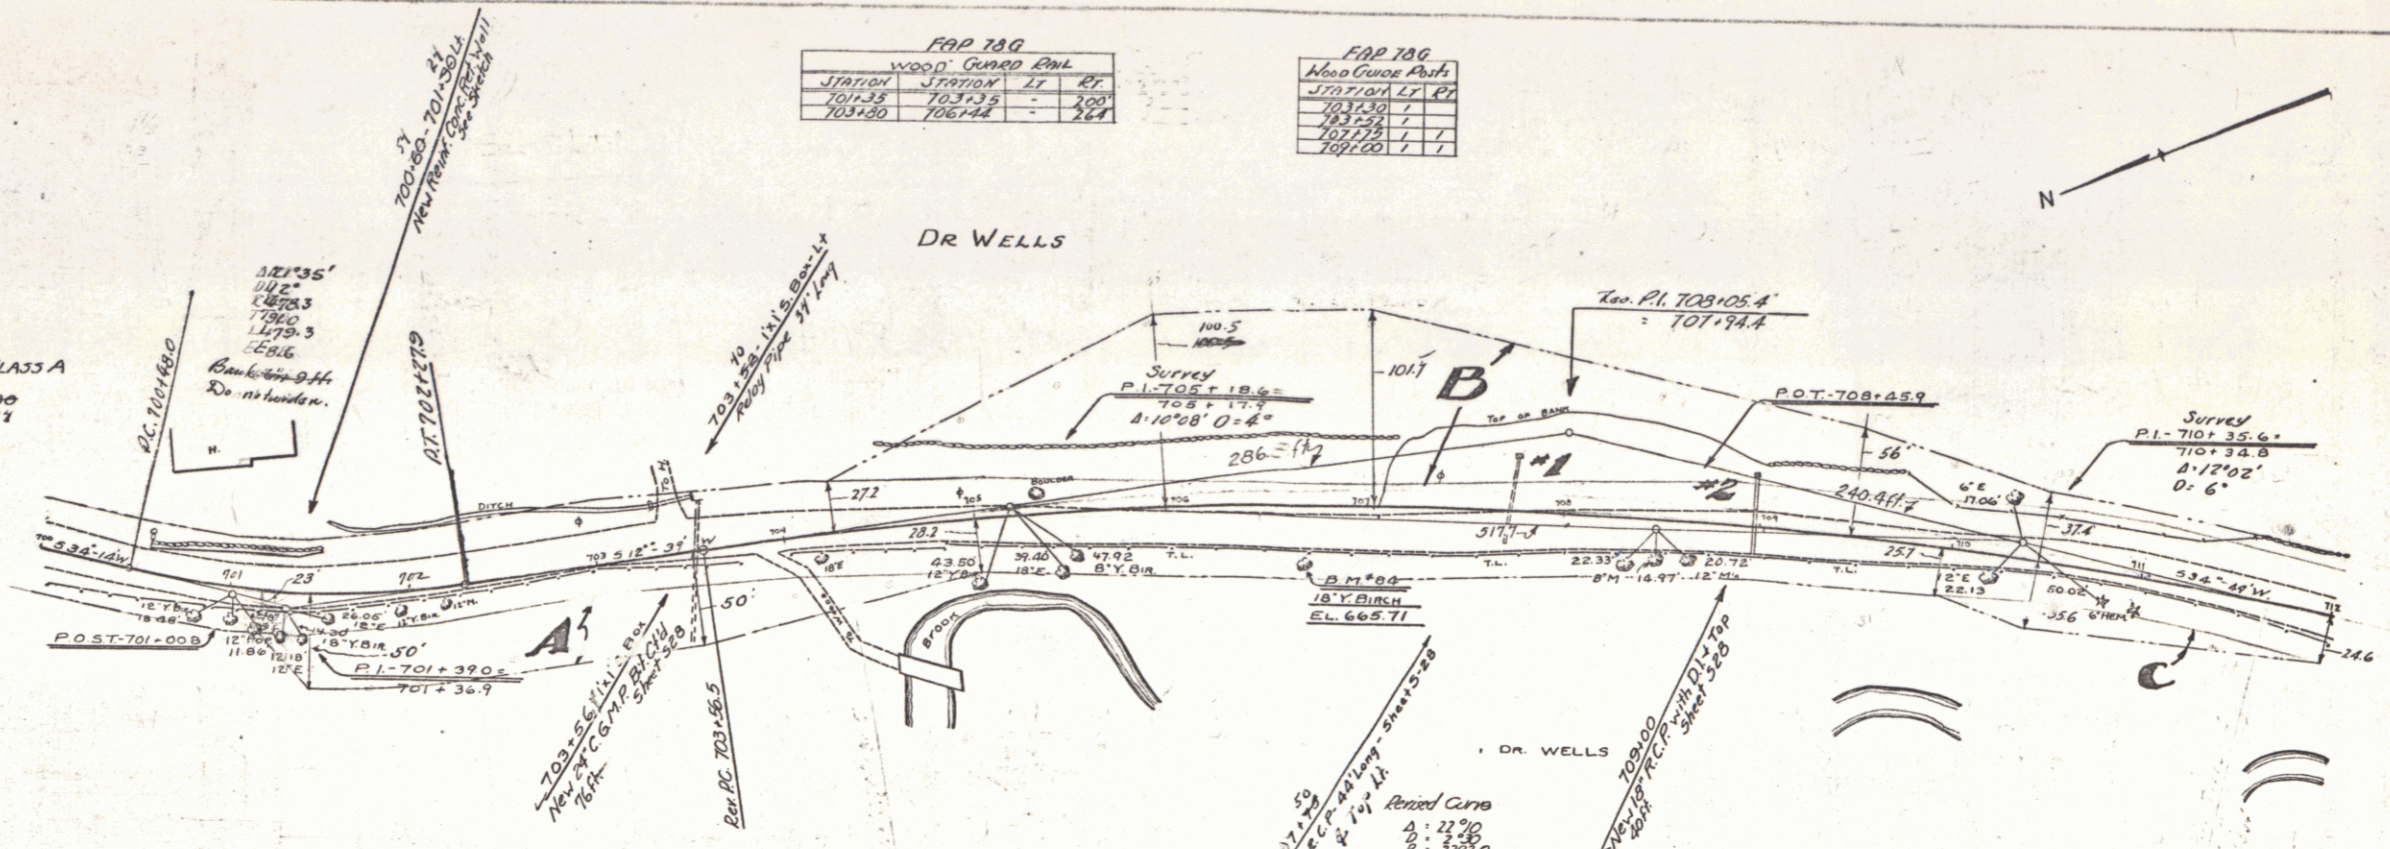


701+30-702+95  
Stones Fill non-pay item.  
Made from rock excavation encountered  
in excavation.

PARCEL KIND OF DRIVE OF  
INTEREST INSTRUMENT  
A-B-C H.D. 9-9-33 E.R. WELLS

GRANTEE RECORDS REMARKS  
NORTHFIELD  
BOOK PAGE DATE CUL. #1+2  
ST. 46 584-5 9-15-33 707125 707100

PLAN	DATE	BY
	7/32	
DESIGNED BY		
CHECKED BY		
APPROVED BY		

PROFILE	DATE	BY
	7/32	
DESIGNED BY		
CHECKED BY		
APPROVED BY		

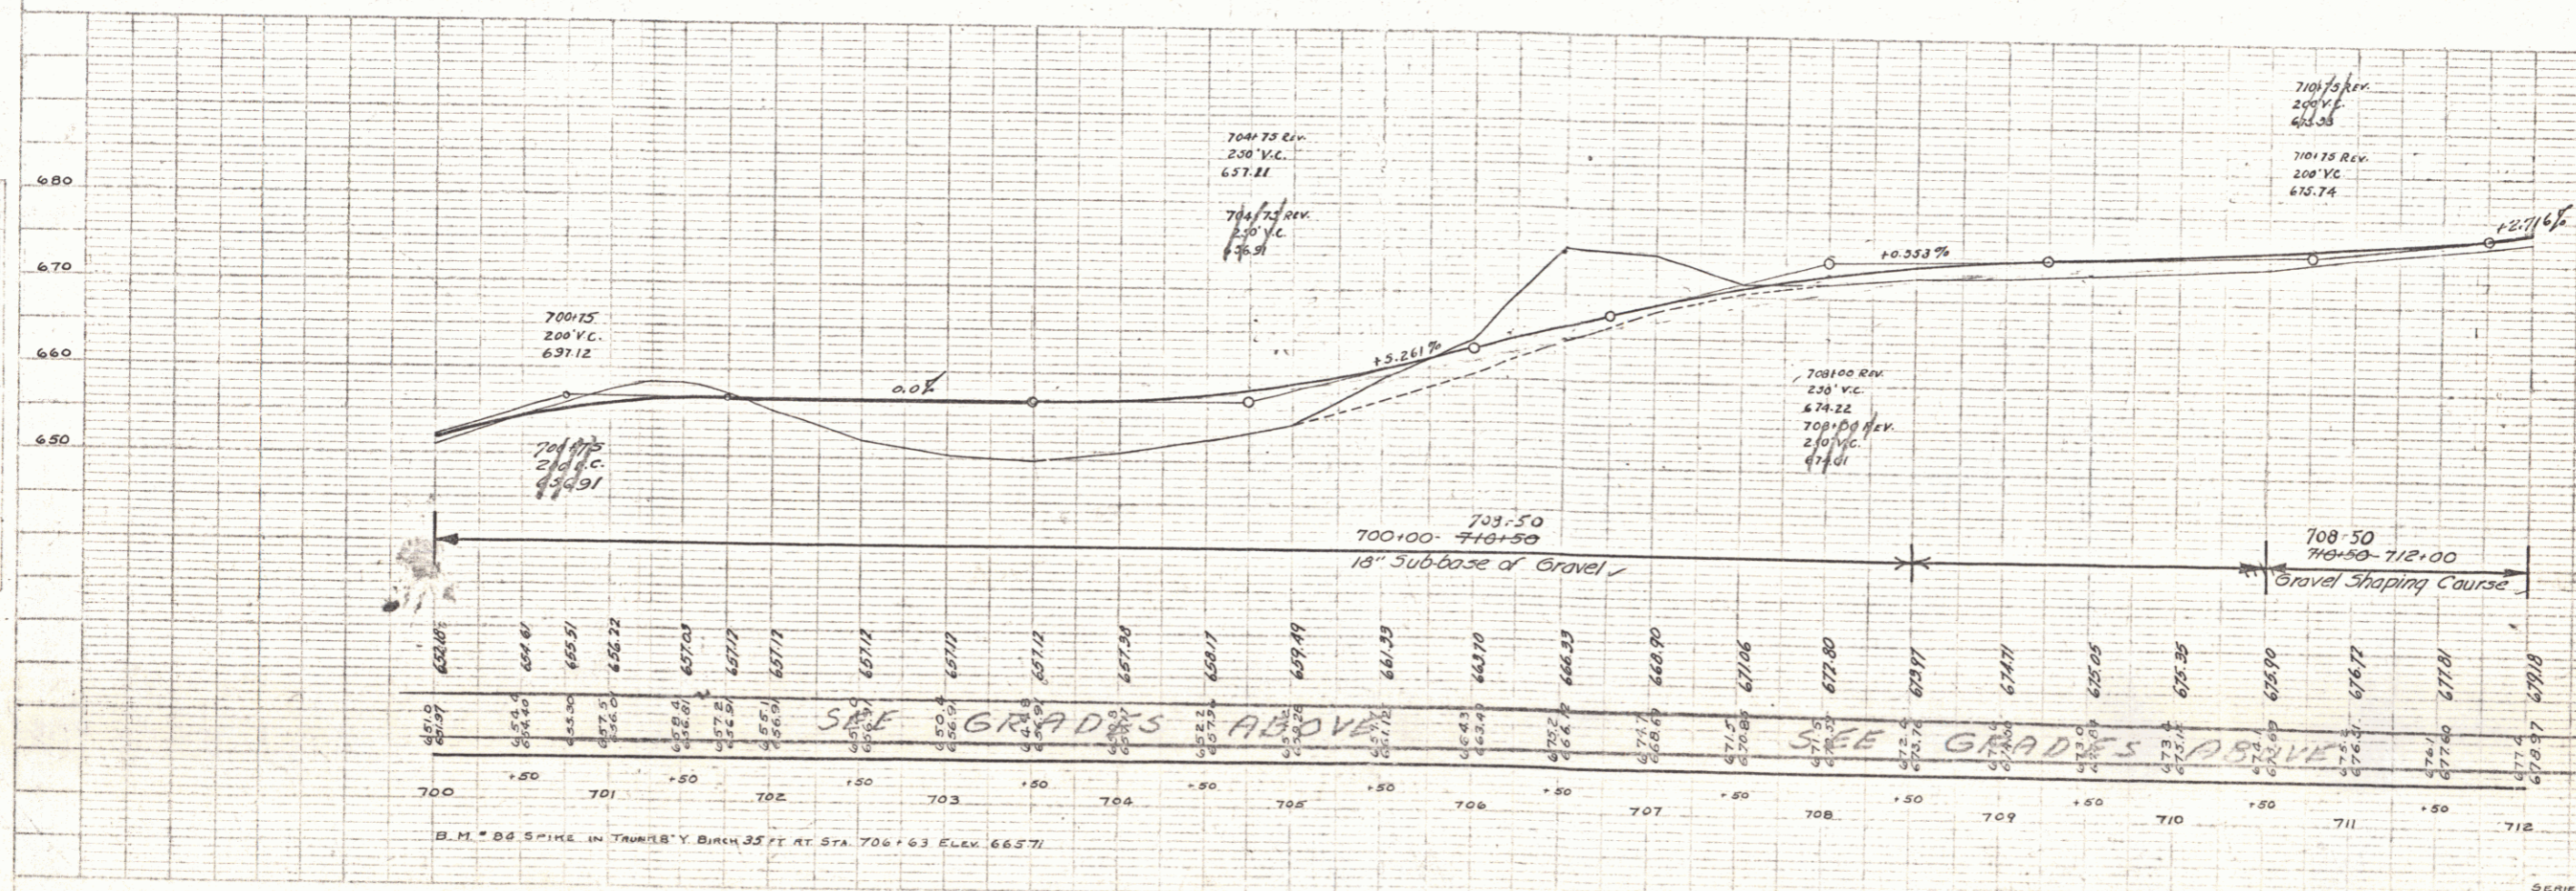

B.M. 80 SPIKE IN TRUNK Y. BIRCH 35' E AT STA. 700+63 ELEV. 665.71

SERIES FAP No 78-G  
SHEET 13 OF 22

12