

EAP 280

STA	STA	LT	LT
731+75	733+01	216	
737+10		2*	
740+37		2*	

EAP 780


STA	LT	LT
728+27	1	1
732+30	1	
737+10	1	
740+37	1	
730+00	G	

-NOTE-
LT. 729-732 BOULDERS
ENCOUNTERED IN EXCAV.
TO BE USED RT. 729-730.

-NOTE-
734-736 LT. LEDGE EXCAV.
TO BE USED IN ROCK FILL
732-735 Rockfills
non-pay item

-NOTE-
739-740 LT. LEDGE EXCAV.
TO BE USED IN ROCK FILL
732-735
Stonefill non pay item
Made from rock encountered
in excavation.

Parcel	Kind of Instrument	Date of Instrument	Grantor	Grantee	Recorded	Remarks
A-B-C	Q.C.D.	8-29-33	ROGER S. & ABRAHAM DROUGHT	JR. & IT.	42 575-6-7	9-15-33
A'	Q.C.D.	8-30-33	R.D. DUFFANY	"	42 571-2	9-15-33
A''	Q.C.D.	8-30-33	GEO. & J. JERRY	"	42 569-70	9-15-33
A'''	Q.C.D.	8-30-33	GEO. & J. JERRY	"	22 472	10-11-33
A''''	Q.C.D.	8-30-33	R.P. DUFFANY	"	22 470	10-11-33

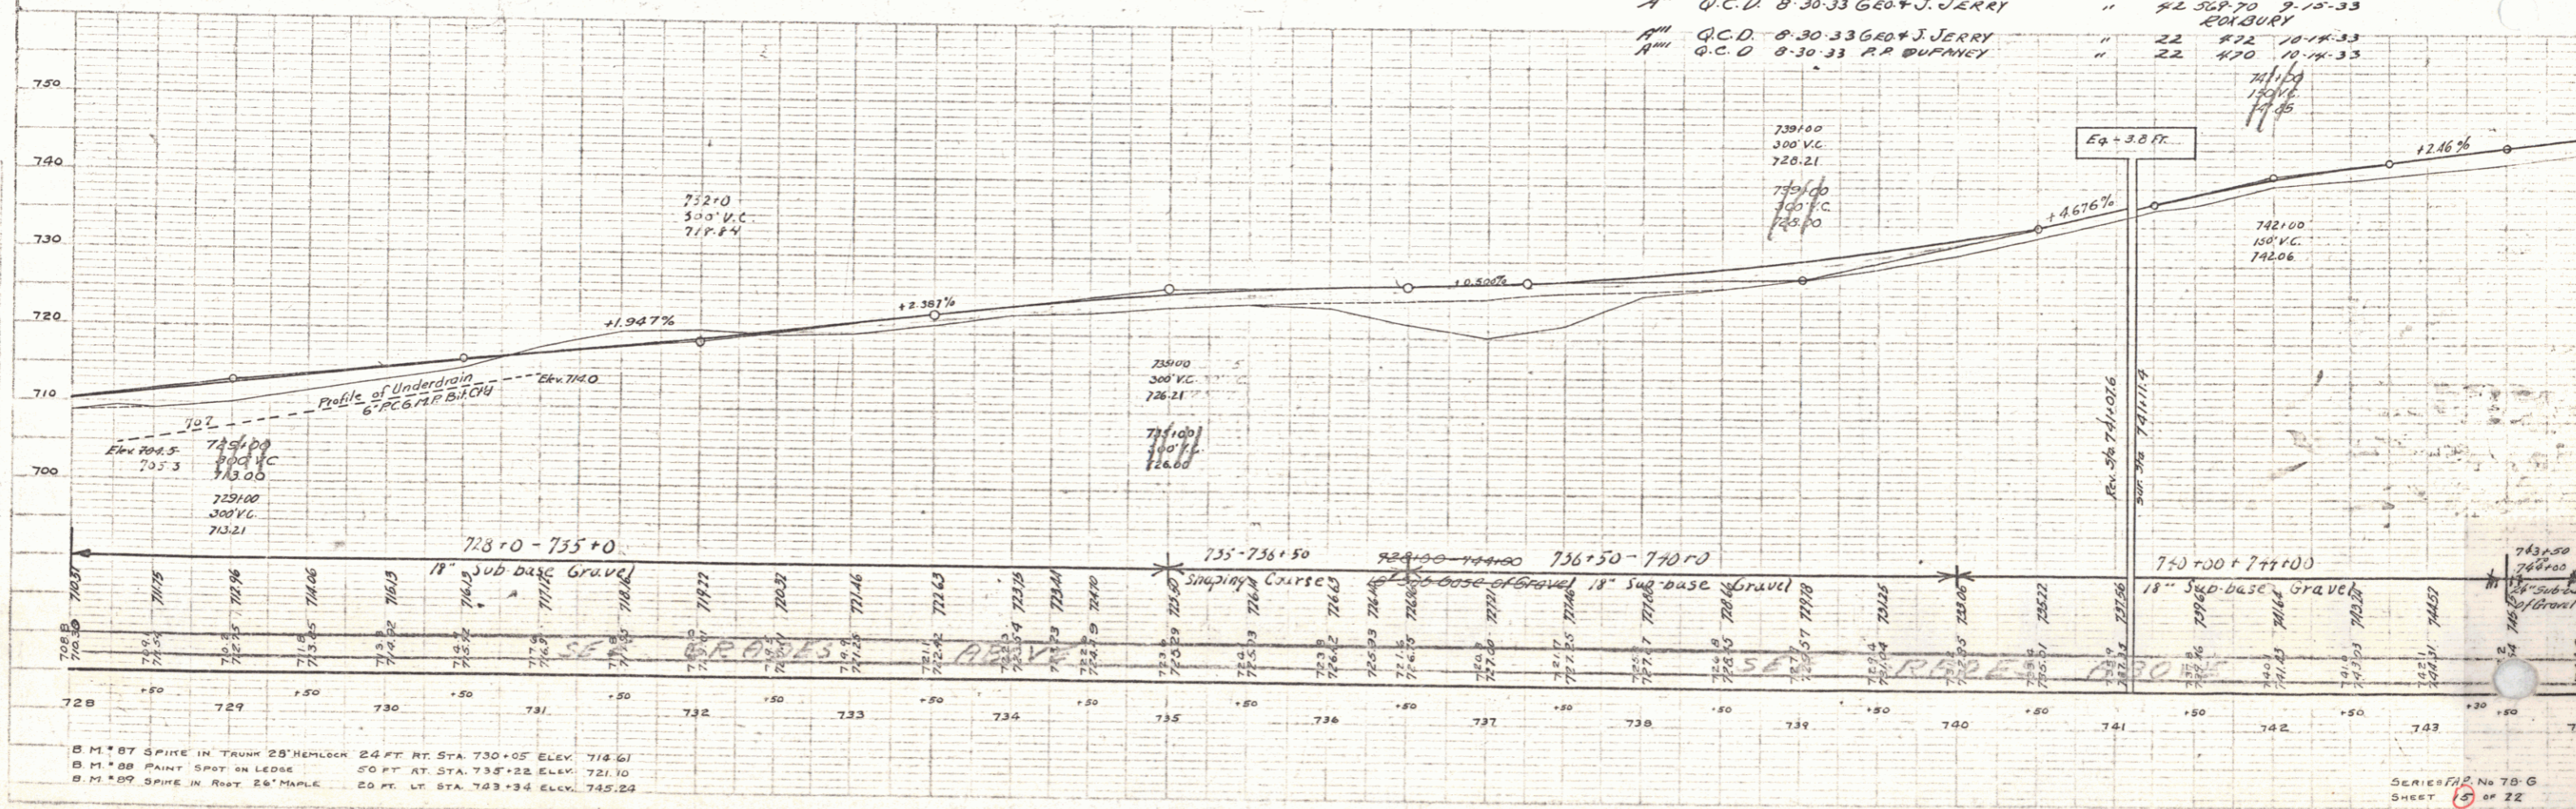

B.M. 87 SPIKE IN TRUNK 28' HEMLOCK 24 FT. RT. STA. 730+05 ELEV. 714.61
 B.M. 88 PAINT SPOT ON LEDGE 20 FT. AT STA. 735+22 ELEV. 721.10
 B.M. 89 SPIKE IN ROOT 26' MAPLE 20 FT. LT. STA. 743+34 ELEV. 745.24

SERIES No. 75-G
SHEET 12 OF 22

4