

NOTE
776+00 - 778+00 Excavation to be used in Rock Fill on R/W 765+00 to 767+00 Stone Fill from pay item

FAP 786			
STA.	RT.	LT.	
782+00	782+00	24	
785+00	785+00	24	
785+00	787+00	152	

FAP 787			
STA.	RT.	LT.	
781+12	1	1	
784+04	1	1	
787+10	1	1	


NOTE
782+00 - 789+00 Ledge excavated to be used in Rock Fill on R/W 765+00 to 767+00

NOTE
785+00 - 789+00 Ledge excavated to be used as needed at the Rock Fills as shown on layout.


FEDERAL ROAD DIST. NO. 1131 LOCAL SHEET TOTAL 140 SHEETS
78-G-1930 18 22

PLAN	DATE	BY	CHECKED

PROFILE	DATE	BY	CHECKED

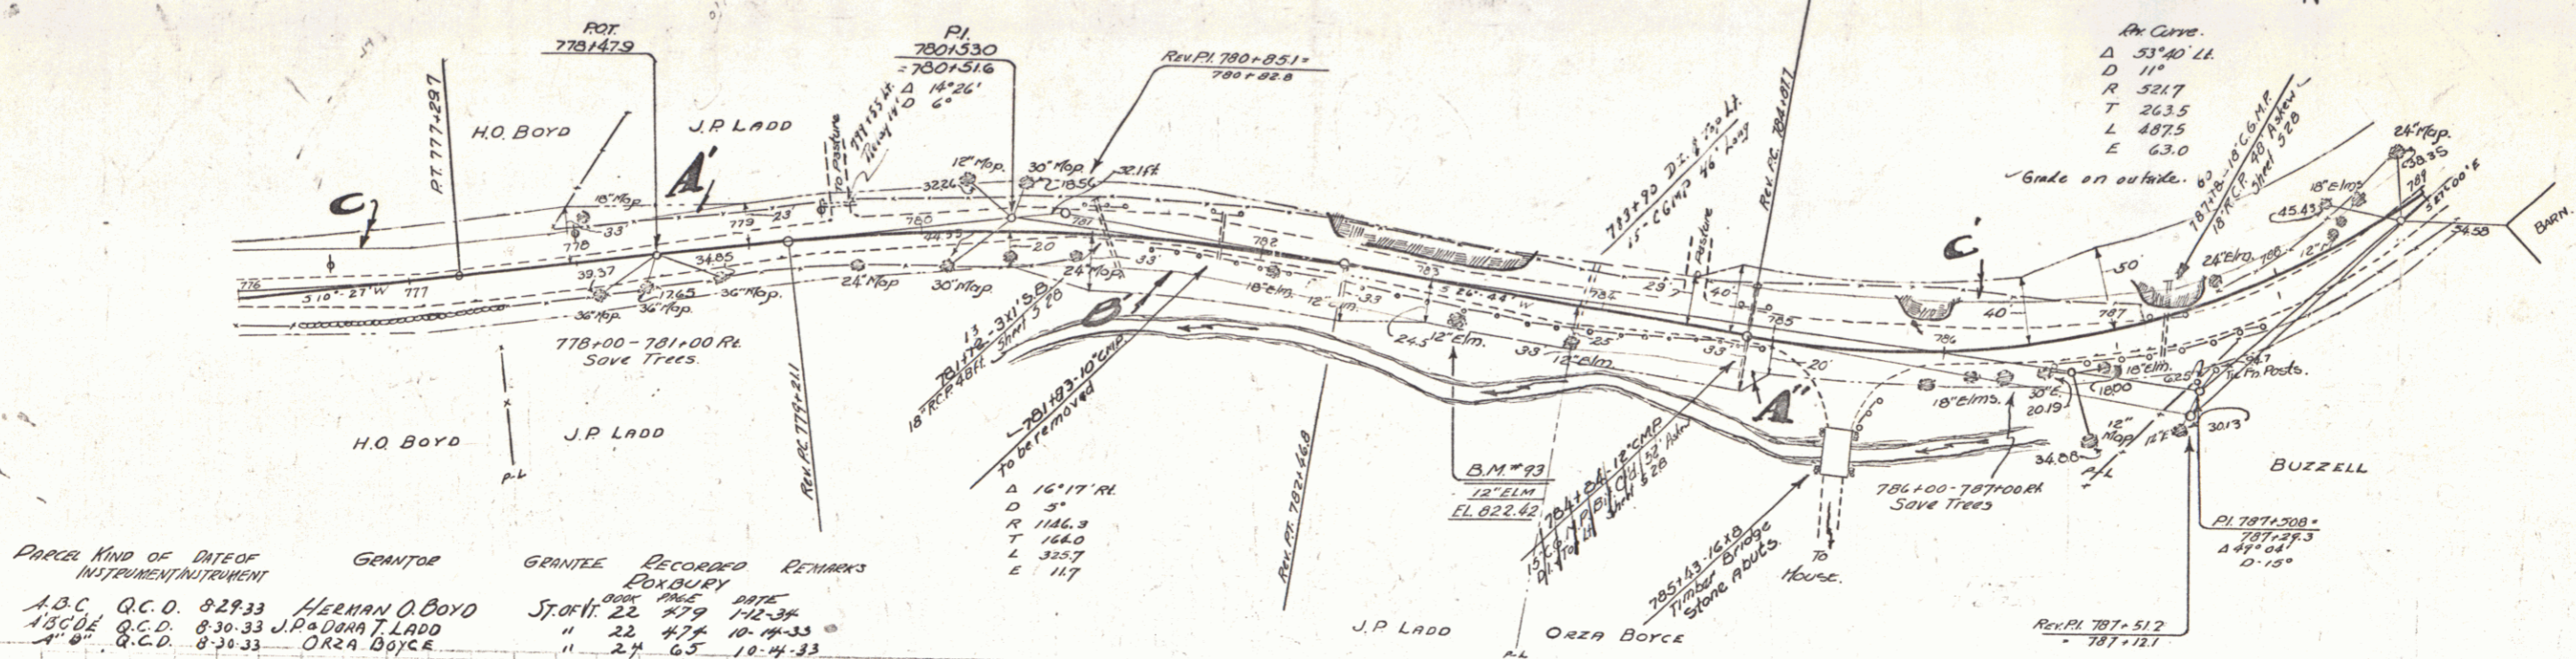

PARCEL	KIND OF INSTRUMENT	DATE OF INSTRUMENT	GRANTEE	GRANTEE	RECORDED	REMARKS
A.B.C.	Q.C.D.	8-29-33	HEERMAN O. BOYD	ST. OF T.	22	579 1-12-34
1500E	Q.C.D.	8-30-33	J.P. ADAMA LADD	"	22	474 10-14-33
A"	Q.C.D.	8-30-33	ORZA BOYCE	"	24	65 10-4-33

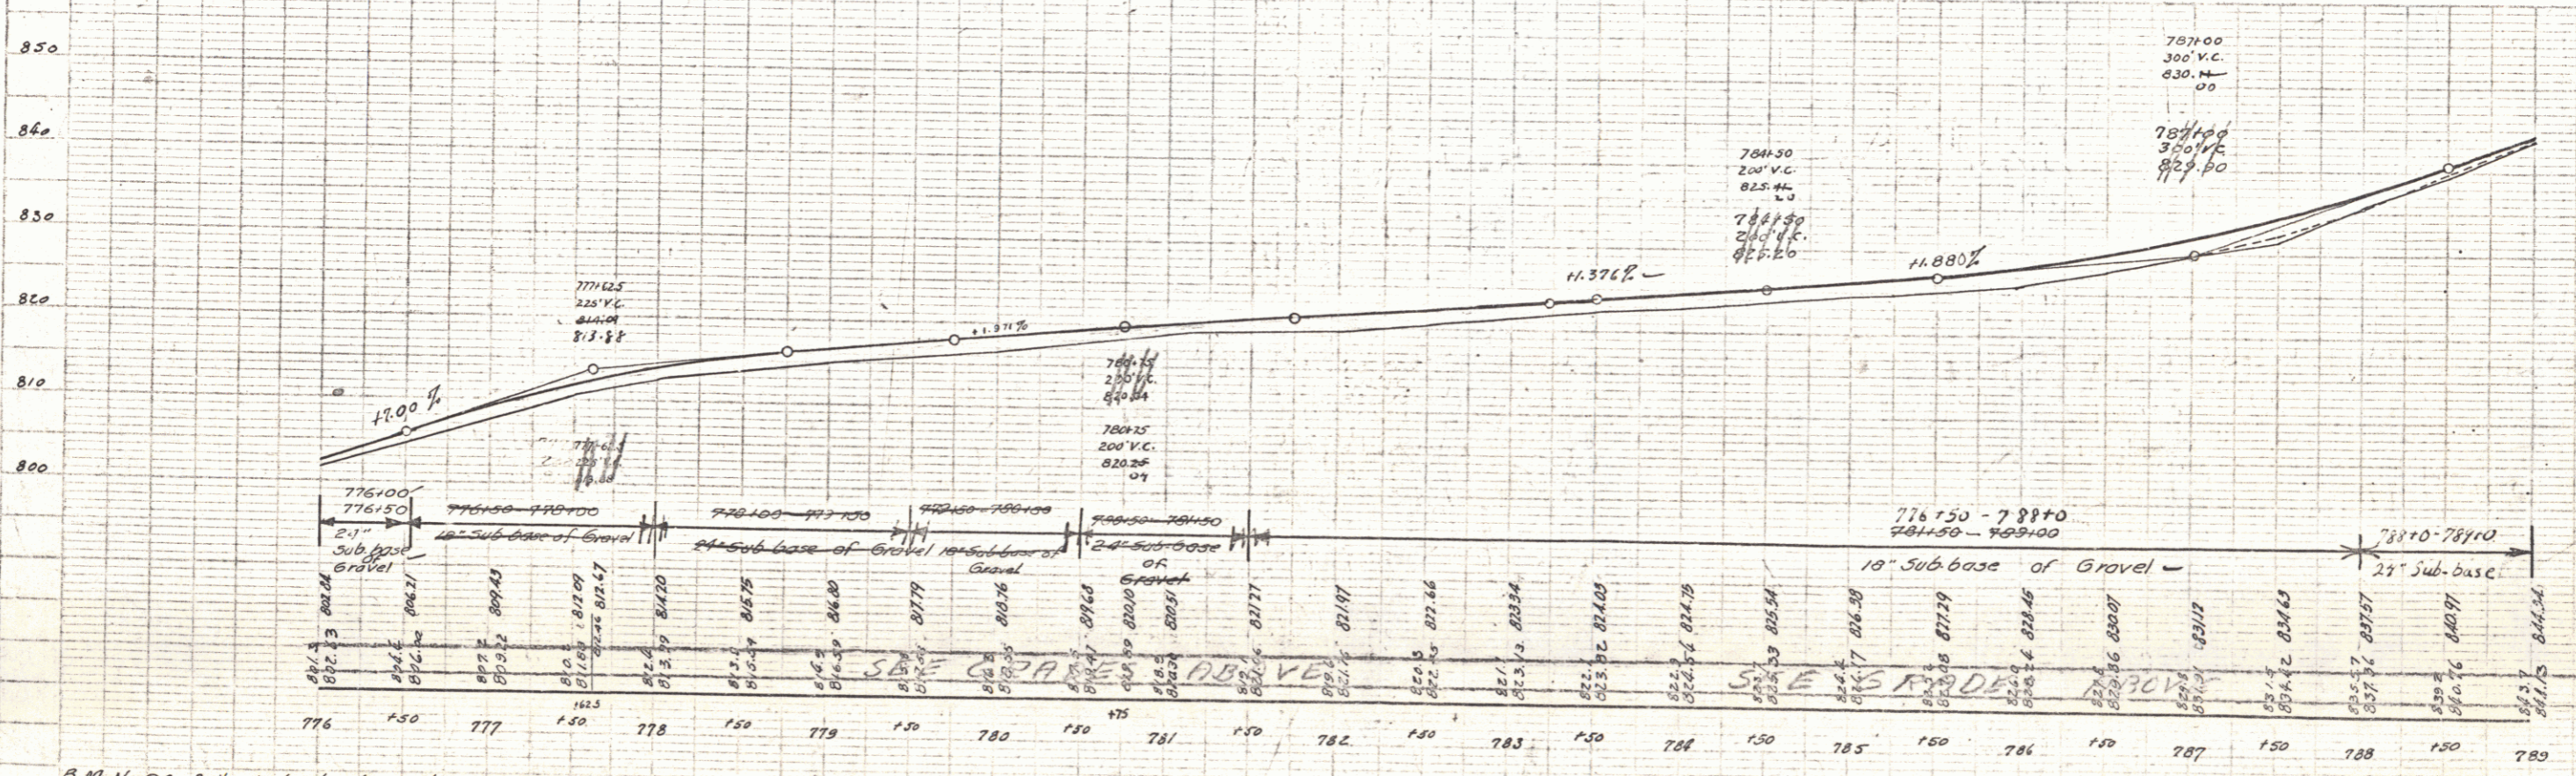

B.M. No. 93. Spike in front of 12' Elm right of Sta. 783+10. Elev. 822.66

SERIES FAP No. 786
SHEET 18 OF 22