

INDEX OF SHEETS

SHEET NO.	TITLE PAGE
" 1	GENERAL CROSS-SECTION OF IMPROVEMENT ONE COURSE CEMENT CONCRETE PAVEMENT.
" 2	DETAILS OF CONSTRUCTION
" 3	PLAN AND PROFILE STA. 323+00-478+00
" 4	STAND. STRUCTURES SHEET S-20 PIPE CULVERTS
" 5	" " " S-21 BOX CULVERTS
" 6	" " " S-22 GUARD RAIL ETC. CURB GUTTER ETC.
" 7	CULVERT CROSS SECTION SHEETS
" 8	CROSS SECTION SHEETS STA. 323+00-478+00

FED. ROAD DIST. NO.	STATE	FED. AID PROJ. NO.	FISCAL YEAR	SHEET NO.	TOTAL SHEETS
9	VT.	78-L-1530	1	57	

STATE OF VERMONT
STATE HIGHWAY DEPARTMENT

PLAN AND PROFILE OF PROPOSED
STATE HIGHWAY

FEDERAL AID PROJECT


Pin# 99R 994

TOWNS OF BERLIN-NORTHFIELD

MONTPELIER-NORTHFIELD ROAD Ke VT 12

FROM A POINT 250 FT. SOUTH OF HOUSE OF
MRS. W.L. PEAKE SOUTHERLY TO A POINT 1,006.5 FT.
SOUTH OF BRIDGE OVER DOG RIVER.


LENGTH OF PROJECT 15,238.1 FT.=2.886 MILES.

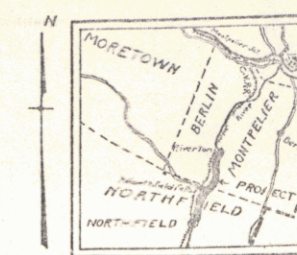

SCALE 1 IN. = 4 MI.

(To Be Returned To R.O.W. Division)
Town of VT 12
PERPETUAL
TOWN FILE
RIGHT-OF-WAY DIVISION

RIGHT-OF-WAY DIVISION
TOWN FILE
PERPETUAL
Town of VT 12
(To Be Returned To R.O.W. Division)

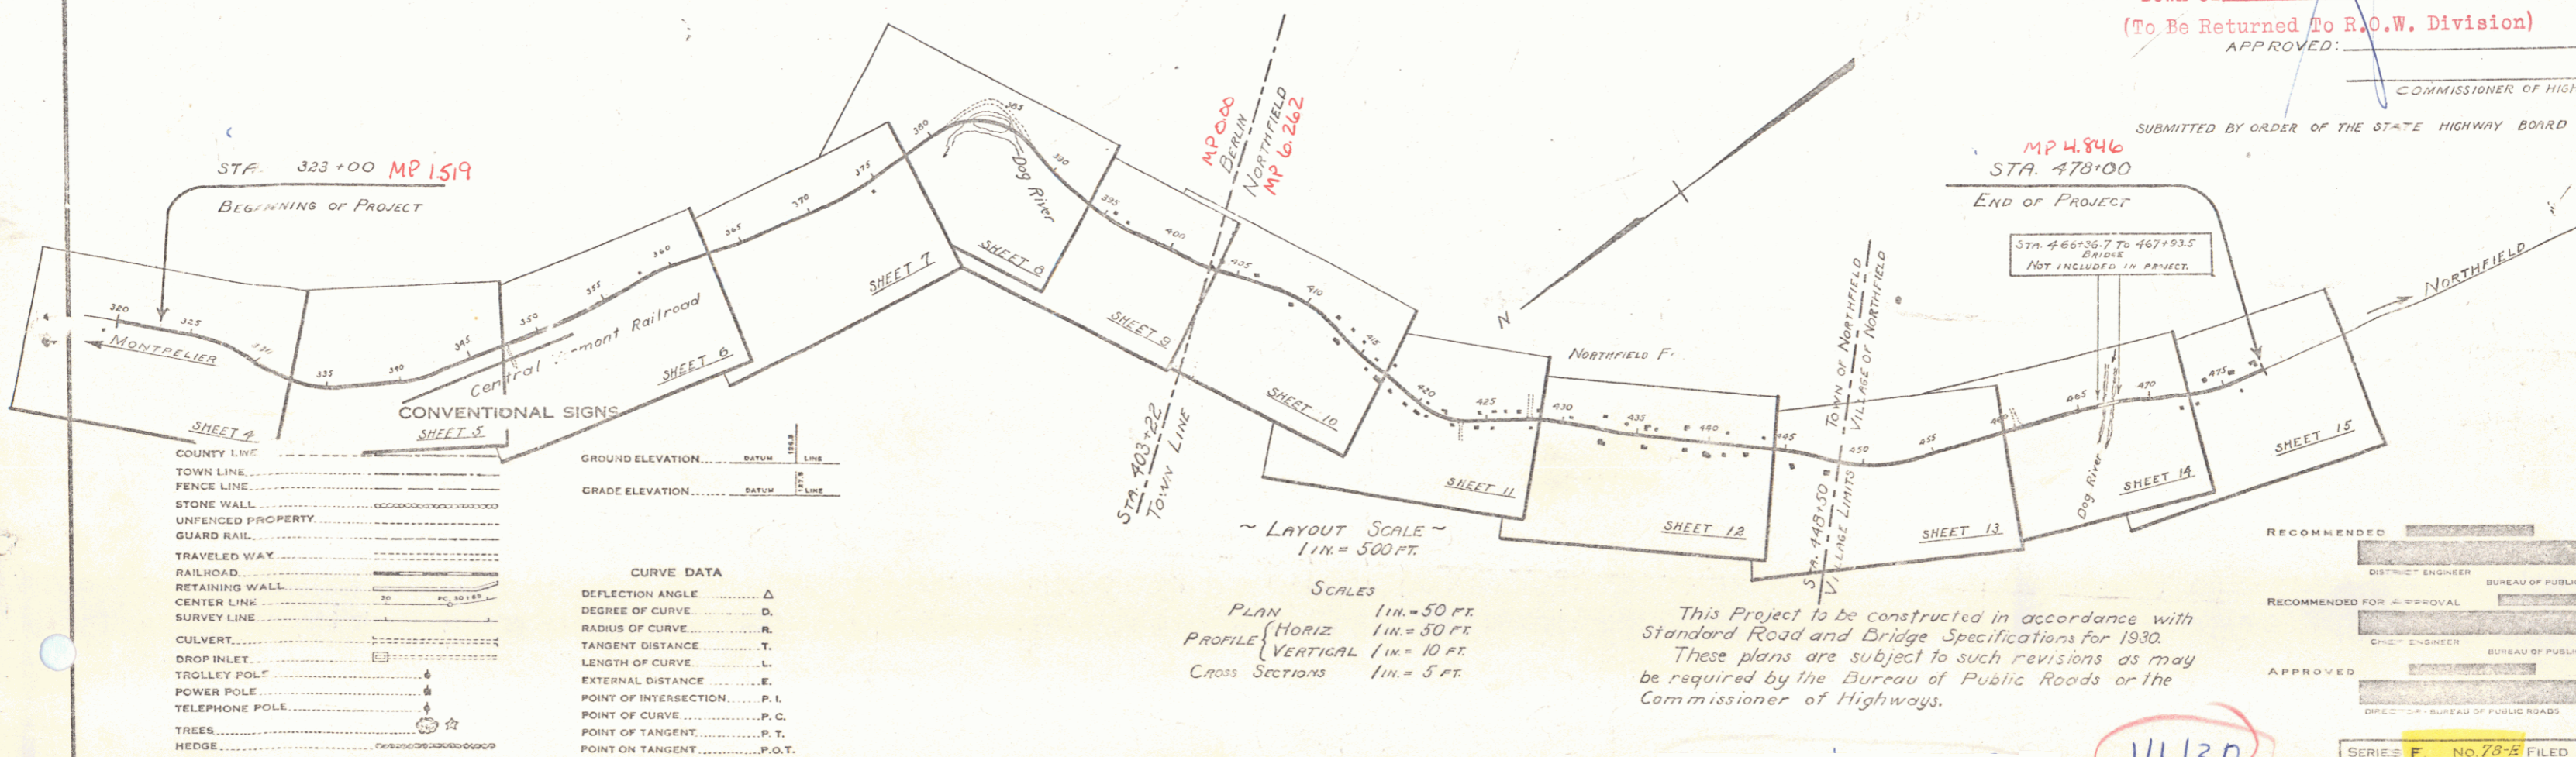

SYMBOL	DESCRIPTION
---	COUNTY LINE
---	TOWN LINE
---	FENCE LINE
---	STONE WALL
---	UNFENCED PROPERTY
---	GUARD RAIL
---	TRAVELED WAY
---	RAILROAD
---	RETAINING WALL
---	CENTER LINE
---	SURVEY LINE
---	CULVERT
---	DROP INLET
---	TROLLEY POLE
---	POWER POLE
---	TELEPHONE POLE
---	TREES
---	HEDGE

CURVE DATA

DEFLECTION ANGLE	Δ
RADIUS OF CURVE	R
TANGENT DISTANCE	T
LENGTH OF CURVE	L
EXTERNAL DISTANCE	E
POINT OF INTERSECTION	P. I.
POINT OF CURVE	P. C.
POINT OF TANGENT	P. T.
POINT ON TANGENT	P. O. T.

RECOMMENDED _____
DISTRICT ENGINEER BUREAU OF PUBLIC ROADS

RECOMMENDED FOR APPROVAL _____
CHIEF ENGINEER BUREAU OF PUBLIC ROADS

APPROVED _____
DIRECTOR BUREAU OF PUBLIC ROADS

This Project to be constructed in accordance with
Standard Road and Bridge Specifications for 1930.
These plans are subject to such revisions as may
be required by the Bureau of Public Roads or the
Commissioner of Highways.

11/130

SERIES F NO. 78-B FILED
SHEET 1 OF 57