


WOOD GUARD RAIL REQUIRED		CABLE GUARD RAIL REQUIRED	
Station	Lt. - Rt.	Station	Lt. - Rt.
466132	24' -	462+20 - 466128	- 900'
466100	24' 24'		

Old Bridge & highway plotted from 1914 new bridge plans.

78-E 1930, 14

PLAN
 DATE: 1930
 DRAWN BY: [illegible]
 CHECKED BY: [illegible]

PROFILE
 DATE: 1930
 DRAWN BY: [illegible]
 CHECKED BY: [illegible]

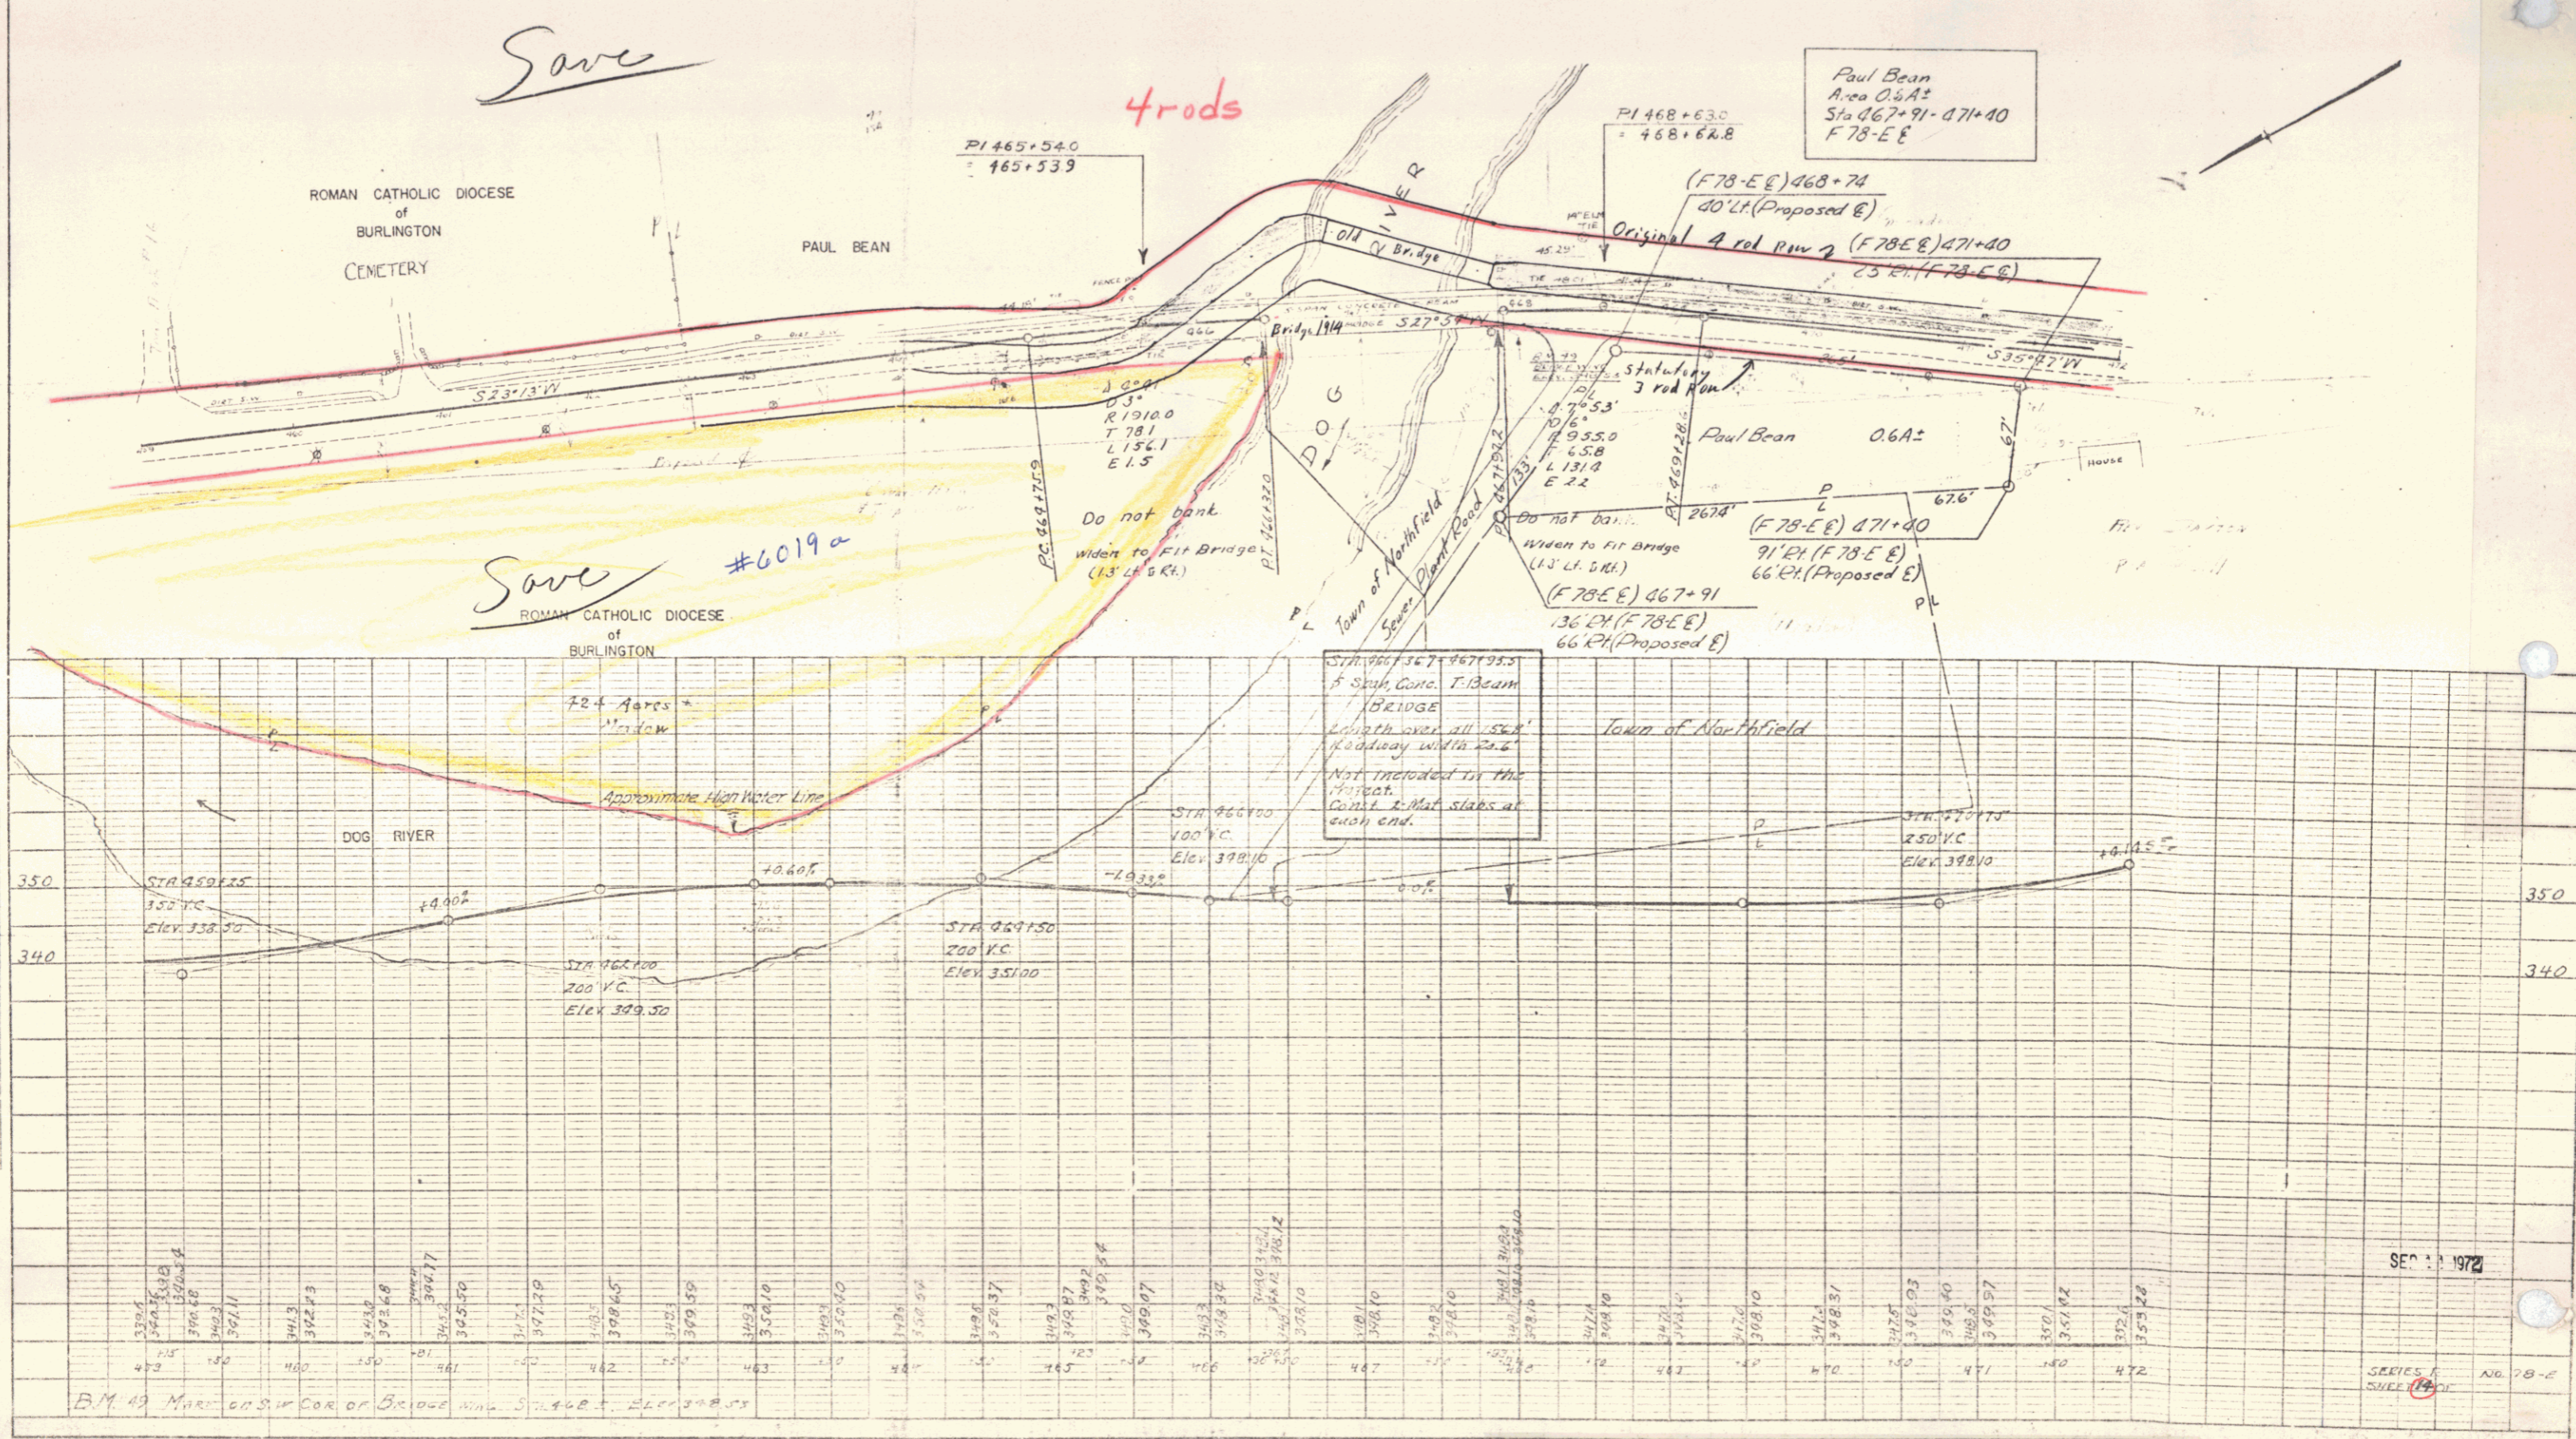

B.M. 49 MAR. 60 S.W. COR. OF BRIDGE W/TH S. 46.2' ELEV. 348.55

SECTION 1972

SHEET 12 OF 14