


CONSTE APPROACH CONSTRUCT DRIVE
 21+59 LF 17+60 LT
 21+59 RT 18+00 RT
 18+90 LT
 27+45 RT (2way, Commercial, Paved)
 19+50 LT

LANDSCAPING
 Arrowwood, Item 656.291
 19+22 - 20+60 LT (50)
 19+22 - 21+30 RT (65)
 AUSTRIAN PINE, Item 656.149

POOR ORIGINAL COPY

SNOWDRIFT CURB, Item 656.370
 24+97 RT
 26+15 RT
 LISET CURB, Item 656.370
 25+50 RT
 27+03 RT

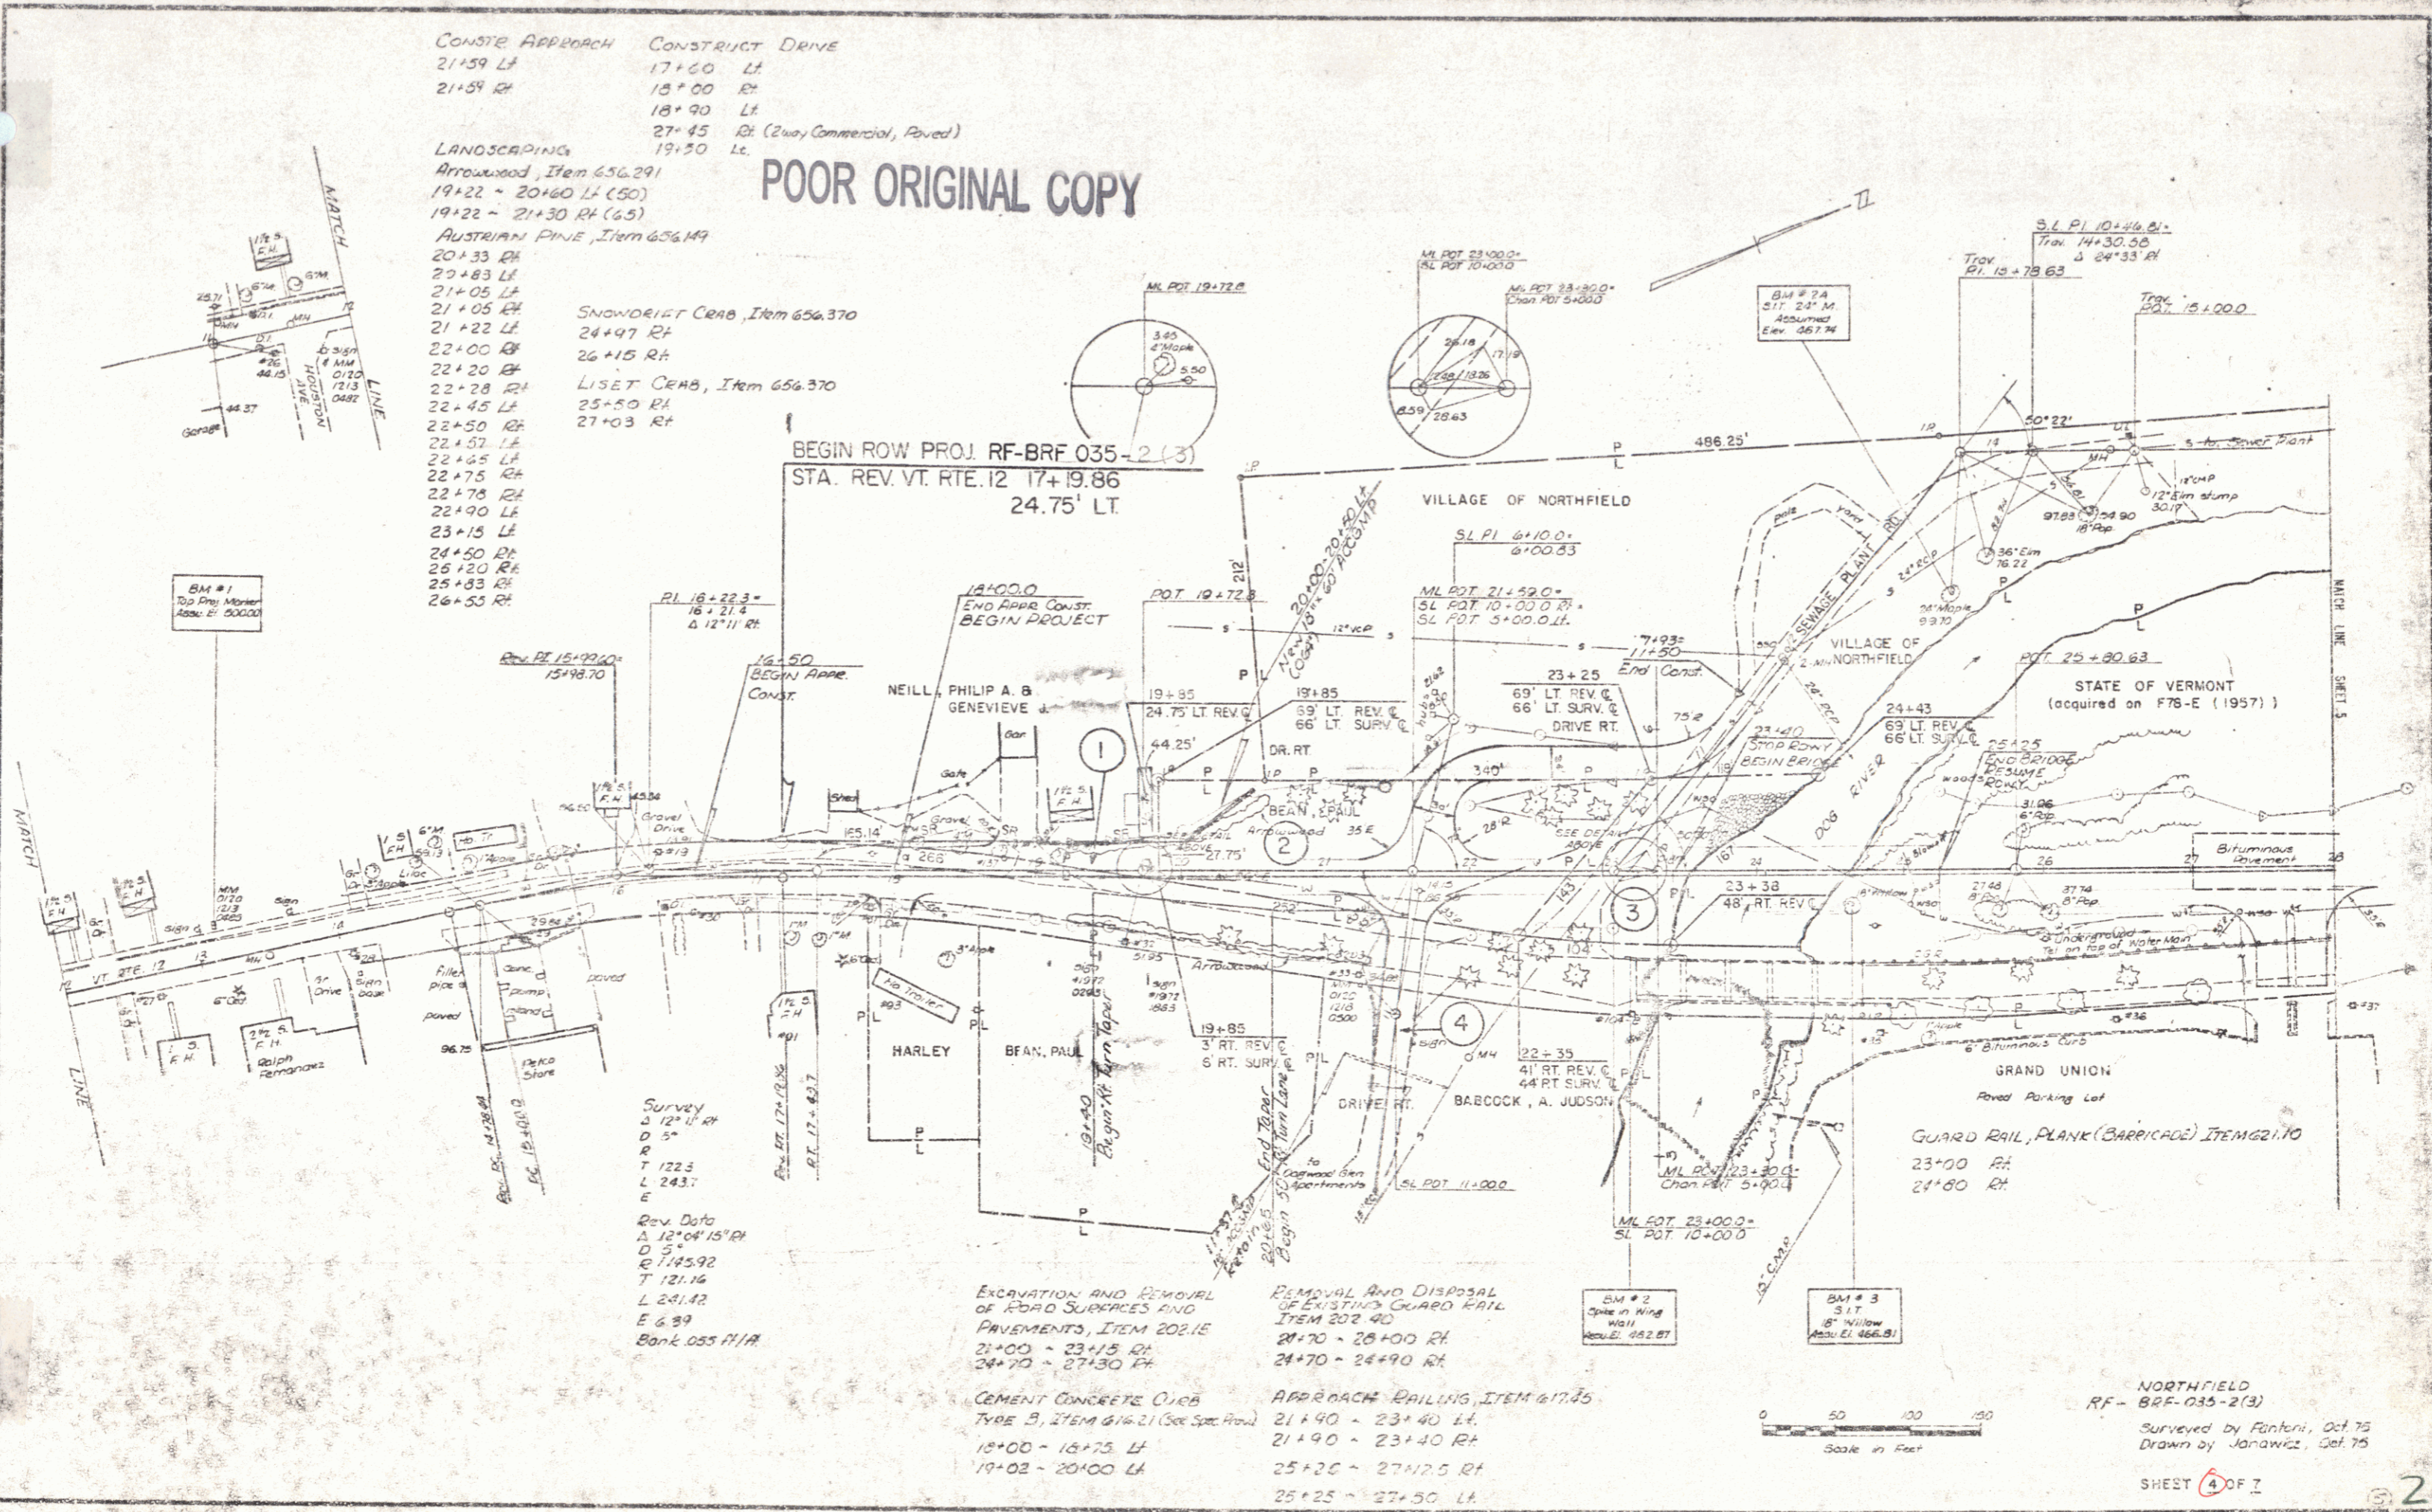

Survey
 S 12° 14' 24"
 D 5"
 T 122.3
 L 243.7
 E

Rev. Date
 A 12° 04' 15" RT
 D 5"
 Q 1745.92
 T 121.16
 L 241.42
 E 6.89
 Bank 0.55 H/A

EXCAVATION AND REMOVAL
 OF ROAD SURFACES AND
 PAVEMENTS, ITEM 202.1E
 21+00 - 23+15 RT
 24+70 - 27+30 RT

CEMENT CONCRETE CURB
 TYPE B, ITEM 616.21 (See Spec. Prov.)
 18+00 - 18+75 LT
 19+02 - 20+00 LT

REMOVAL AND DISPOSAL
 OF EXISTING GUARD RAIL
 ITEM 202.40
 21+70 - 26+00 RT
 24+70 - 24+90 RT

APPROACH RAILING, ITEM 617.35
 21+40 - 23+40 LT
 21+90 - 23+40 RT
 25+20 - 27+25 RT
 25+25 - 27+50 LT

NORTHFIELD
 RF-BRF-035-2(3)
 Surveyed by Fancher, Oct. 75
 Drawn by Janawicz, Oct. 75

SHEET 4 OF 1