


*M*

PROJECT *Bevin*  
 NUMBER *MM 781*  
 TYPE *24 in. Crushed Gravel M.P. Steel Beam Bridge.*  
 CONTRACTOR  
 LOCATION *Railroad Crossing at Swanton Isabella*  
 YEAR *1933*  
 LENGTH *0.377 MI*  
 0.407 Mi.


CONVENTIONAL SIGNS

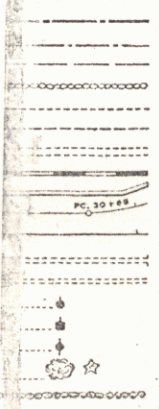

GROUND ELEVATION..... DATUM  $\frac{1}{8}$ " LINE  
 GRADE ELEVATION..... DATUM  $\frac{1}{8}$ " LINE

CURVE DATA

DEFLECTION ANGLE .....  $\Delta$   
 DEGREE OF CURVE ..... D.  
 RADIUS OF CURVE ..... R.  
 TANGENT DISTANCE ..... T.  
 LENGTH OF CURVE ..... L.  
 EXTERNAL DISTANCE ..... E.  
 POINT OF INTERSECTION ..... P. I.  
 POINT OF CURVE ..... P. C.  
 POINT OF TANGENT ..... P. T.  
 POINT ON TANGENT ..... P. O. T.

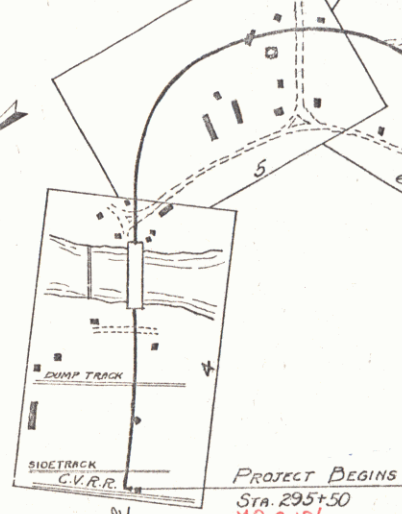

PROJECT BEGINS  
 Sta. 295+50  
 MP 2.106

THESE PLANS ARE SUBMITTED FOR THE RECORD AND MAY BE REQUIRED BY THE COMMISSIONER OF HIGHWAYS. CONSTRUCTION IS TO BE IN ACCORDANCE WITH THE STANDARD ROAD CROSS SECTIONS OF 1933 WITH SUCH REVISIONS AS ARE SUBMITTED.

TITLE PAGE  
 PLAN SHEET  
 PROFILE  
 CROSS SECTION

MILEAGE SHEET