


~~NOTE:
GRAVEL USED FOR FINISHED SURFACE OF ALL SIDE
ROADS AND DRIVES TO BE PAID FOR UNDER UNIT
PRICE BID FOR GRAVEL SUB-BASE.~~

~~ALL TRAFFIC TO BE MAINTAINED OVER PRESENT WOODEN BRIDGE AND
PRESENT ROAD; AND IF FOUND NECESSARY IN THE CONSTRUCTION, SIDEWALK
BRACKETS AND SIDEWALK TO BE BUILT AFTER TRAFFIC IS BEING MAINTAINED
OVER NEW STRUCTURE AND AFTER REMOVAL OF PRESENT WOODEN BRIDGE.~~

FUTURE IMPROVEMENT

295+00
V.C. 1300'
301.00

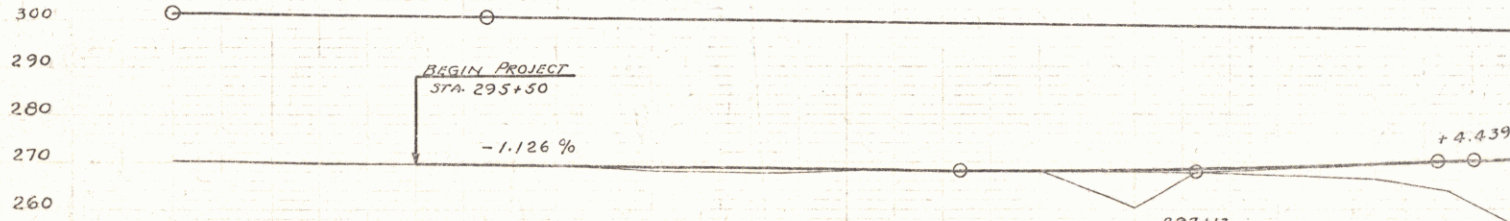

BM.#23 Cor. foundation Wiquay Sig. Tower Lt. Sta. 295+0 El. 271.16
BM.#24 14" Elm Lt. Sta. 298+80 El. 263.47

