


100%  
 PUTNAM  
 GALL

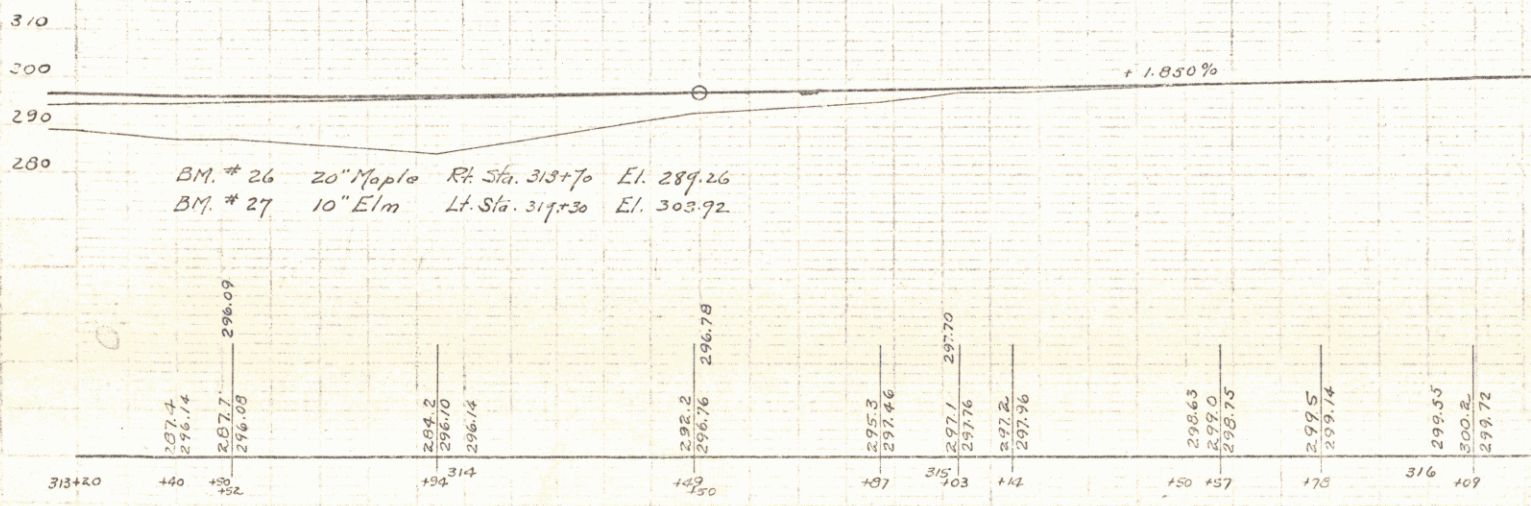

END PR  
 STA. 31