



Conc. Line
 $\Delta 17^{\circ}52'11''$
 D 6'
 R 955.4
 T 150.2
 L 207.8
 E 117

THEODORE NORMAN

$\Delta 15^{\circ}10'14''$
 RD
 1030'
 3819.8
 T 508.5
 L 1011.1
 E 337

Conc. Line
 $\Delta 4^{\circ}37'11''$
 D 1'
 R 5720.6
 T 231.0
 L 461.7
 E 47

Conc. Line
 $\Delta 2^{\circ}42'11''$
 D 1'
 R 5720.6
 T 135.0
 L 270.0
 E 16

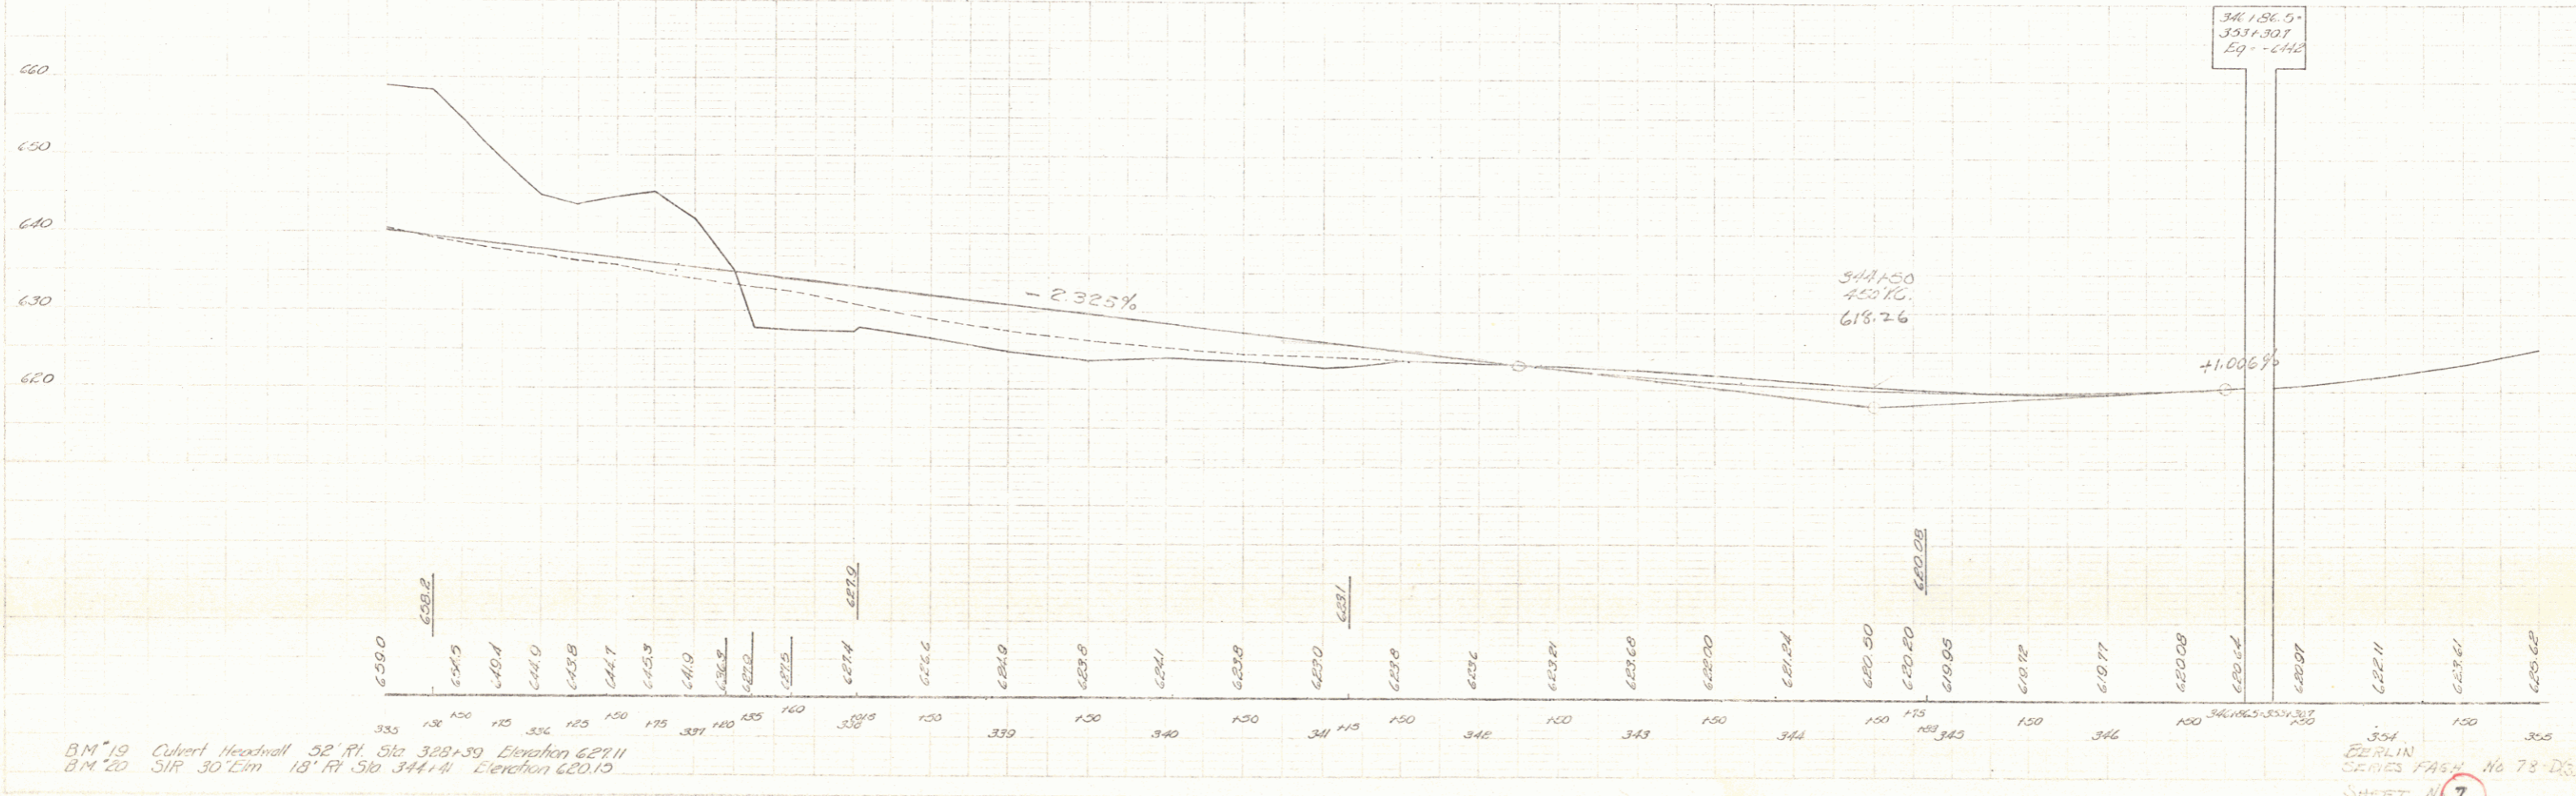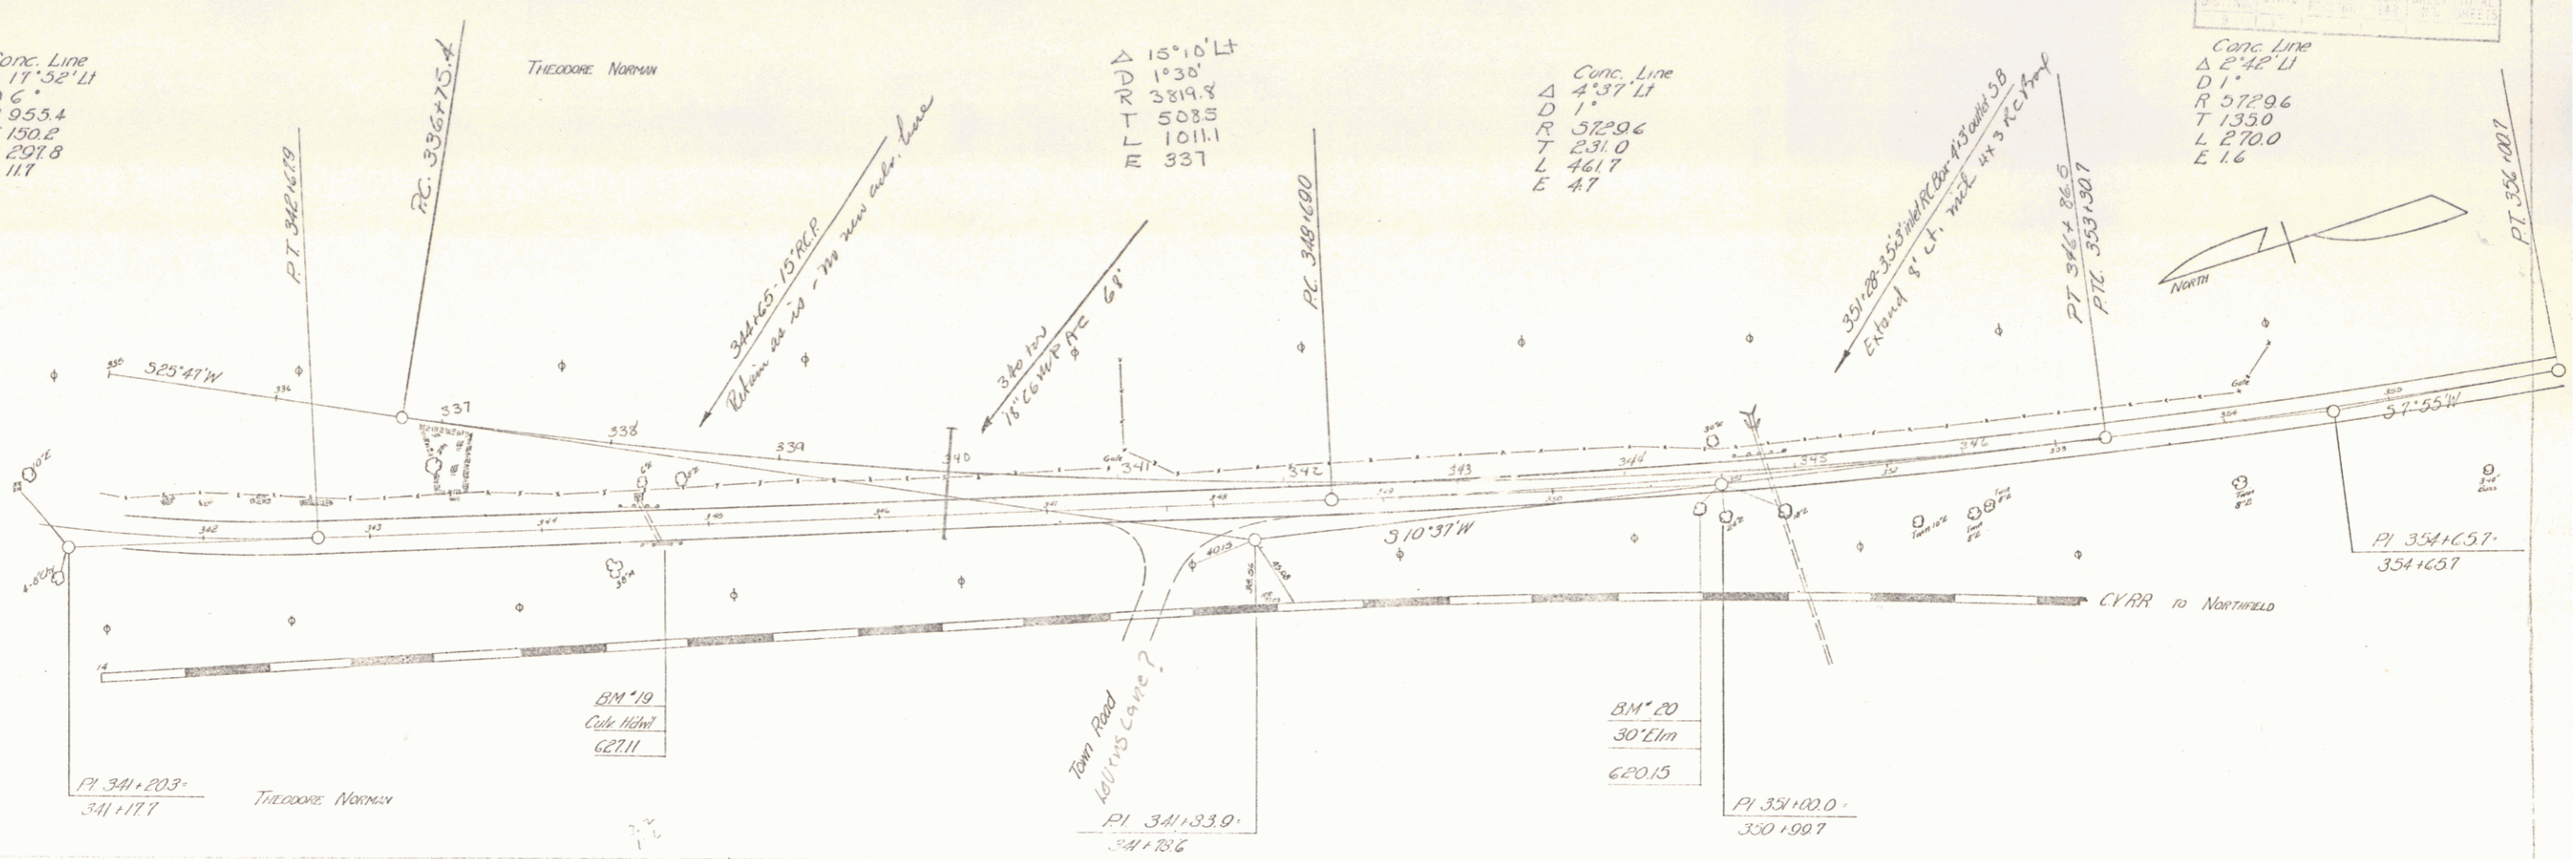

BM 19 Culvert Headwall 52' R. Sta 329+39 Elevation 621.11
 BM 20 S/R 30' Elm 18' R Sta 344+11 Elevation 620.15

341+56.5
 331+30.7
 Eq - 440

504
 EERLIN
 GEORGE FAYH No 78-DS
 SHEET No 7