

PLAN	DATE
PLotted	
Scale	
Notes	

DATE	
BY	
CHECKED	
APPROVED	

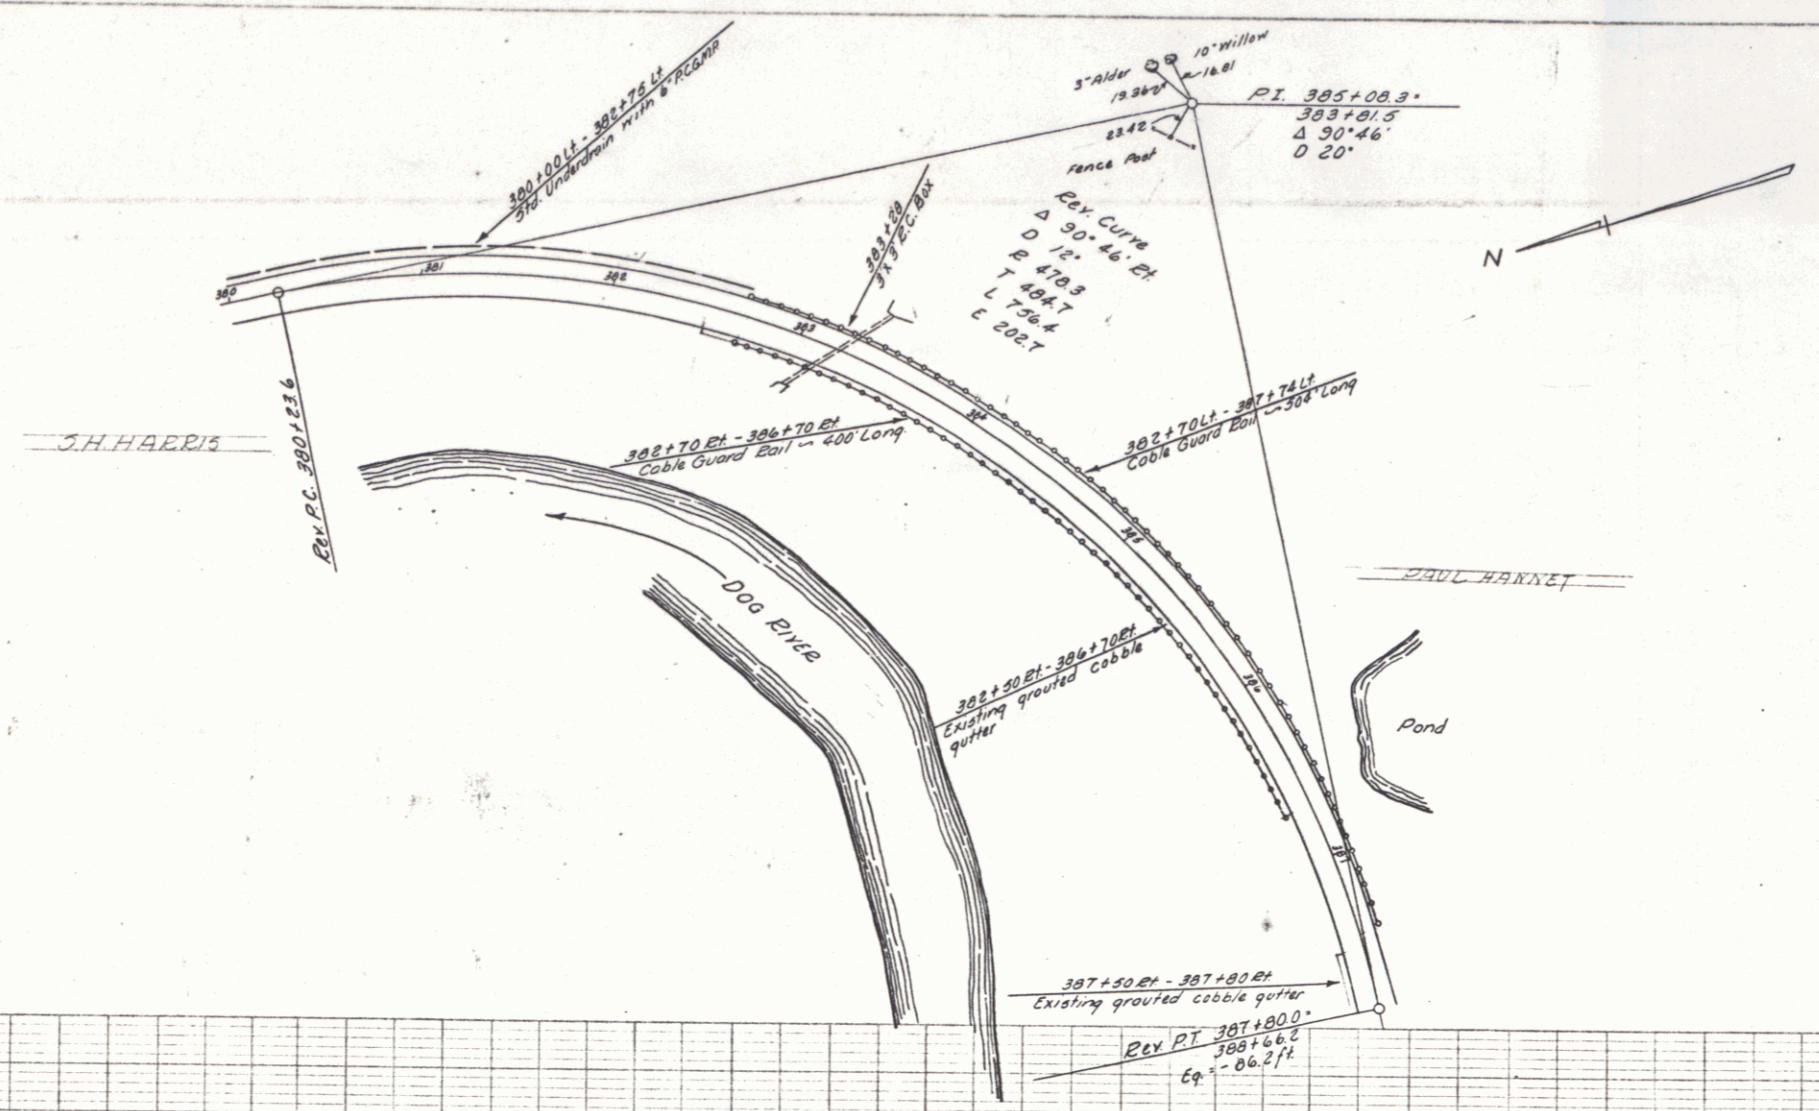


PLATE 1 - PLAN - PROFILE - 11 x 17.5 x 6 PRICE
 HARRIS ENGINEERING CO. INC.

SHEET 6