

30-136



WOOD GUARD RAIL REQUIRED			CABLE GUARD RAIL REQUIRED			NEW REIN. CONCRETE PIPE CULVERTS REQUIRED						
CULVERT STATION	LEFT	RIGHT	STATIONS	LEFT	RIGHT	STR. DIAM.	LEN.	CONC. A	CONC. C	REIN. STEEL	D.I.	EXPOSED TOP
130+80	-	24'	130+38-135+26	4.88'	-	130+50	18'	4.0'	1.5	1.5	174	1b.

CONCRETE CURB & GUTTER REQUIRED				
STATIONS	L OR R	WIDTH	CURE SET	STEEL
130+80-134+50	L	2'-0"	6'	24 ex 733 lbs.

GROUTED COBBLE GUTTER REQUIRED				
STATIONS	L OR R	WIDTH	LENGTH	AREA
134+50-136+00	R	3'-0"	45'-0"	150 sq yds.

Joints in Curb & Gutter section to be placed so that one will occur opposite every transverse joint in the pavement.



Note: Joints in Curb and Gutter not to exceed 9" apart. Provisioned bituminous expansion joint filler, 1/2" thick, to be placed between every 5th section (every 40') (drainage joints to be either full joints pointed with bituminous material or cut plate joints).

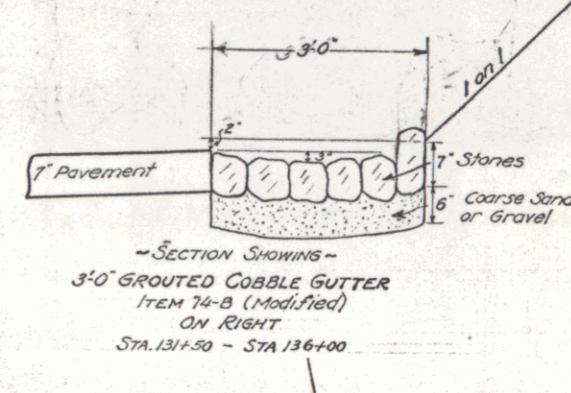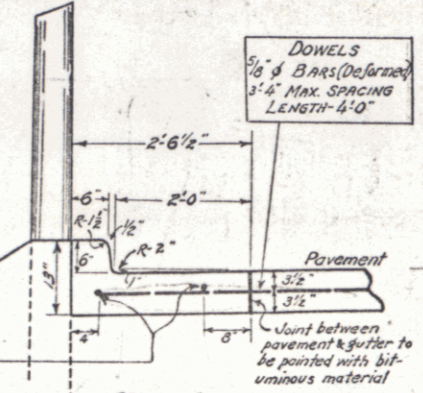

CURVE

Δ	25°-23' Lt
D	9"
E	637.3
T	143.4
L	930.5
E	68.4

Curve not widened

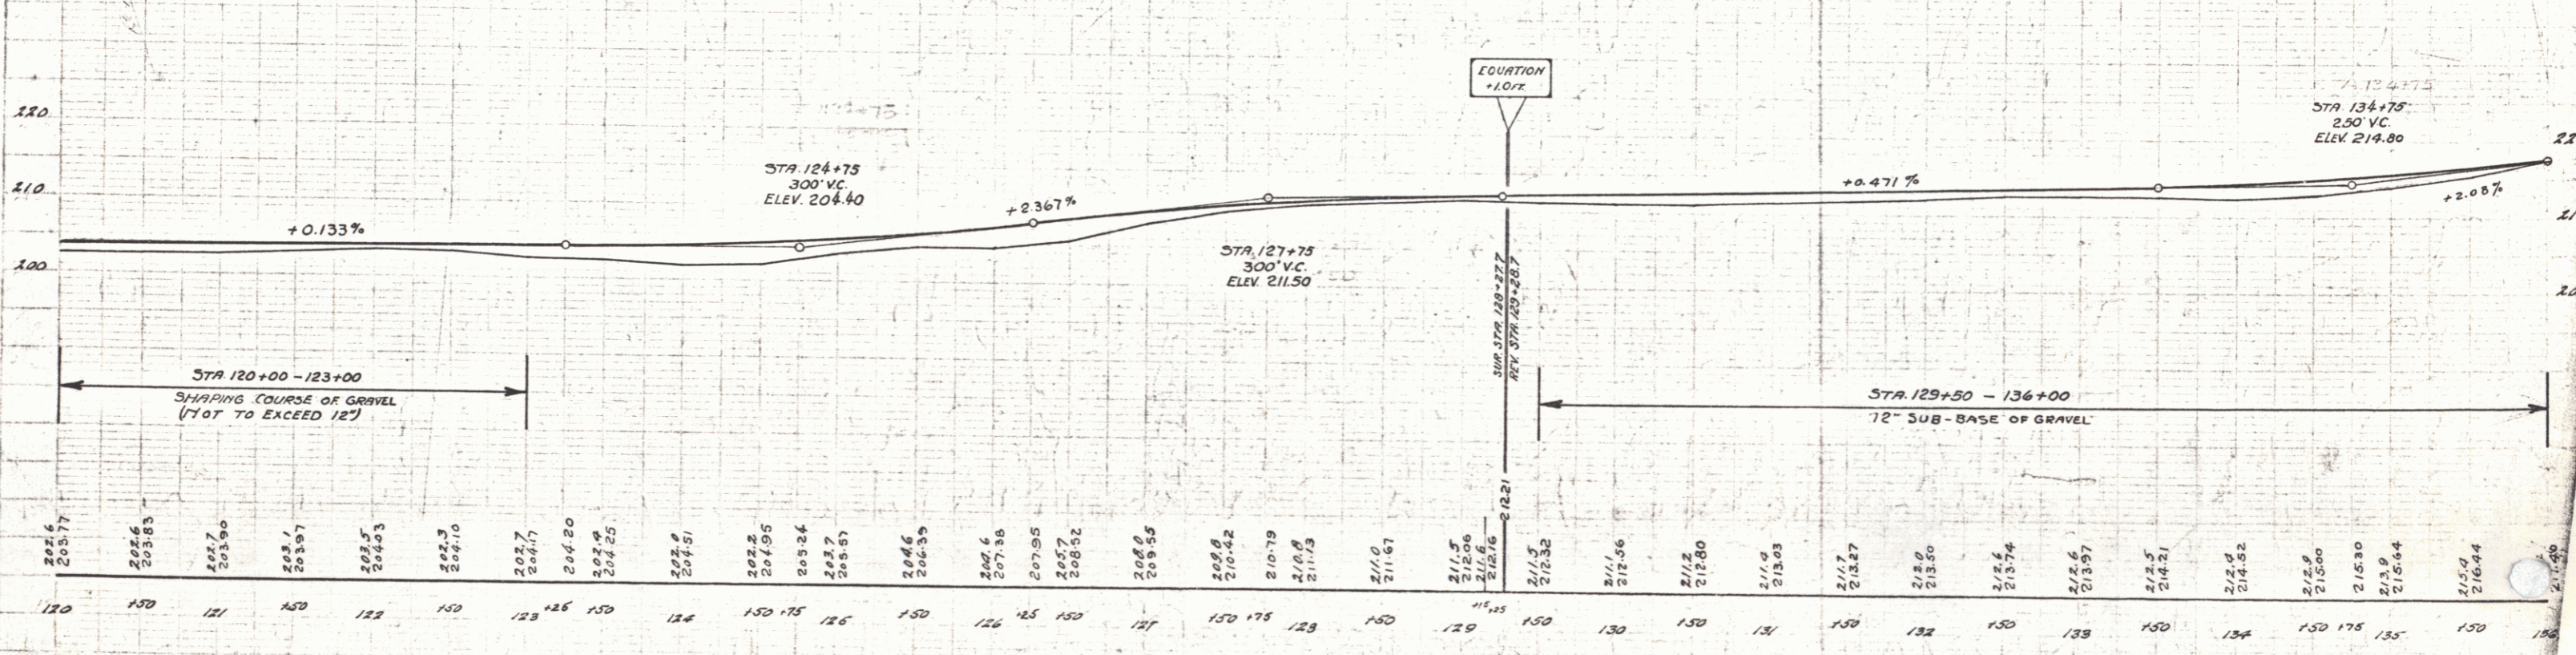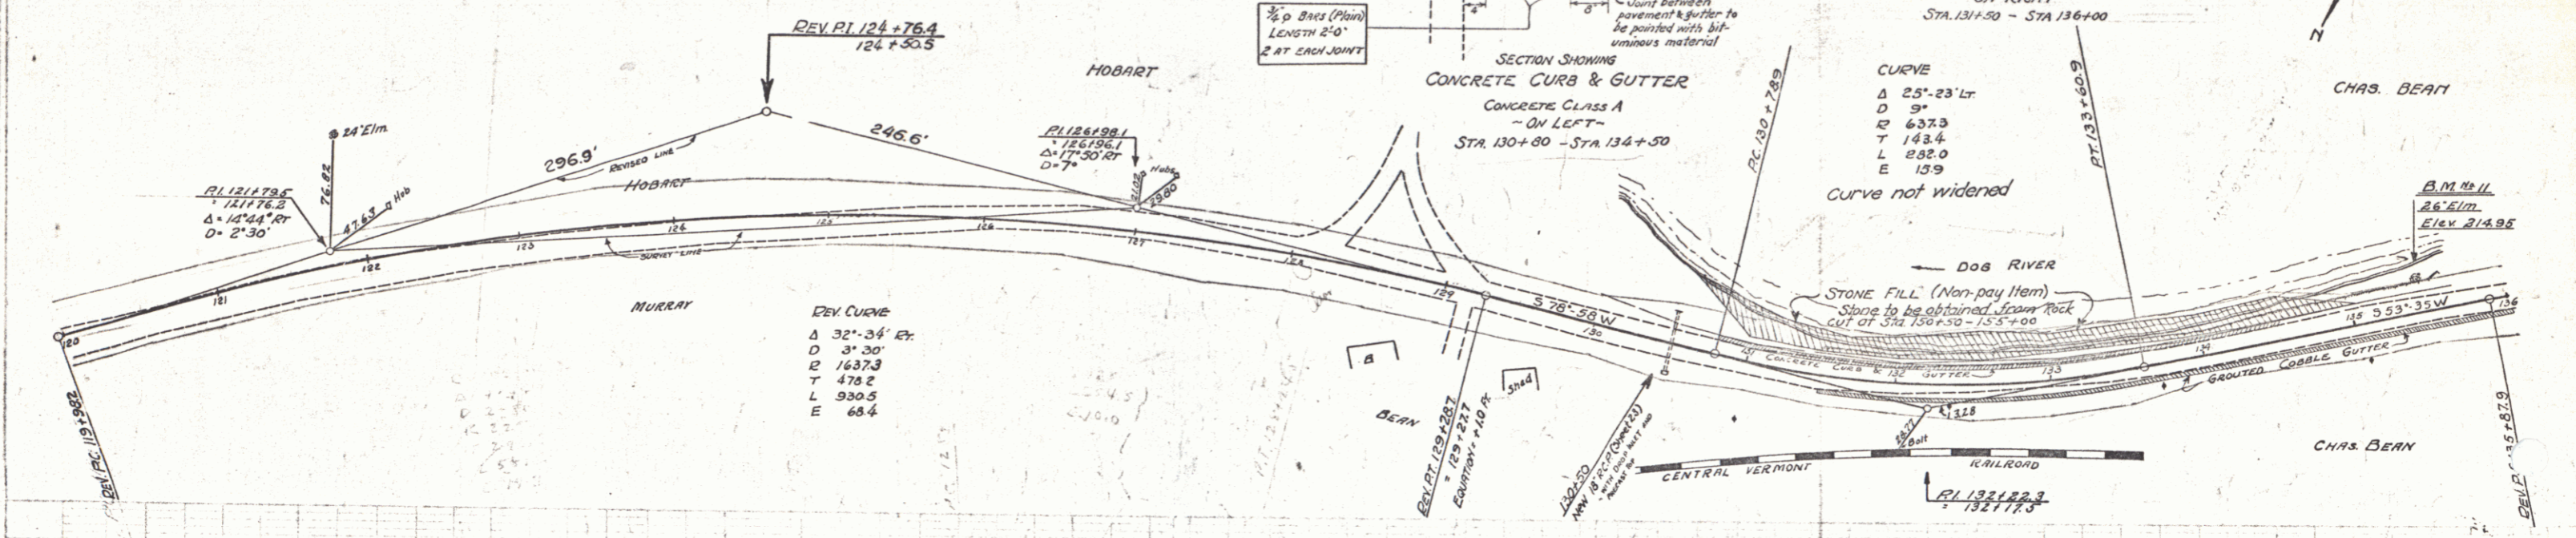

B.M. #11 Spike in root of 26' Elm Left of Sta. 135+45 Elev 214.95

FED. ROAD DIST. NO.	STATE	FED. AID PROJ. NO.	FISCAL YEAR	SHEET NO.	TOTAL SHEETS
VI	VT	70-C	1950	12	66

1948  
 1949  
 1950  
SERIES F No. 75C  
SHEET 12 OF 66

10