

WOOD GUARD RAIL REQUIRED



STATION	LEFT	RIGHT
142+79	-	24'
143+62	-	24'
149+40	-	24'
150+84	24'	24'

CABLE GUARD RAIL REQUIRED

STATIONS	LEFT	RIGHT
138+52-139+00	40'	
142+67-149+23	65'	

NEW 24" CONCRETE PIPE CULVERTS REQUIRED

STA.	DIAM.	LEN.	CONC.	CONC.	REINSTEEL	D.I.	GRATES	PROTECT.
142+79	18"	44'	1.5 cy	1.5 cy	176 lbs.	1	1	1
143+62	18"	36'	2.3 cy	-	126 lbs.	1	1	1
149+10	15"	36'	2.3 cy	-	126 lbs.	1	1	1
150+84	15"	40'	2.3 cy	-	126 lbs.	1	1	1

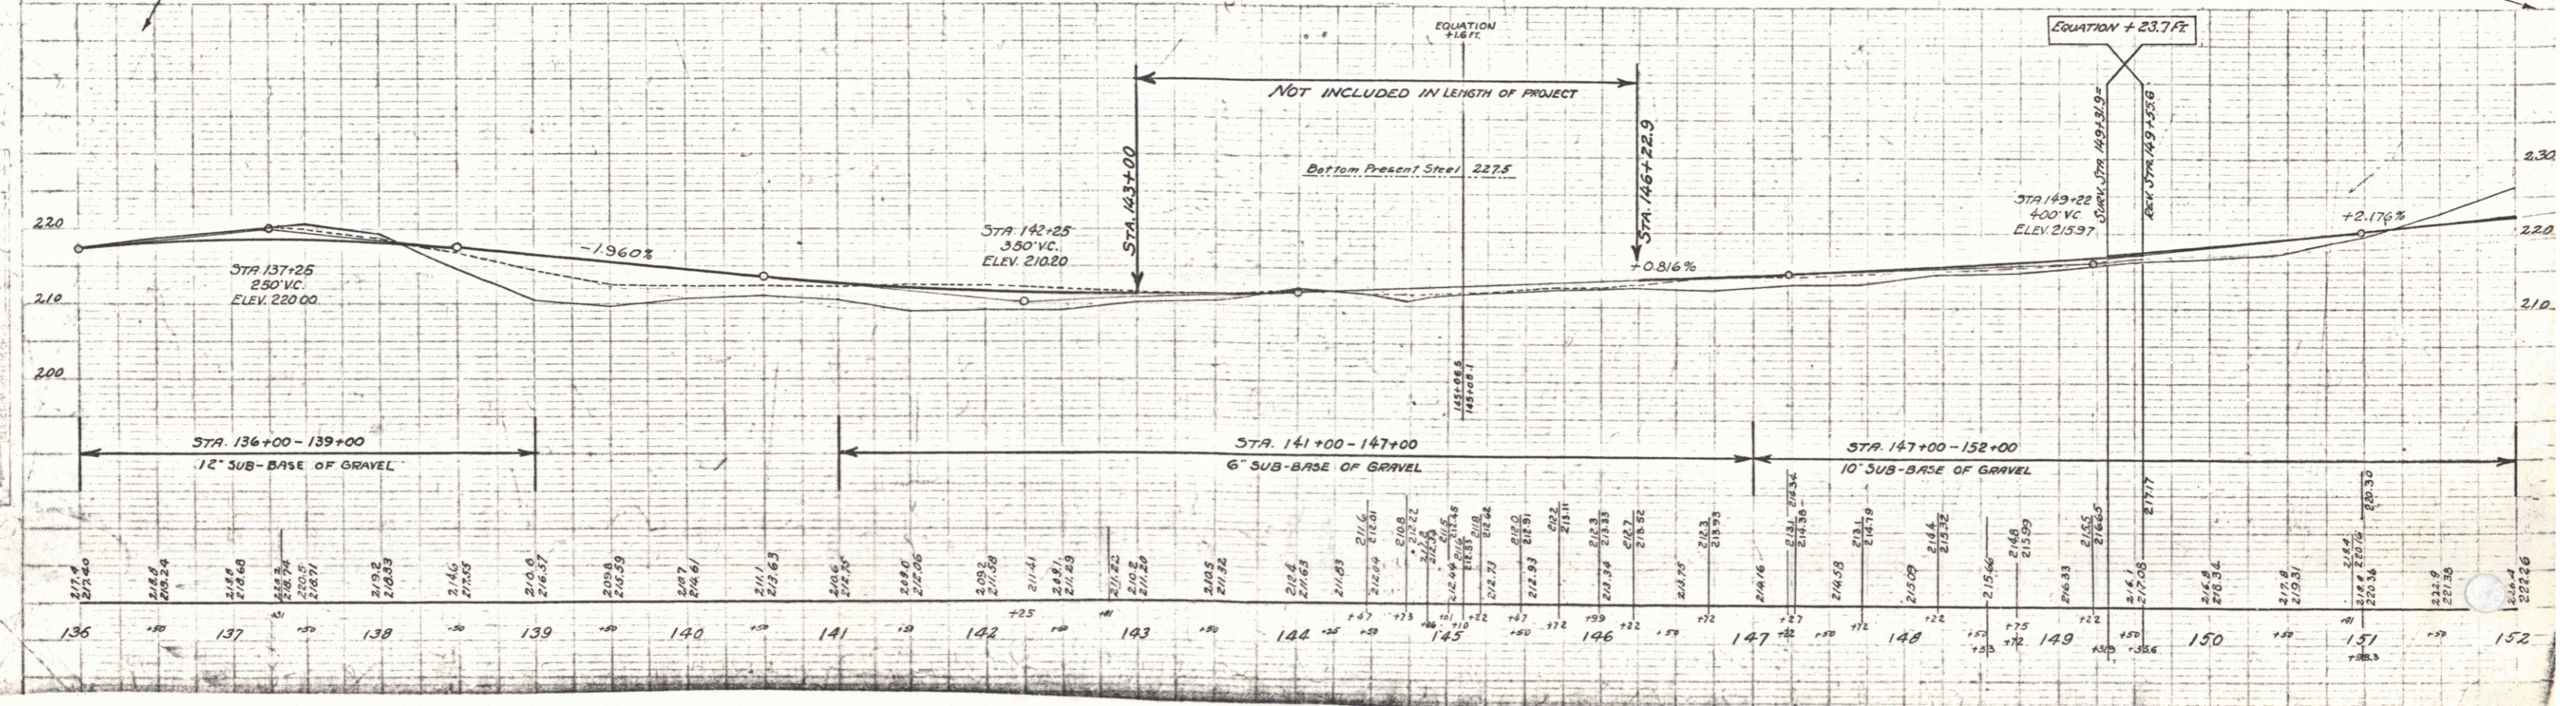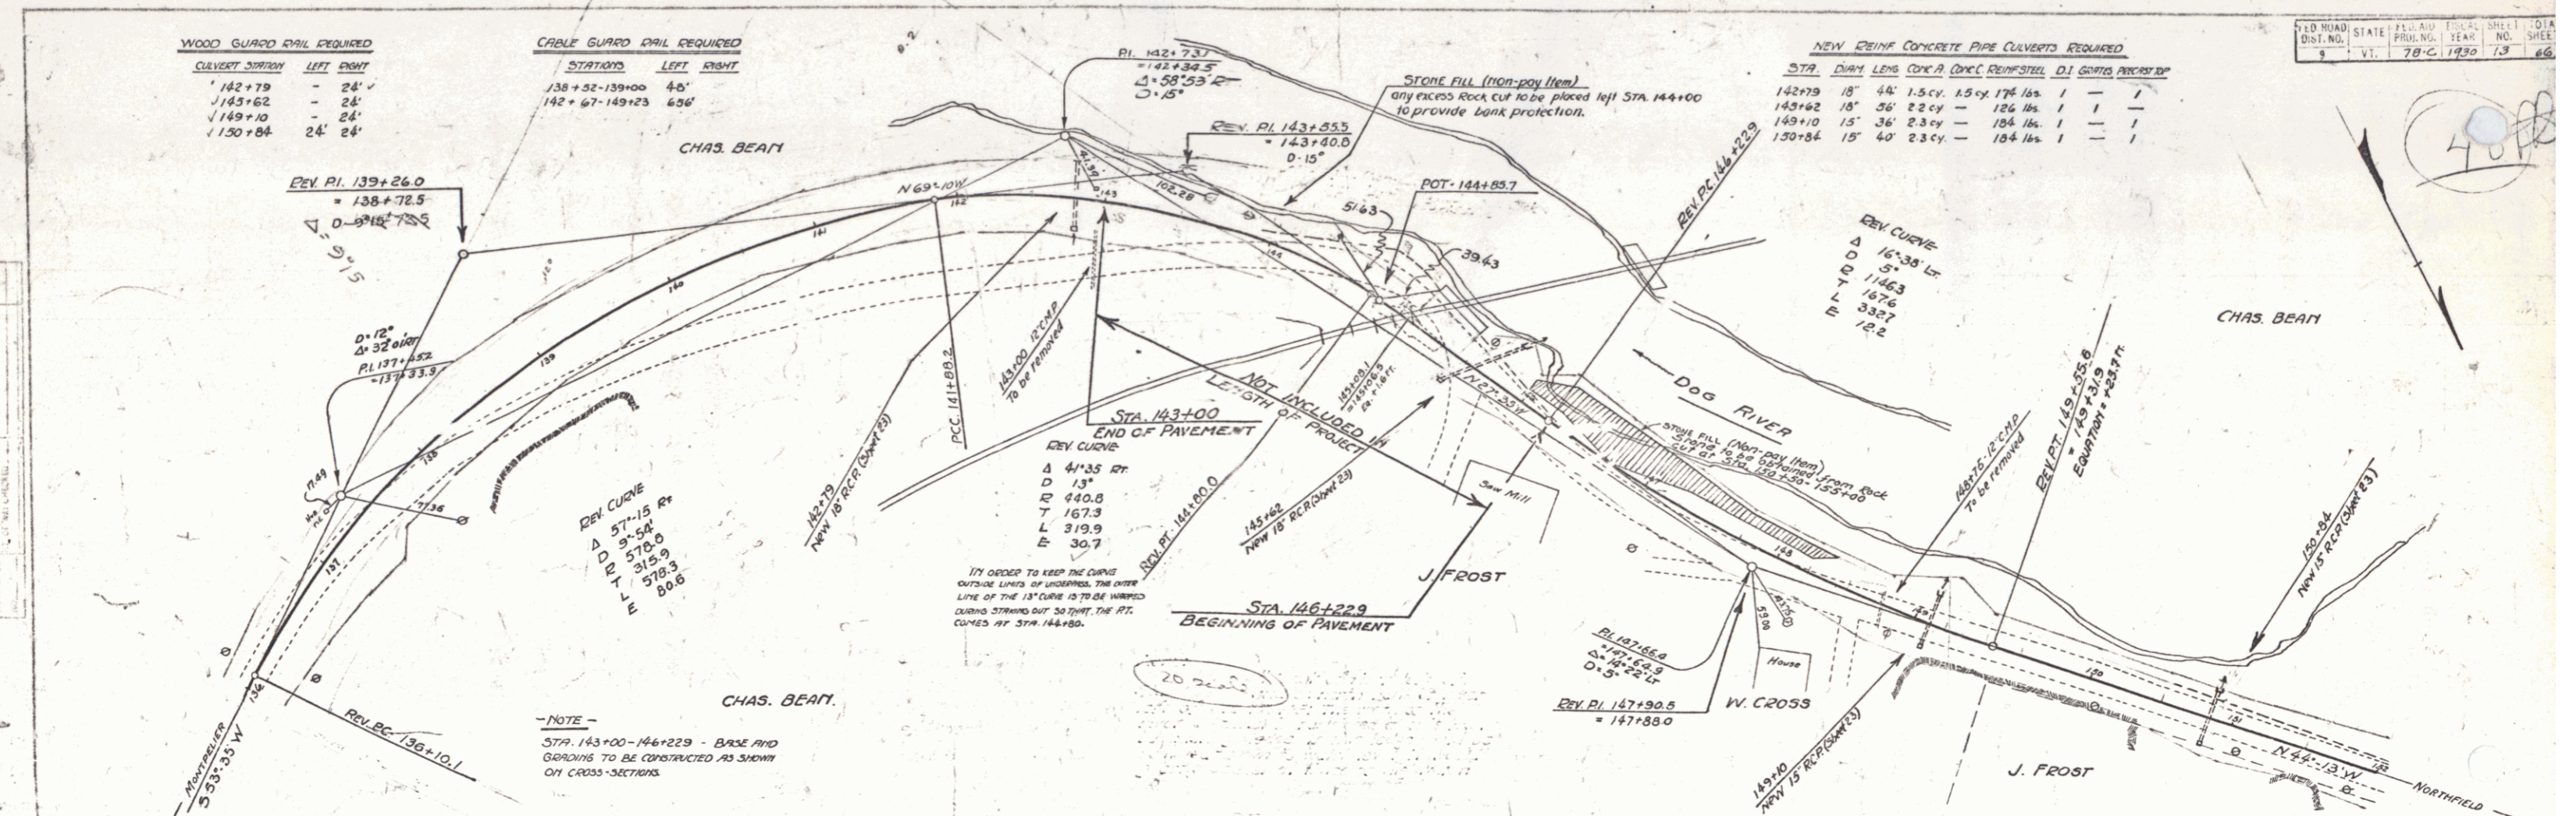

PLAN
 SCALE: 1" = 40'

PROFILE
 SCALE: 1" = 10'