

WOOD GUARD RAIL REQUIRED		
CULVERT STATION	LEFT	RIGHT
V 157+34	-	24'
V 154+62	24'	24'



CABLE GUARD RAIL REQUIRED		
STATIONS	LEFT	RIGHT
156+50-157+46	36'	-

NEW REIN CONCRETE PIPE CULVERTS REQUIRED				
STATION	DIAM	LENS	CONC	REIN STEEL
157+34	24"	76'	2.4cv	54 lbs.
154+62	18"	48'	1.0cv	54 lbs.

DRIVEWAY PIPE CULVERTS REQUIRED				
STATION	DIAM	LENS	CEMENT	CURABLE MASONRY
164+40	12"	24'	23	ON HUB.
164+40	12"	24'	23	ON HUB.

FIELD NO. STATE PROJ. NO. FISCAL YEAR SHEET TOTAL
 75-C 1936 66

1937
 1938
 1939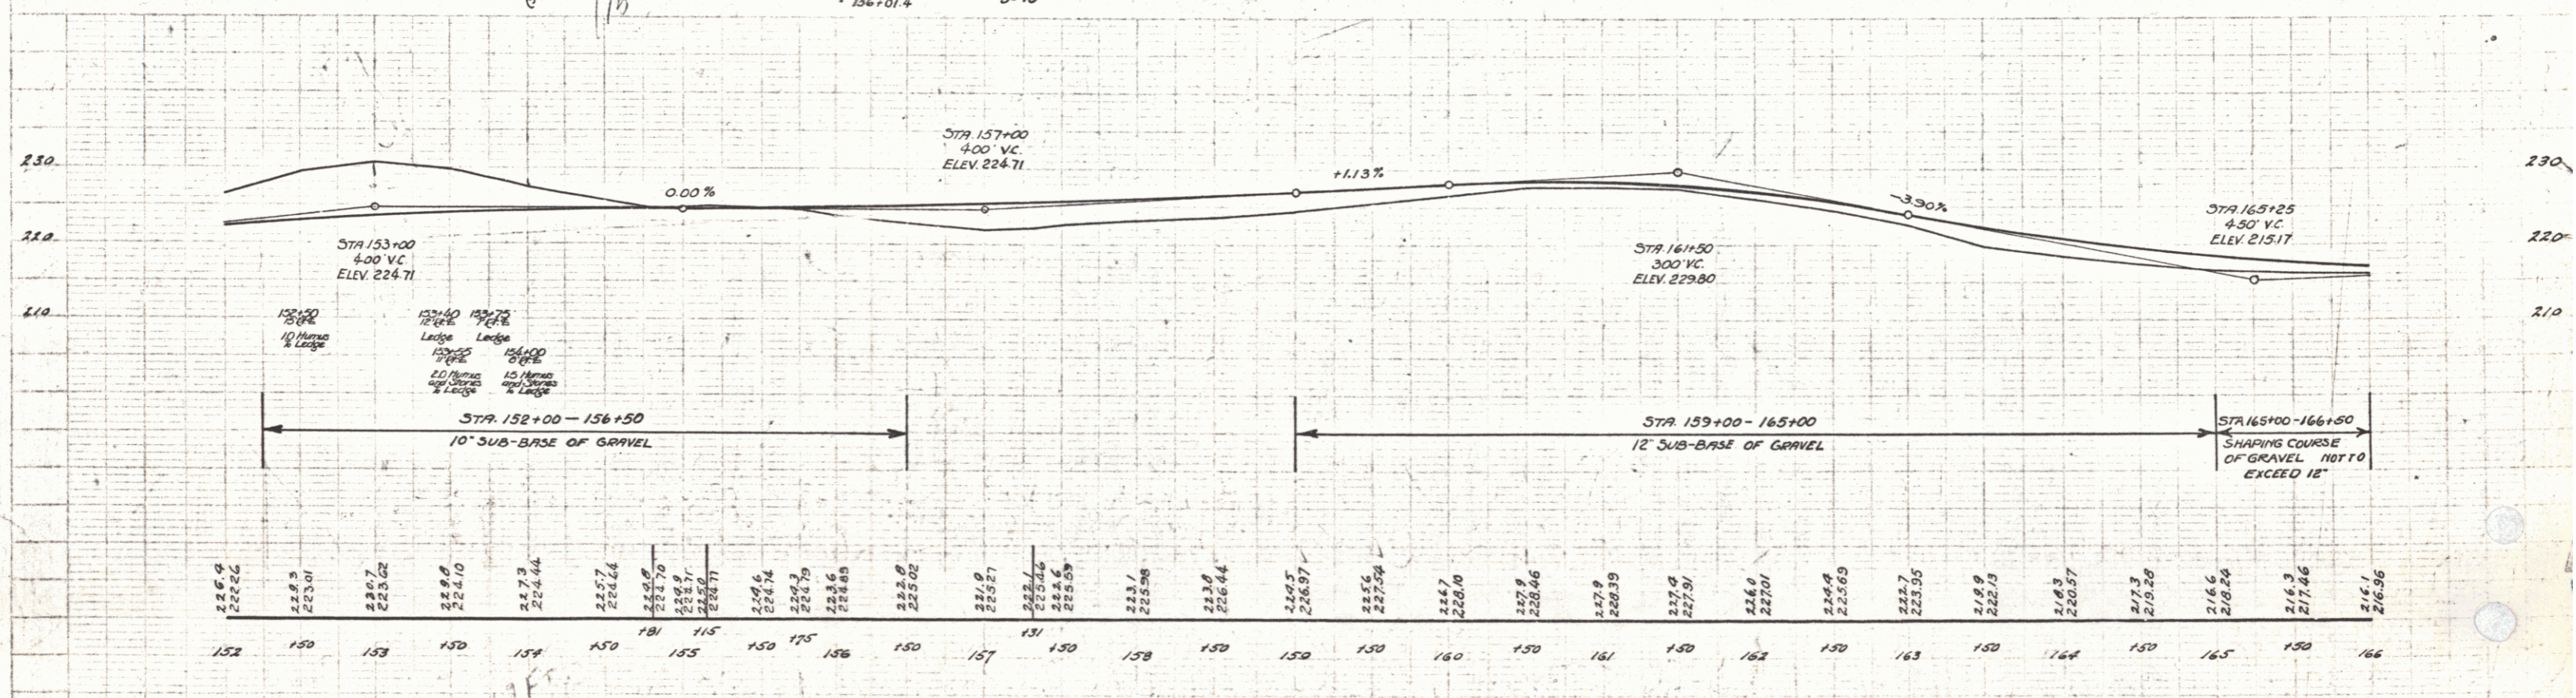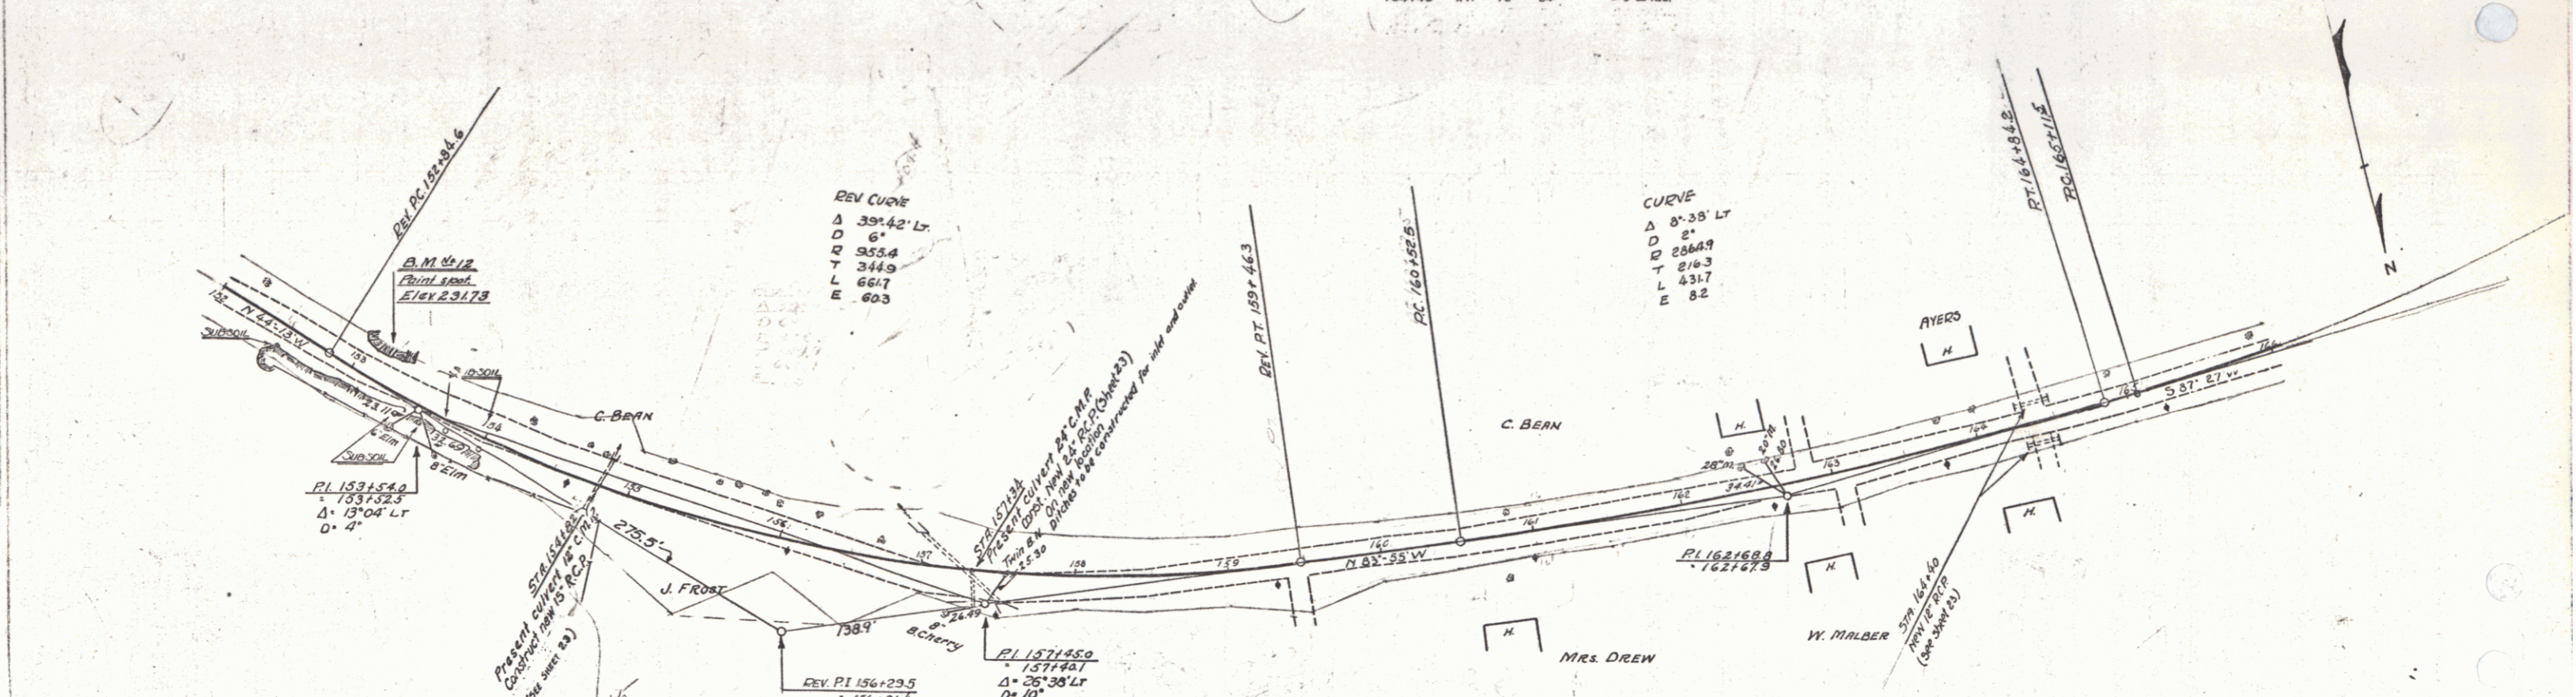
B.M. #12 Faint spot on ledge Left of Sta. 153+20 Elev. 231.73

SERIES F No 78C
 SHEET 18 OF 66