
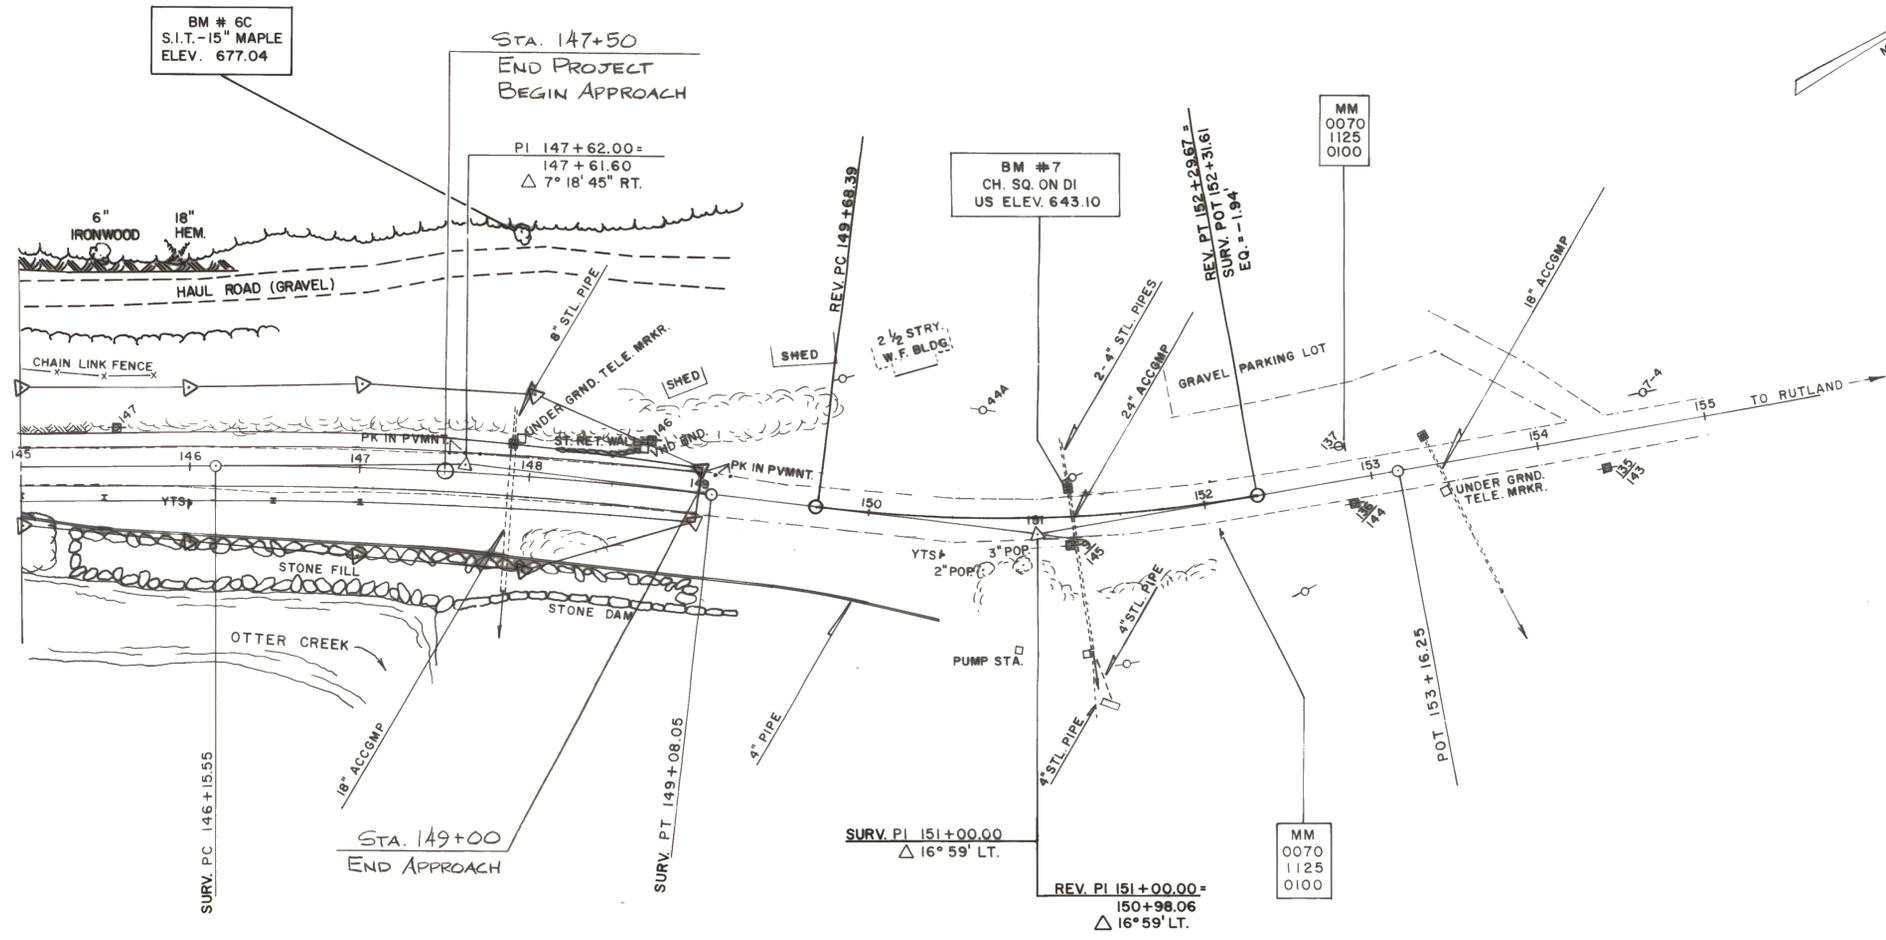


SURVEYED
 ML CURVE DATA
 Δ 7° 18' 45" RT.
 D 2° 30'
 R 2291.83'
 T 146.45'
 L 292.50'
 E 4.67'
 BANK 0.046 FT./FT.

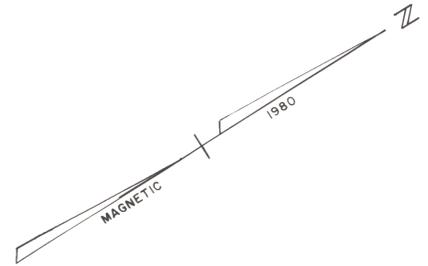

REV. CURVE DATA
 Δ 16° 59' LT.
 D 6° 30'
 R 881.47'
 T 131.61'
 L 261.28'
 E 9.77
 BANK TO MATCH EXISTING (0.046 FT./FT.)


BM # 6C
 S.I.T.-15" MAPLE
 ELEV. 677.04

BM # 7
 CH. SQ. ON DI
 US ELEV. 643.10

MM
 0070
 1125
 0100

MM
 0070
 1125
 0100

DATUM	
VERTICAL	NGVD 1929
HORIZONTAL	N/A

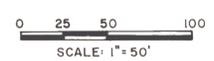

145+00 — 155+00

SURVEYED BY	FANTONI	DATE	5-85
DRAWN BY	P.M. PELKEY	DATE	6-85
TRACED BY	PELKEY	DATE	6-85

WALLINGFORD

PROJ. RS NO. 0137 (5)

SHEET 8 OF 12