

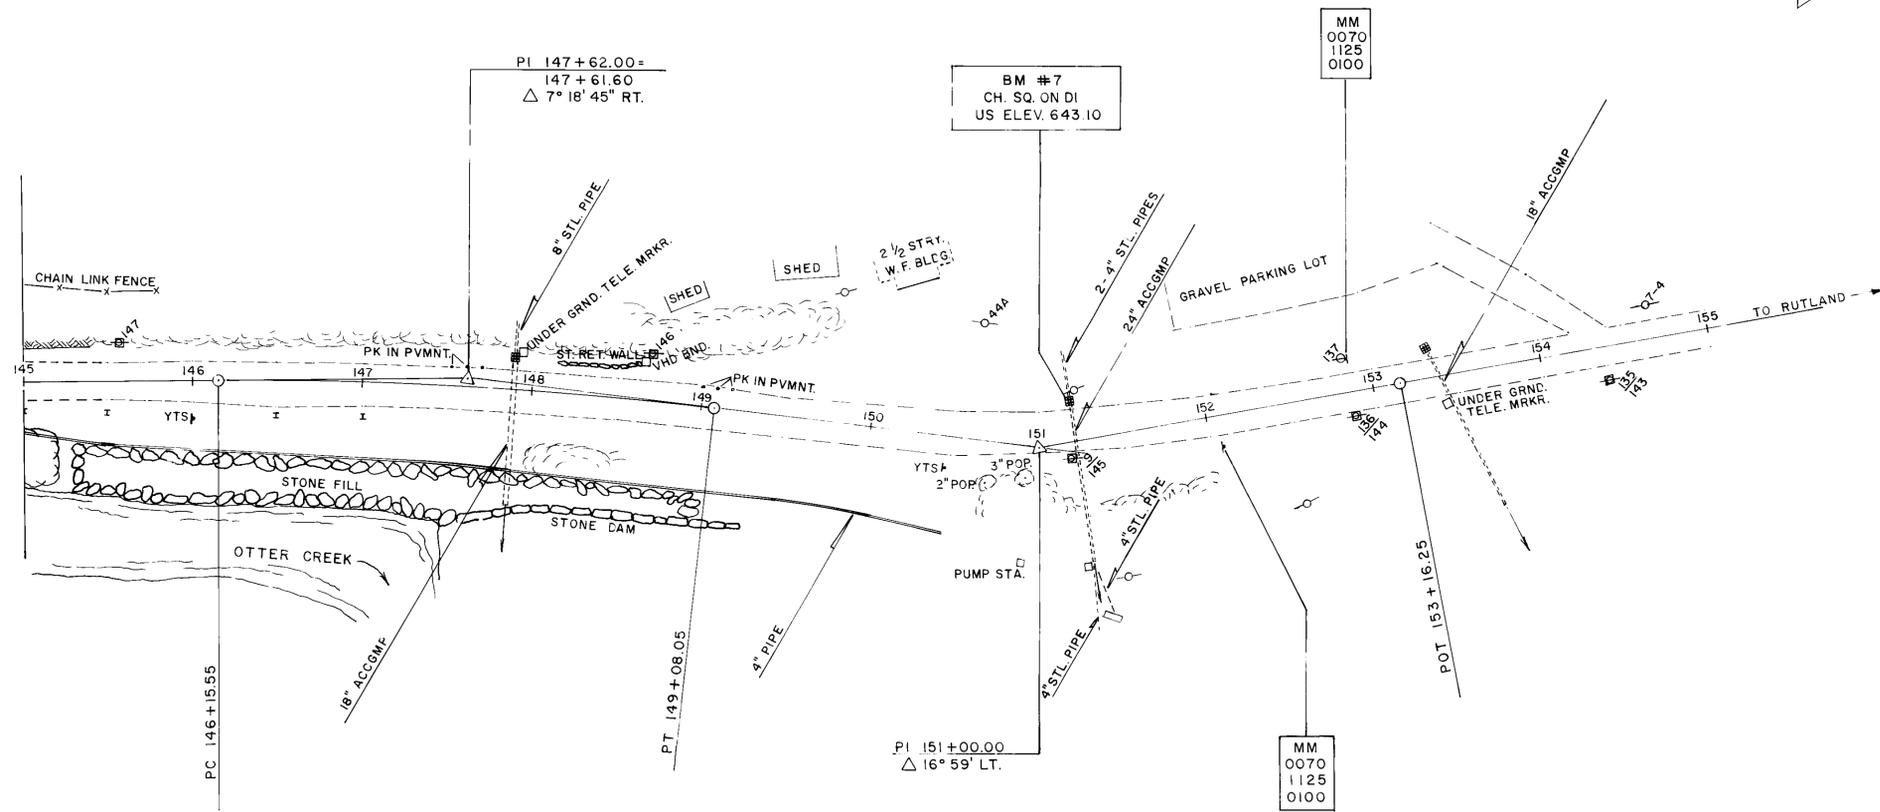


ML CURVE DATA
 7° 18' 45" RT.
 D 2° 30'
 R 2291.83'
 T 146.45'
 L 292.50'
 E 4.67'
 BANK 0.046 FT./FT.

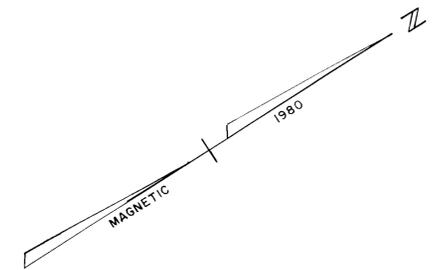

DATUM	
VERTICAL	NGVD 1929
HORIZONTAL	N/A

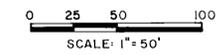

145+00 — 155+00	
SURVEYED BY	FANTONI DATE 5-85
DRAWN BY	P.M. PELKEY DATE 6-85
TRACED BY	PELKEY DATE 6-85
WALLINGFORD	
PROJ. RS	NO. 0137 (5)
SHEET	OF

BRWING 53428 3