

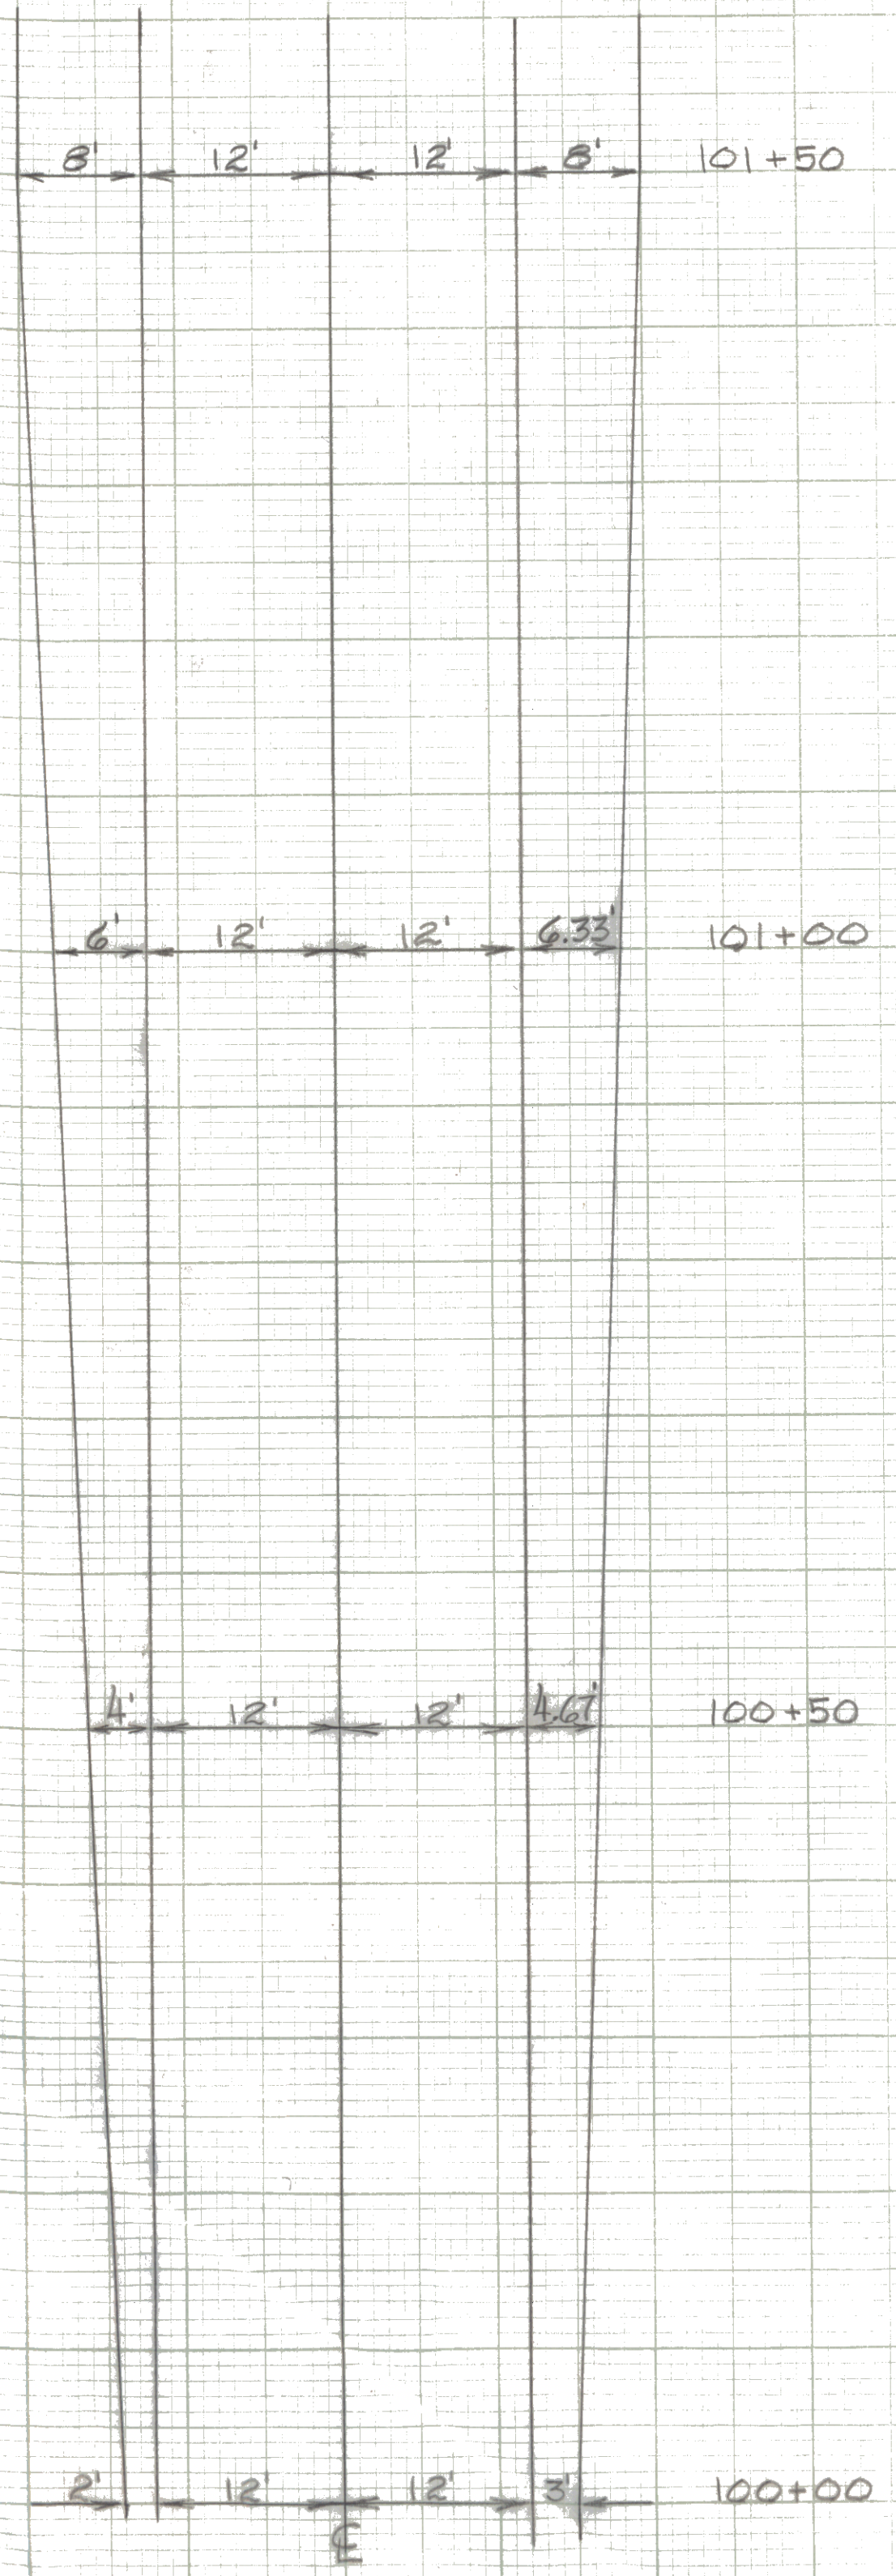


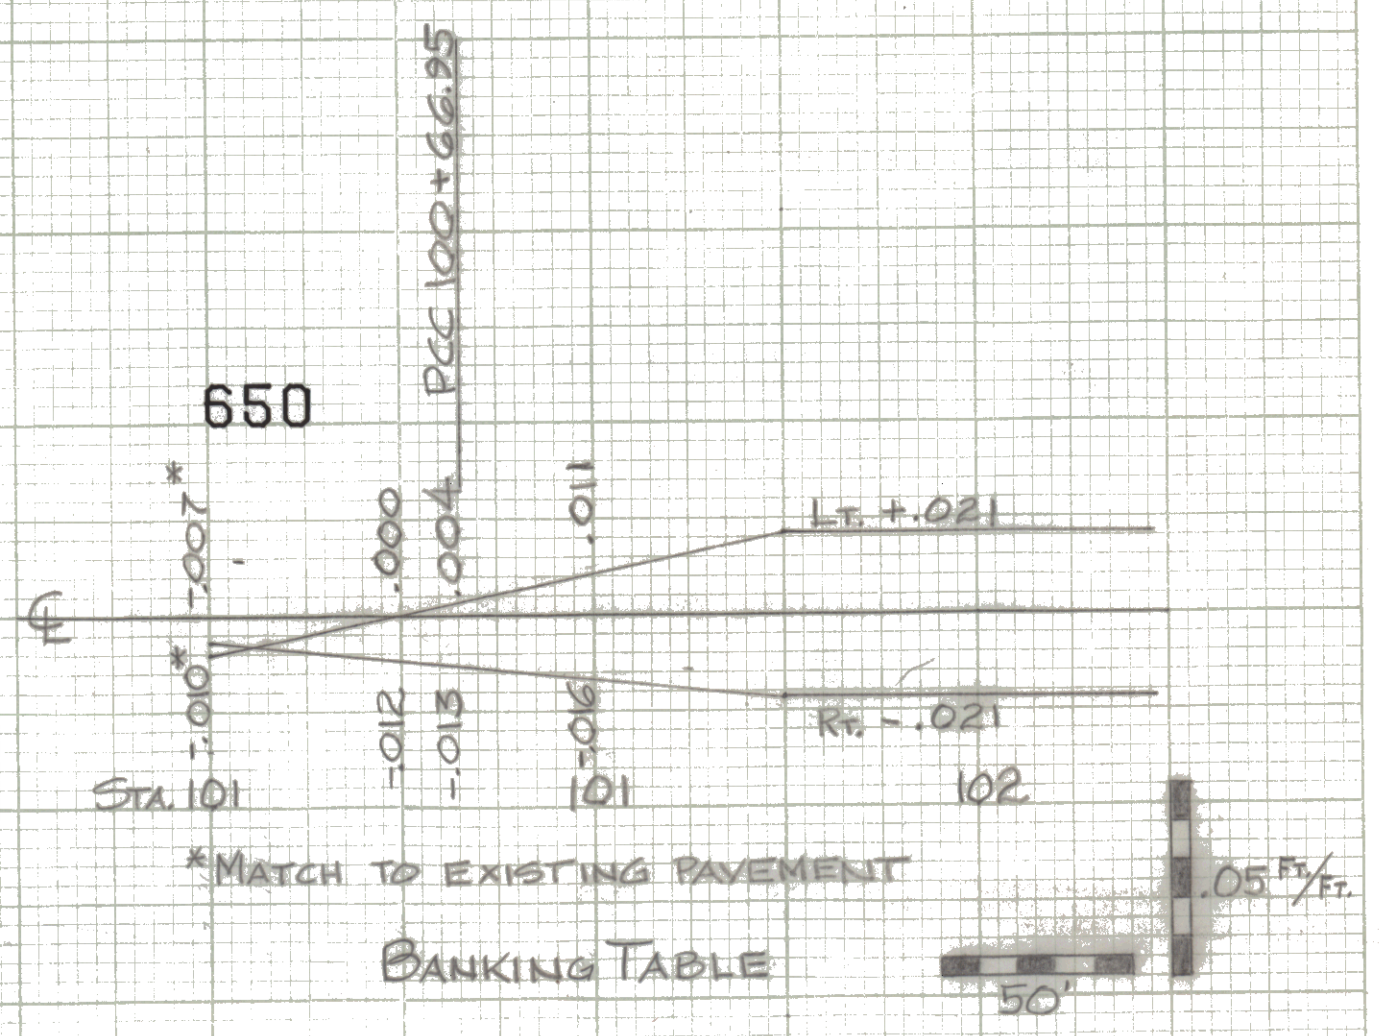

WIDTH TRANSITION DETAIL
SCALE: 1"=10'

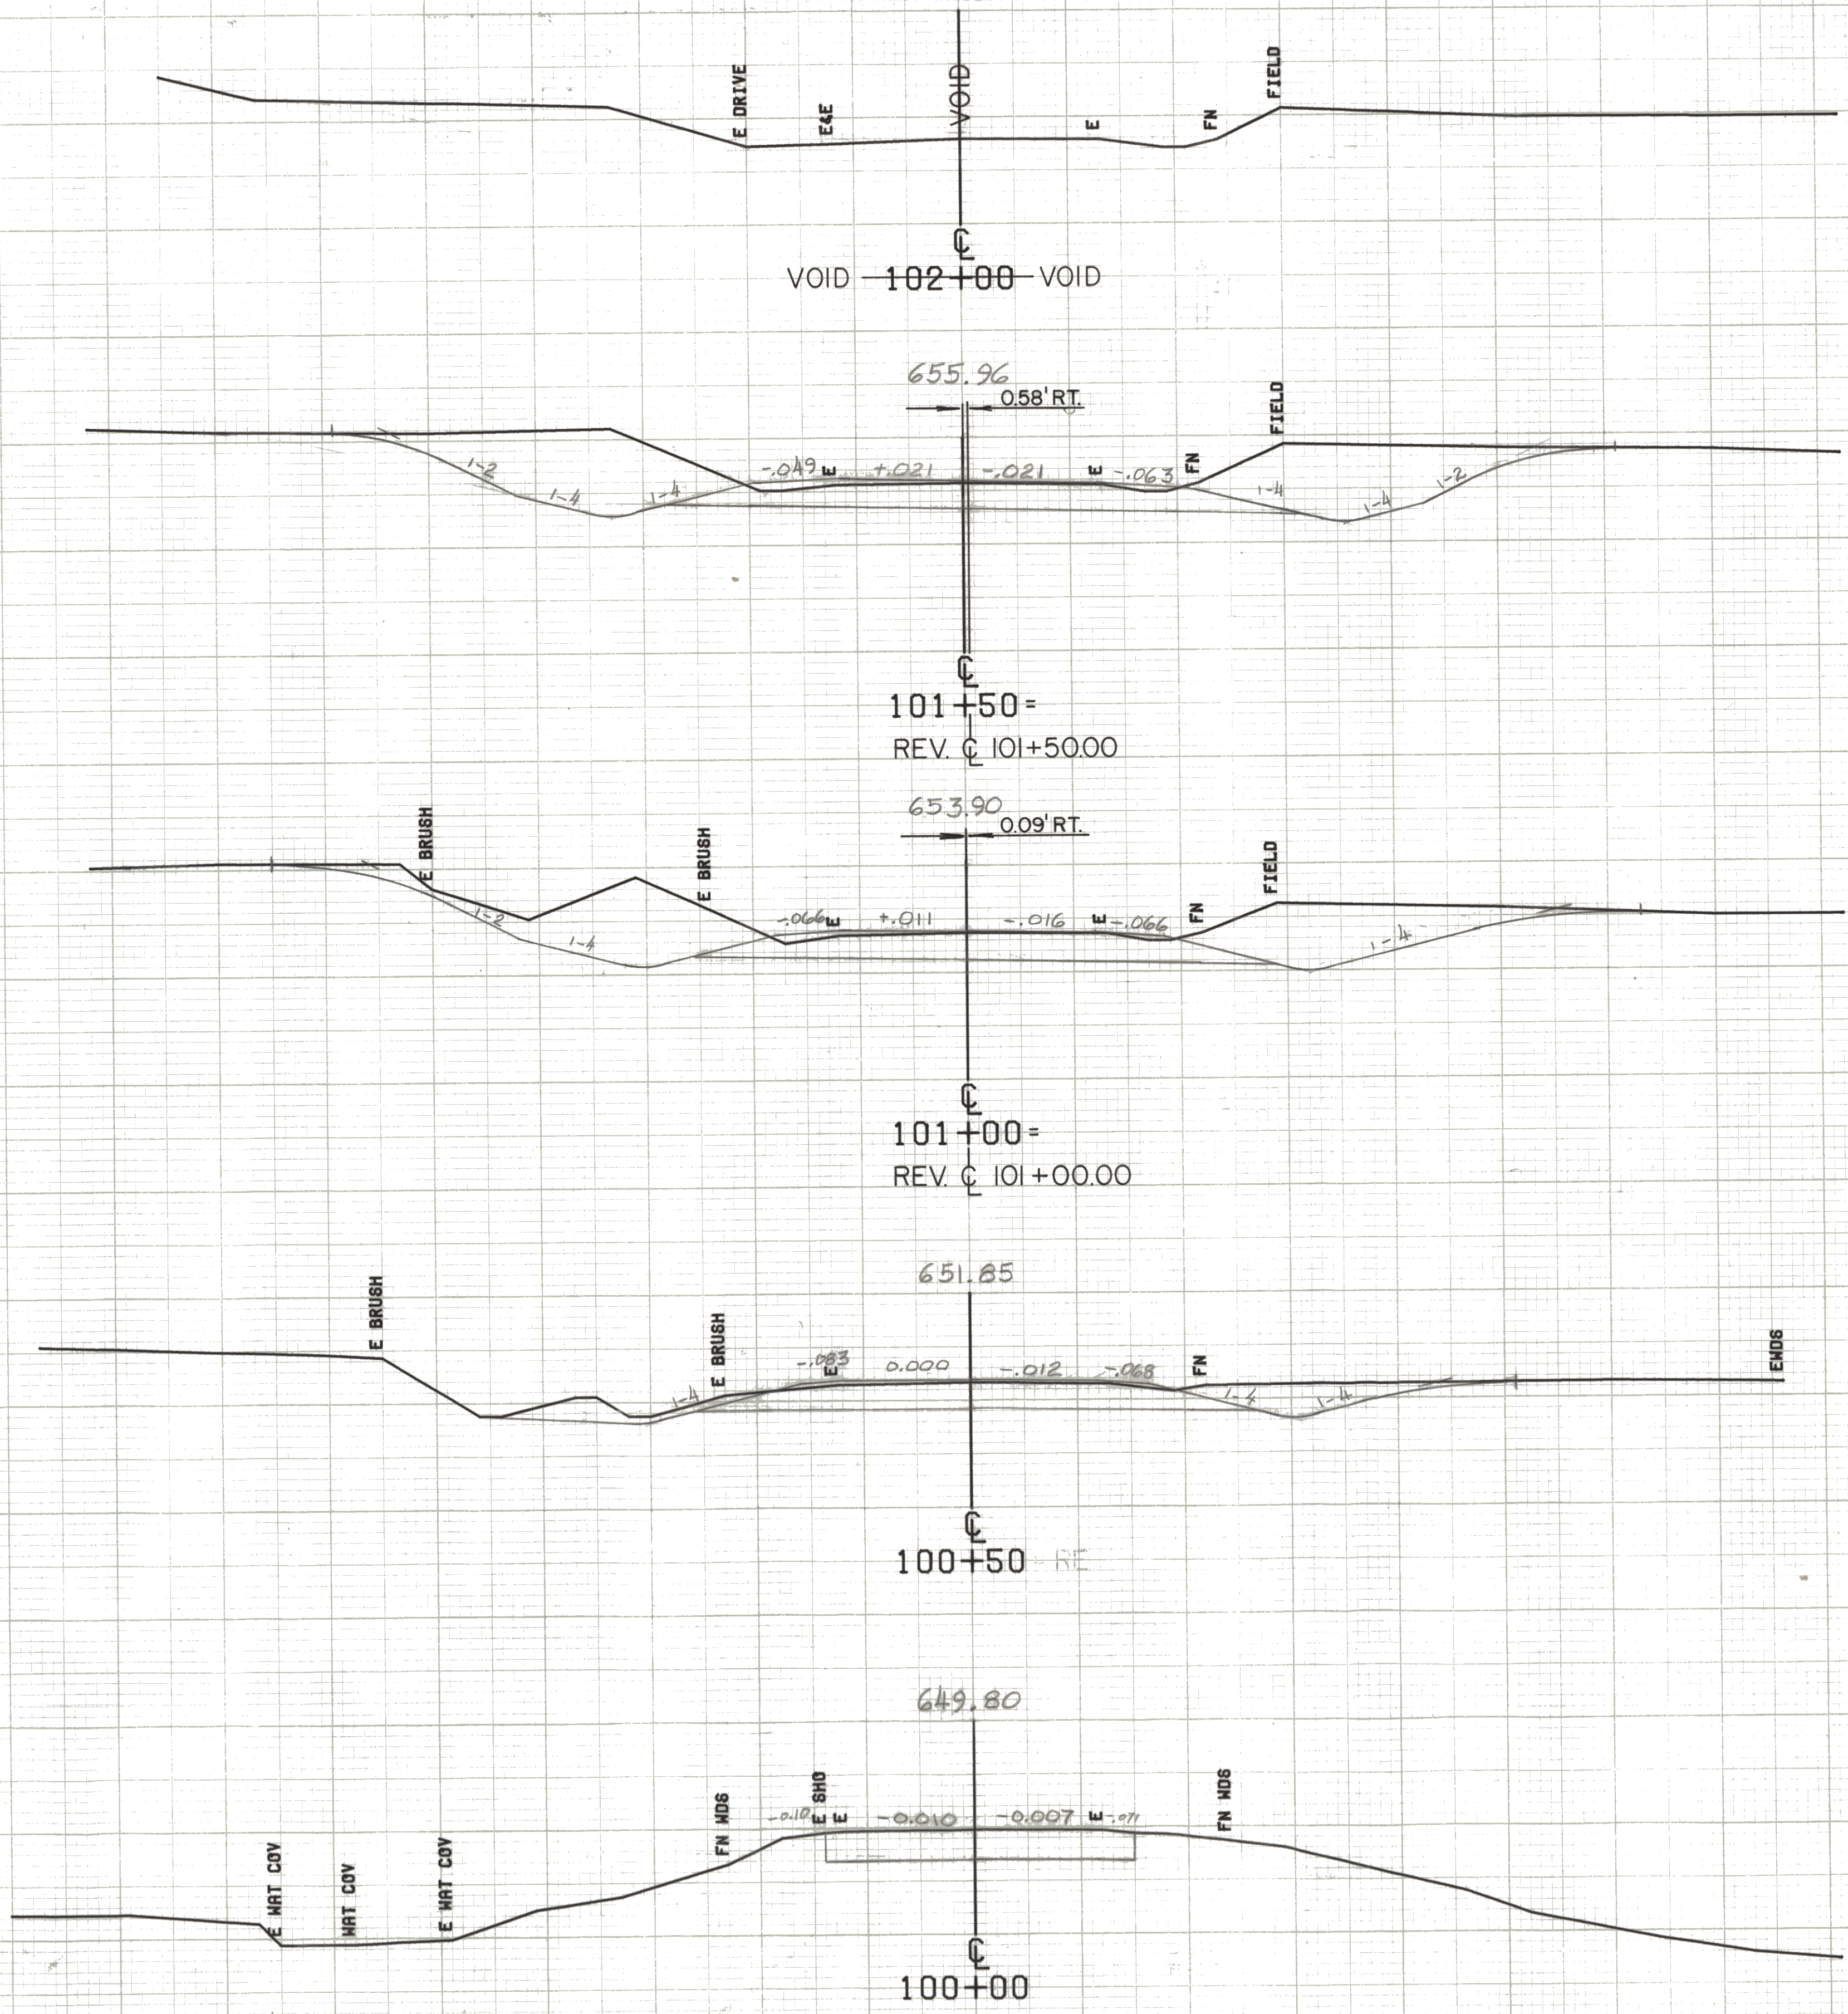

SCALE: 1"=10 FEET

FROM STA. 100+00	TO STA. 102+00
PROJECT NAME	WALLINGFORD
NO.	RS0137(5)
SURVEYED BY	DAVIS
SHEET	OF SHEETS
	PLOTTED 10/06/80
	02/80