


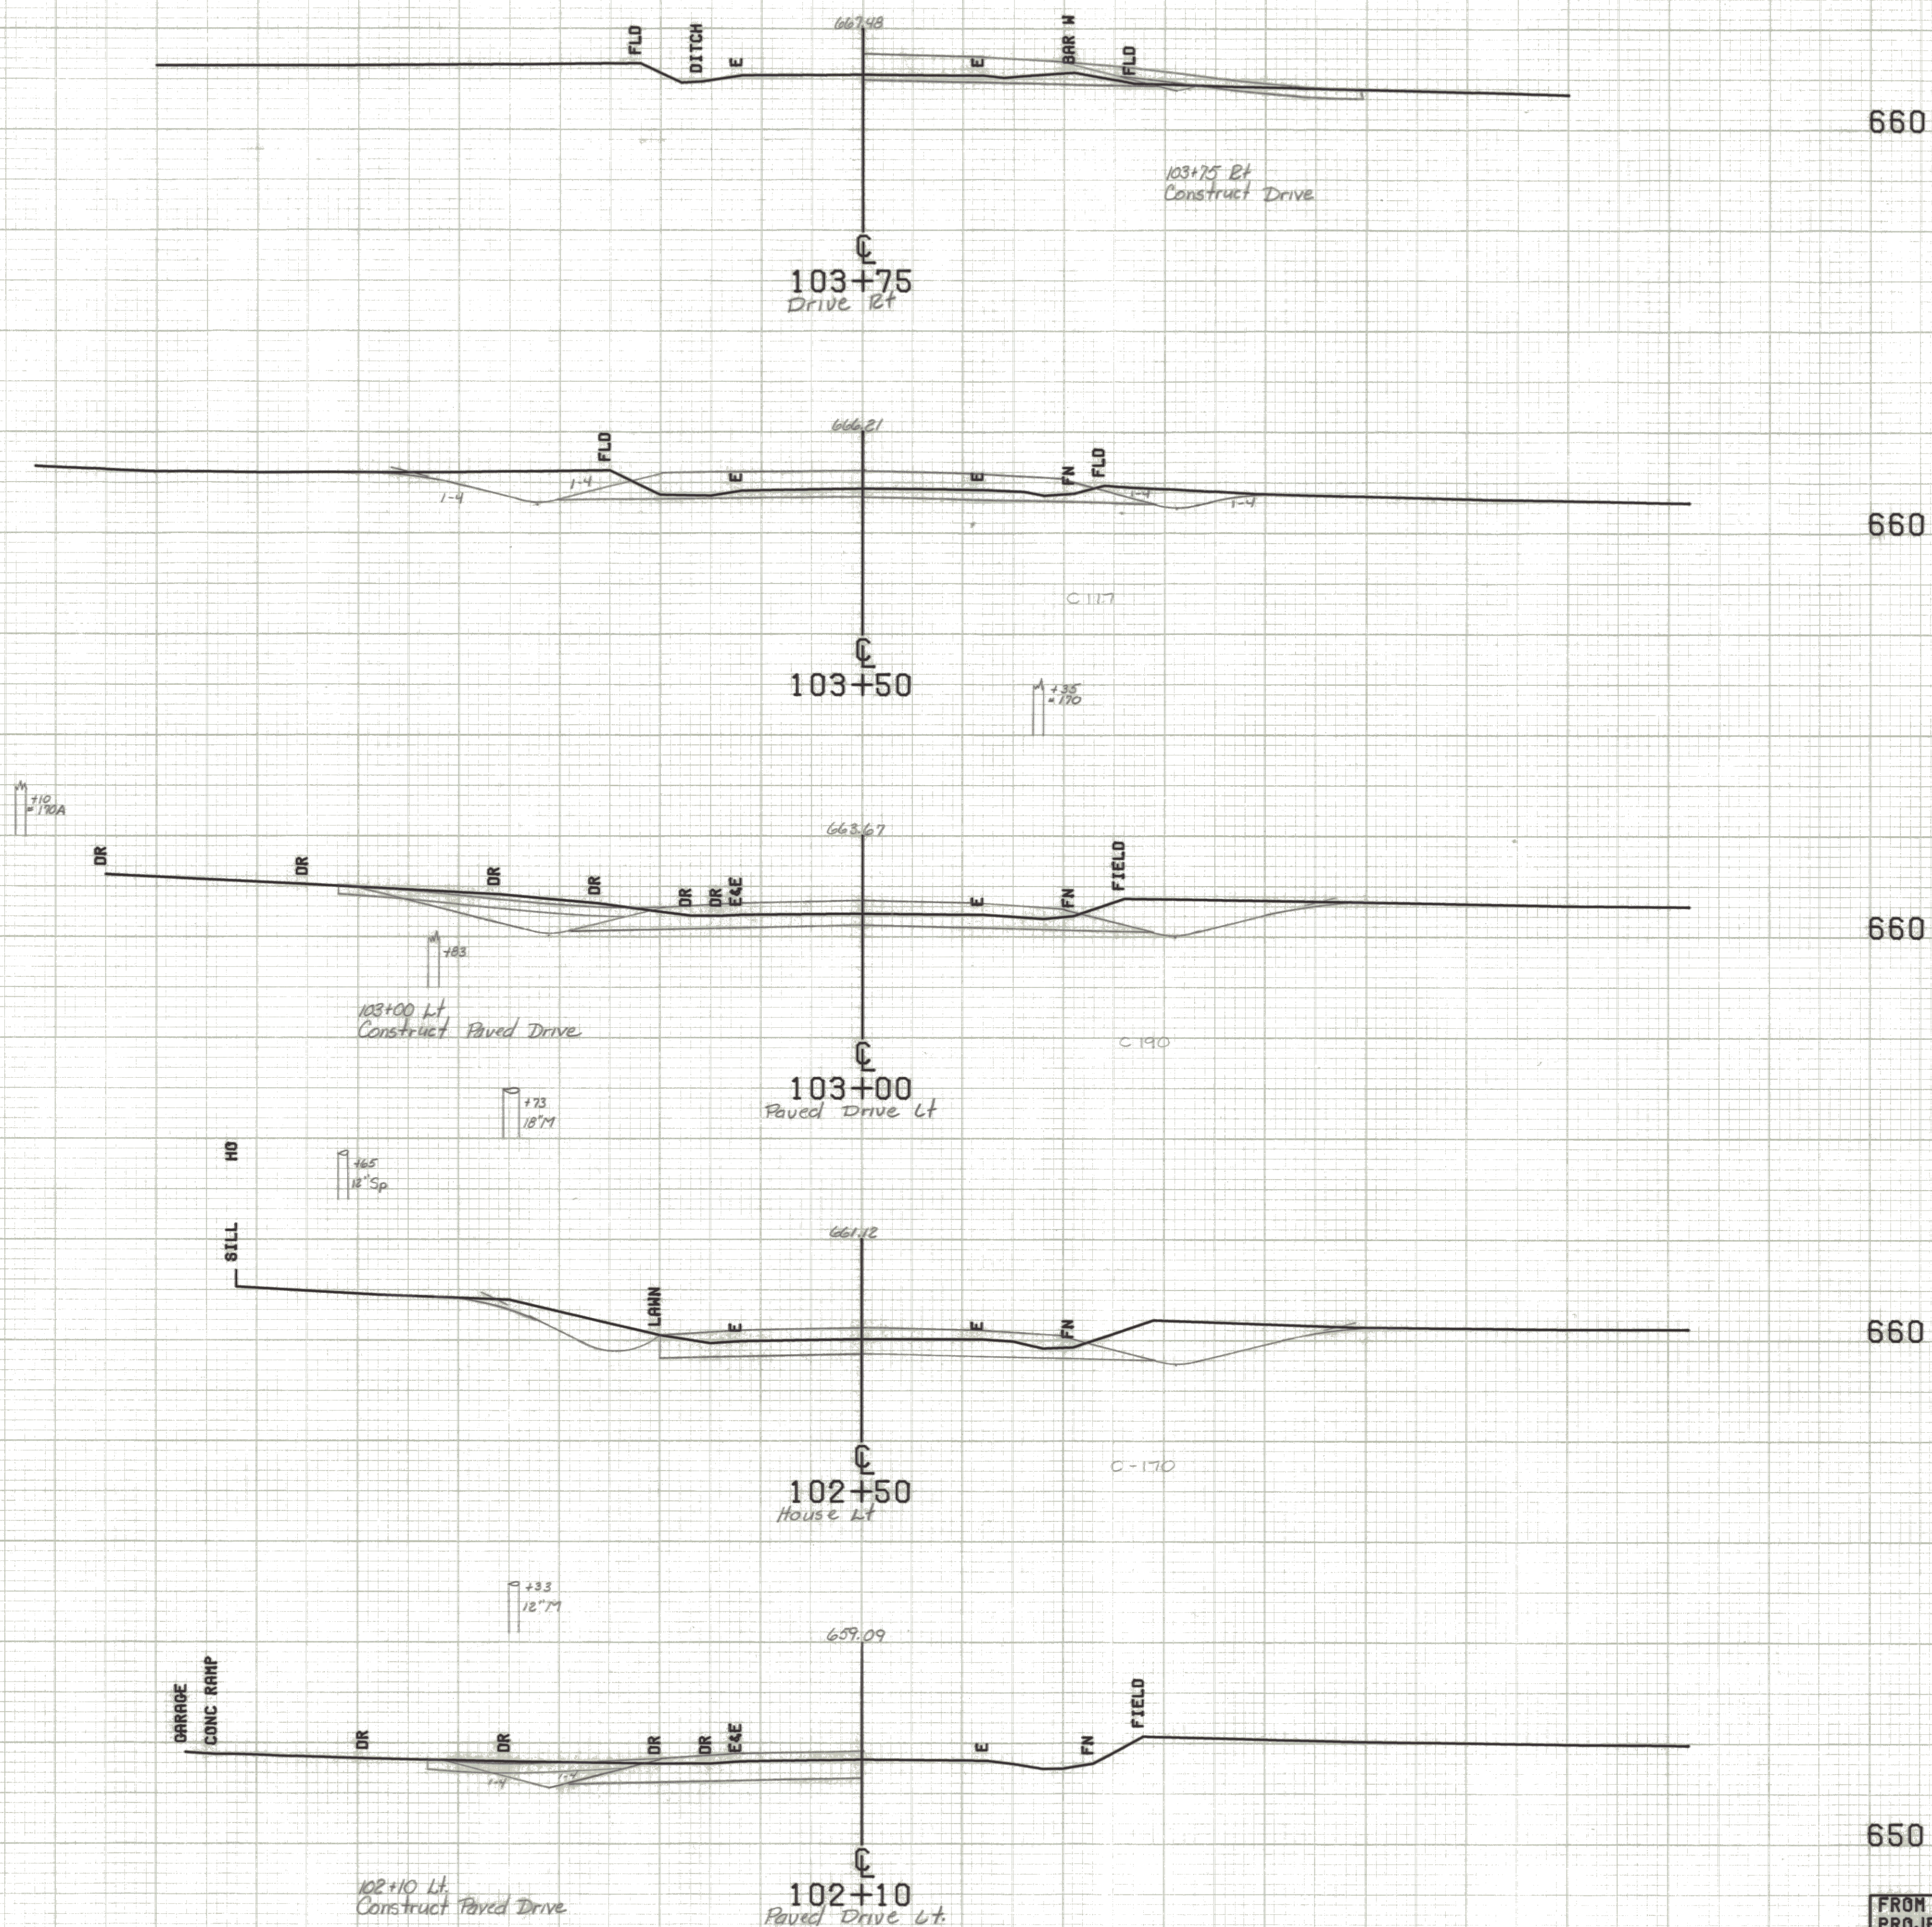

FROM STA. 102+10	TO STA. 103+75
PROJECT NAME	MALLINGFORD
NO.	R50137(5)
SURVEYED BY	DAVIS
SHEET	OF SHEETS
	PLOTTED 10/06/80
	02/80