
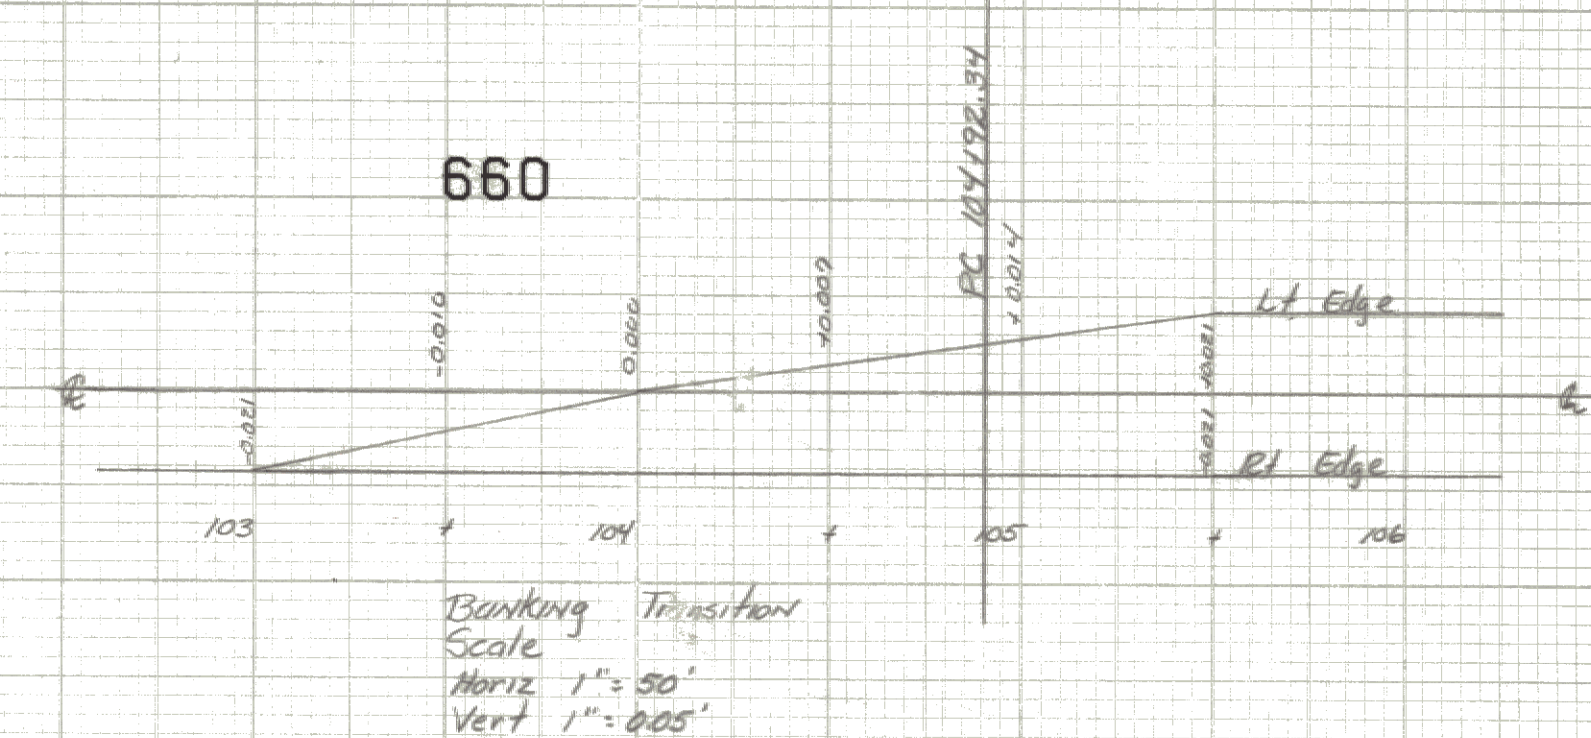


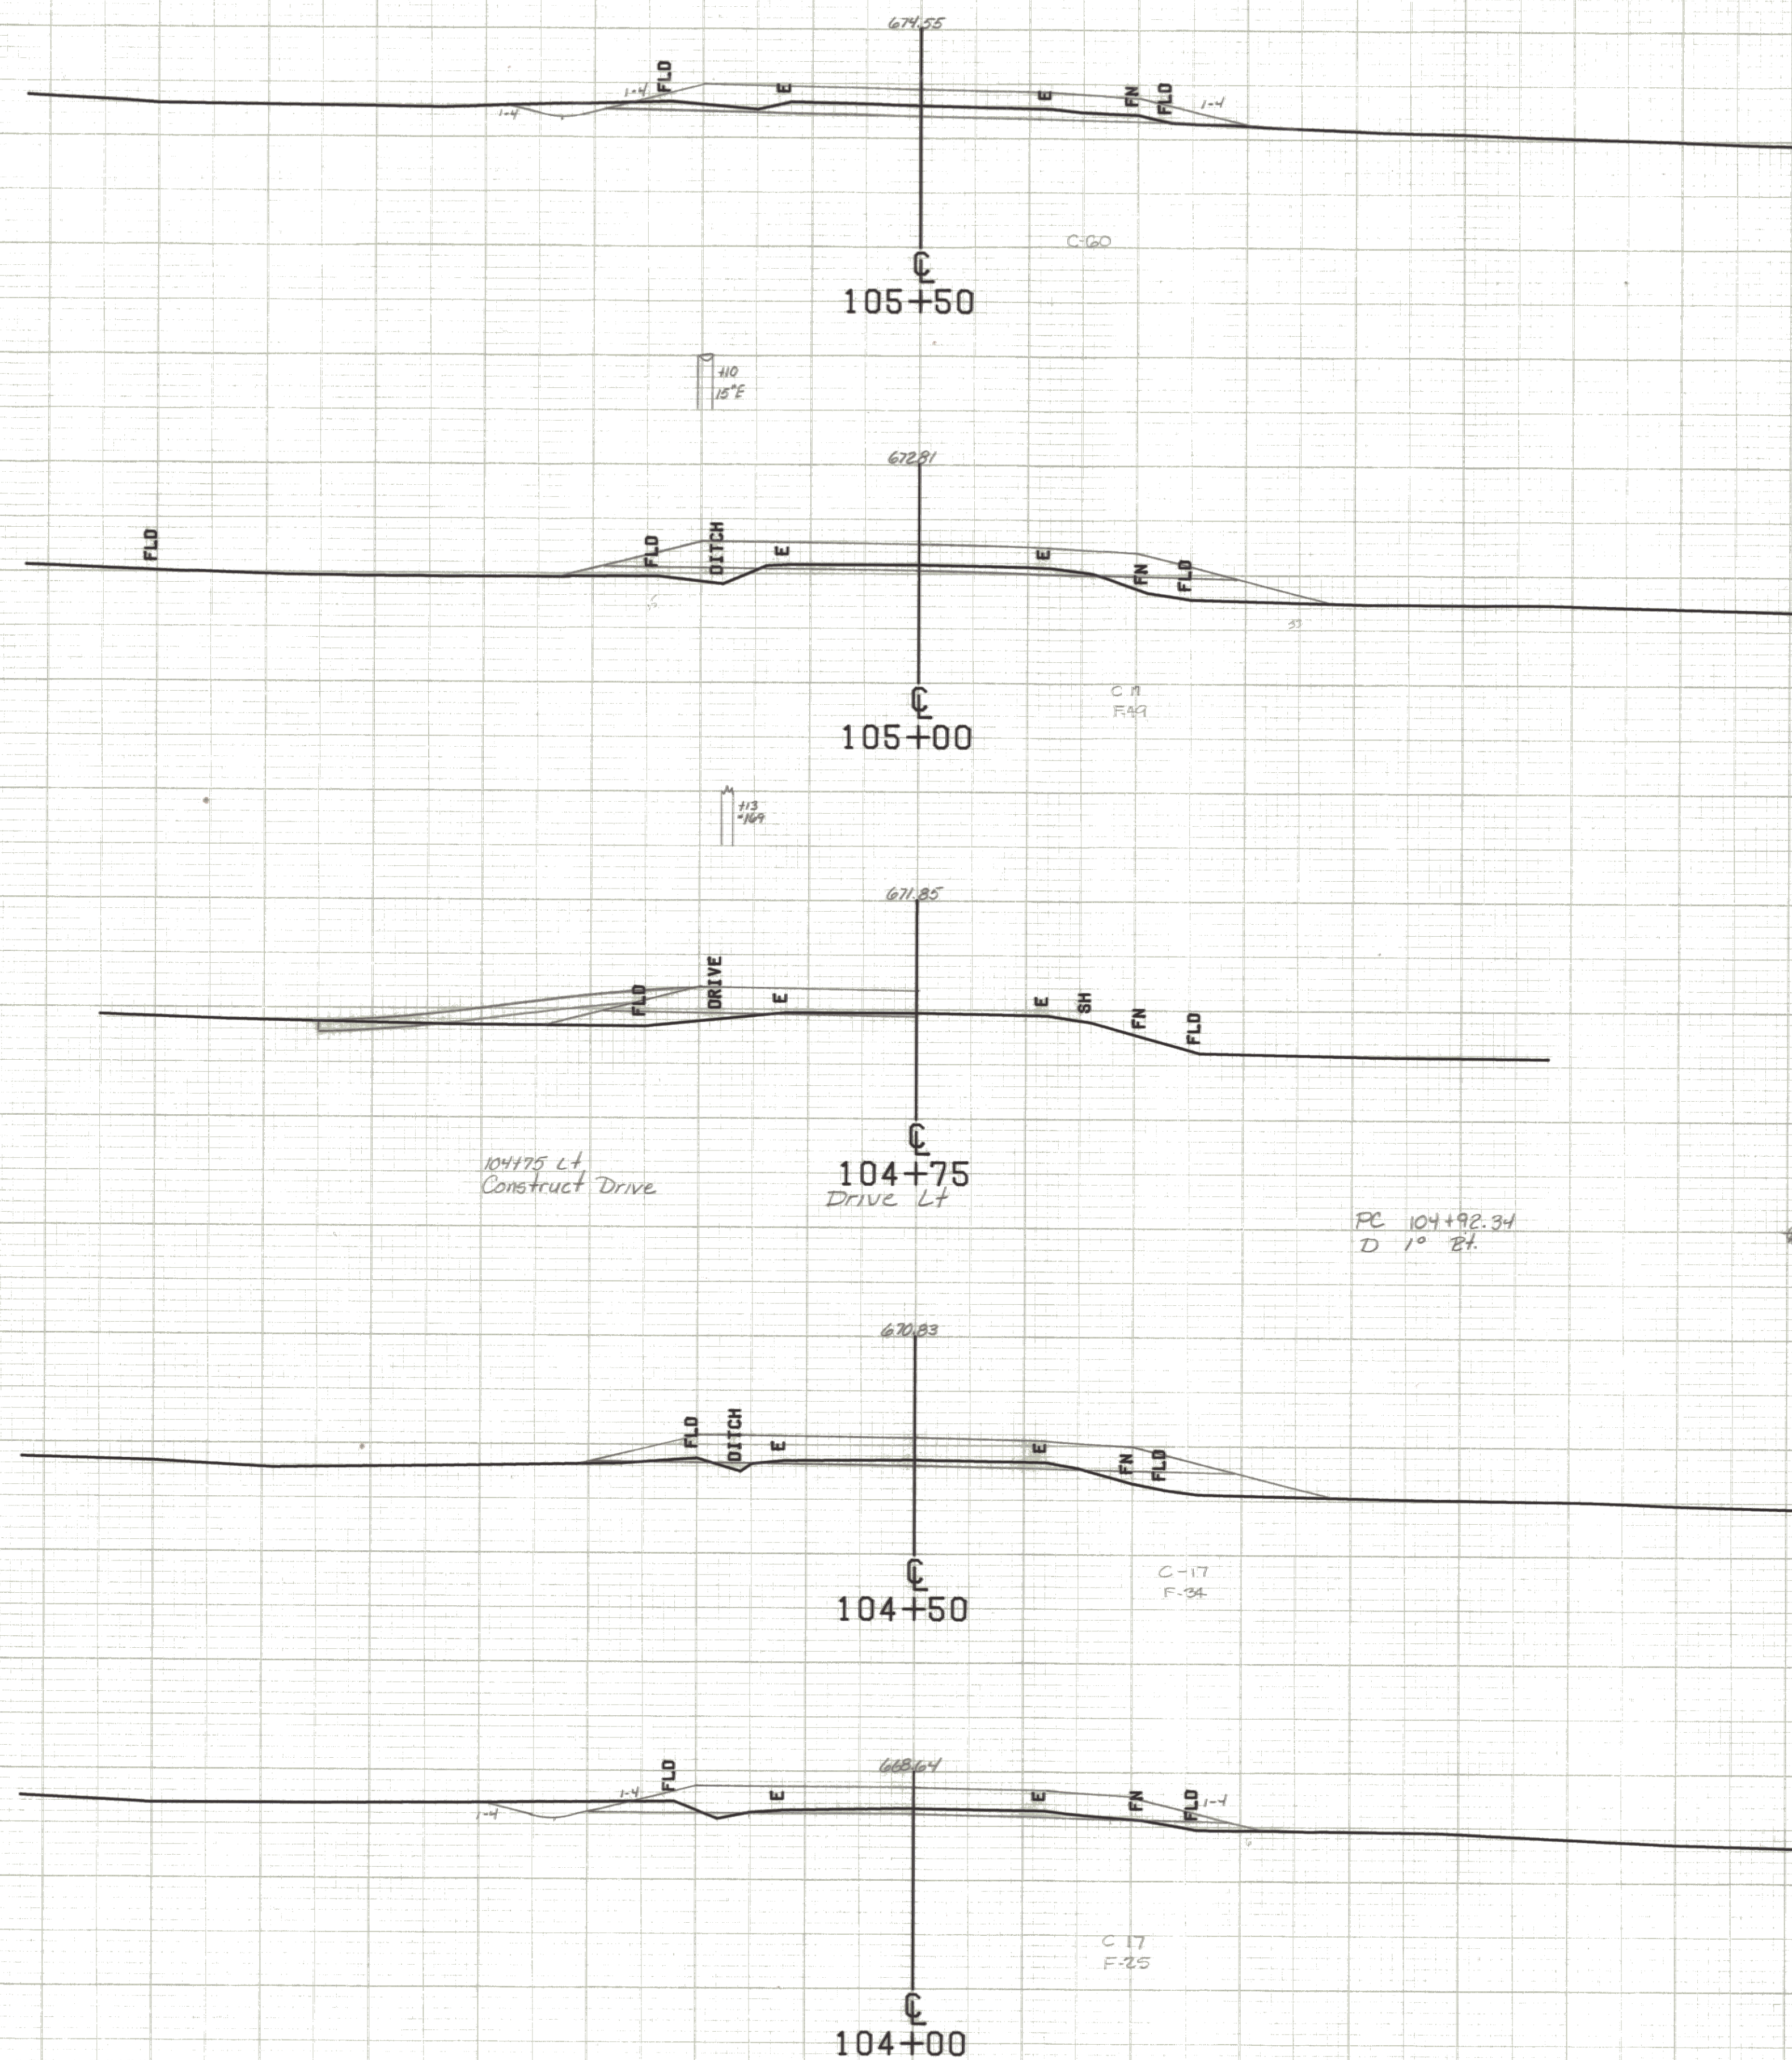

SCALE 1" = 10 FEET

FROM STA. 104+00	TO STA. 105+50
PROJECT NAME	WALLINGFORD
NO.	RS0137(5)
SURVEYED BY	DAVIS
SHEET	OF SHEETS
	PLOTTED 10/06/80
	02/80