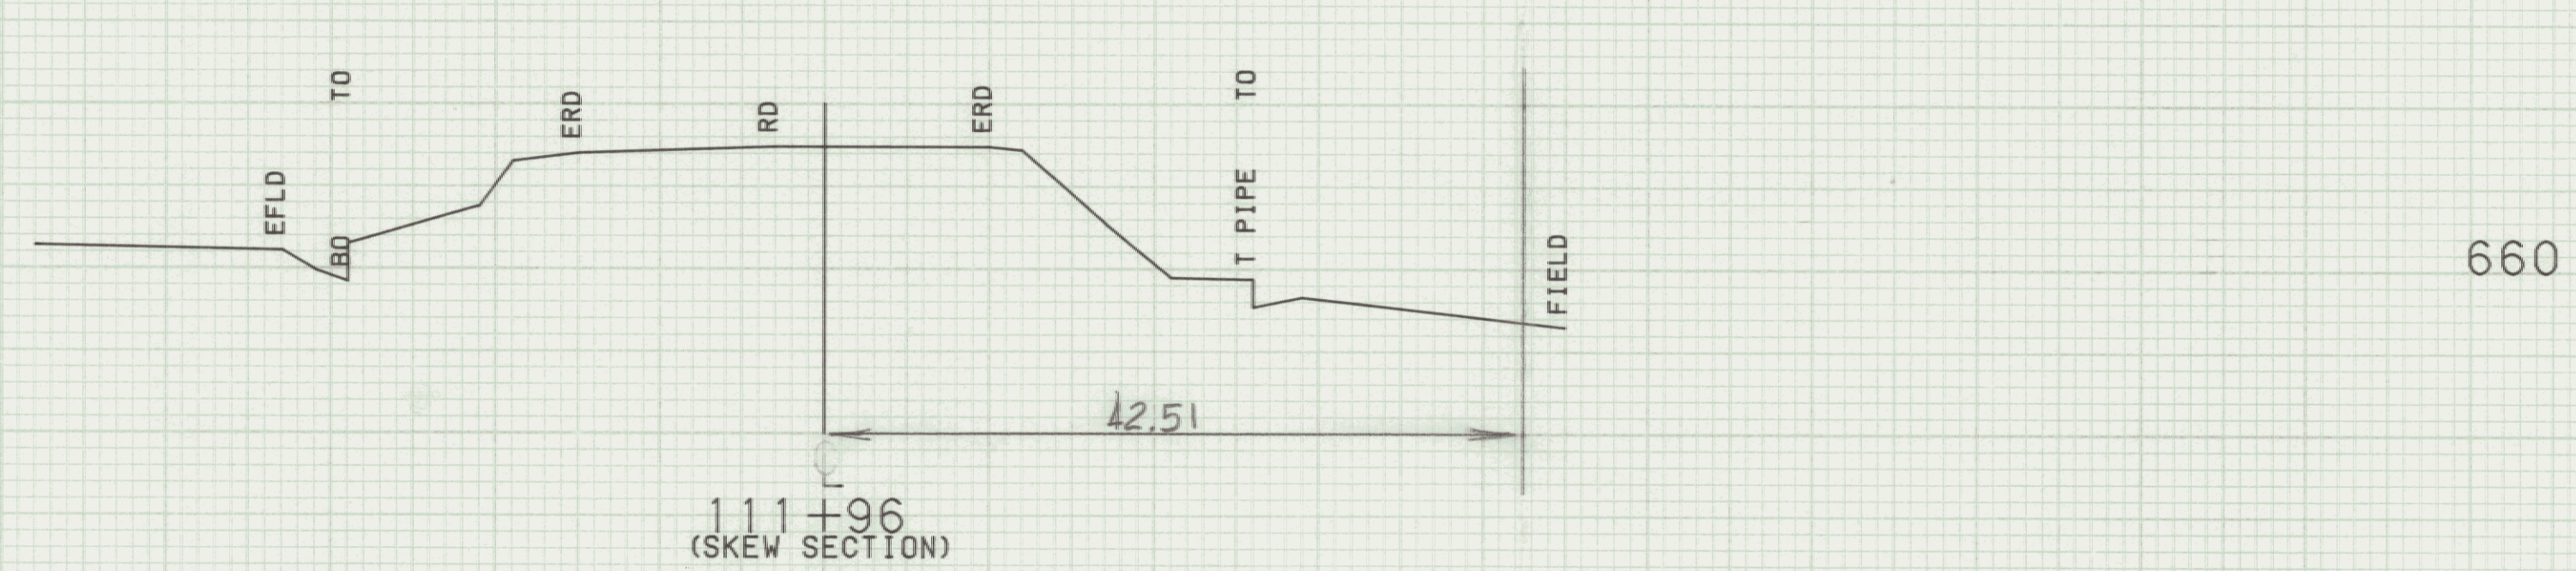
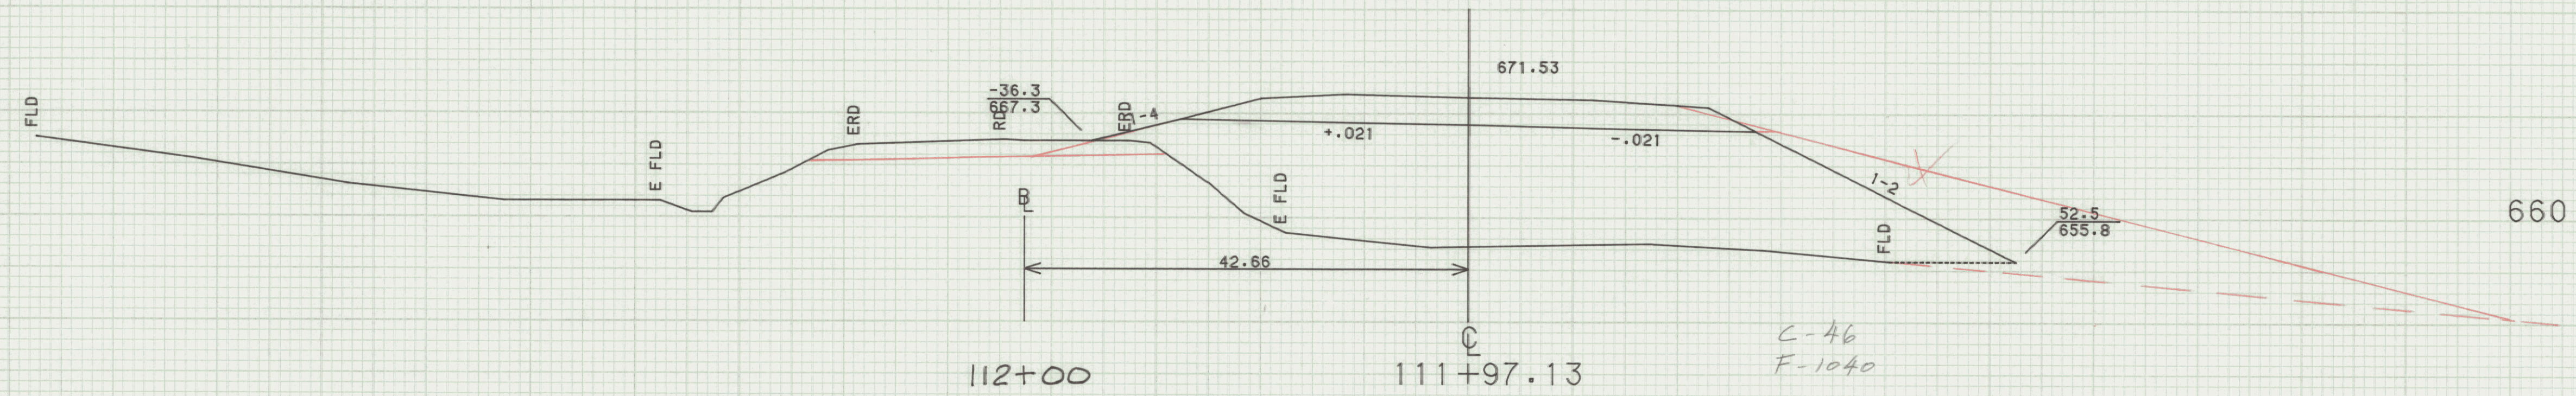
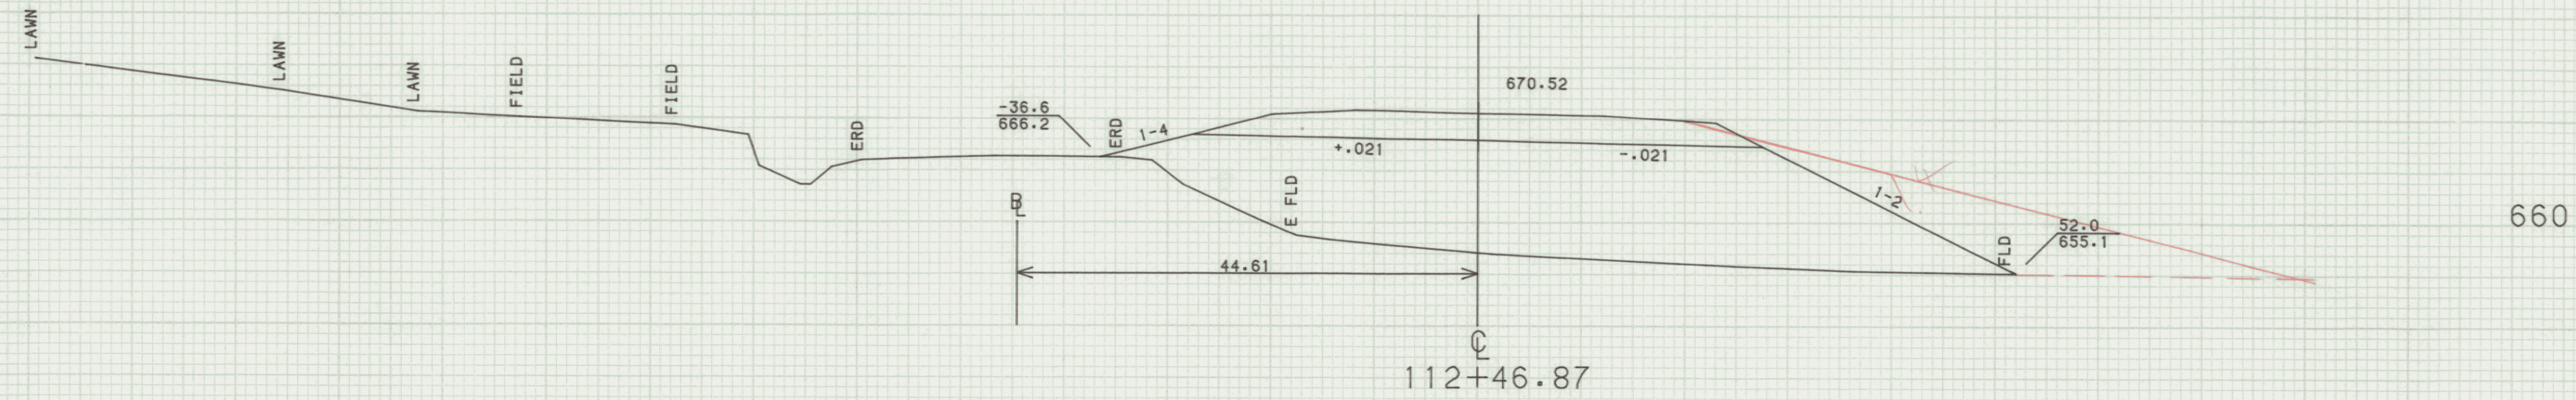


SCALE 10 FEET

FROM STA. 111+47.45 TO STA. 112+46.87
PROJECT NAME WALLINGFORD
NO. RS0137 (5) PLOTTED 11/13/85
SURVEYED BY FANTONI MAY - 85
SHEET OF SHEETS