


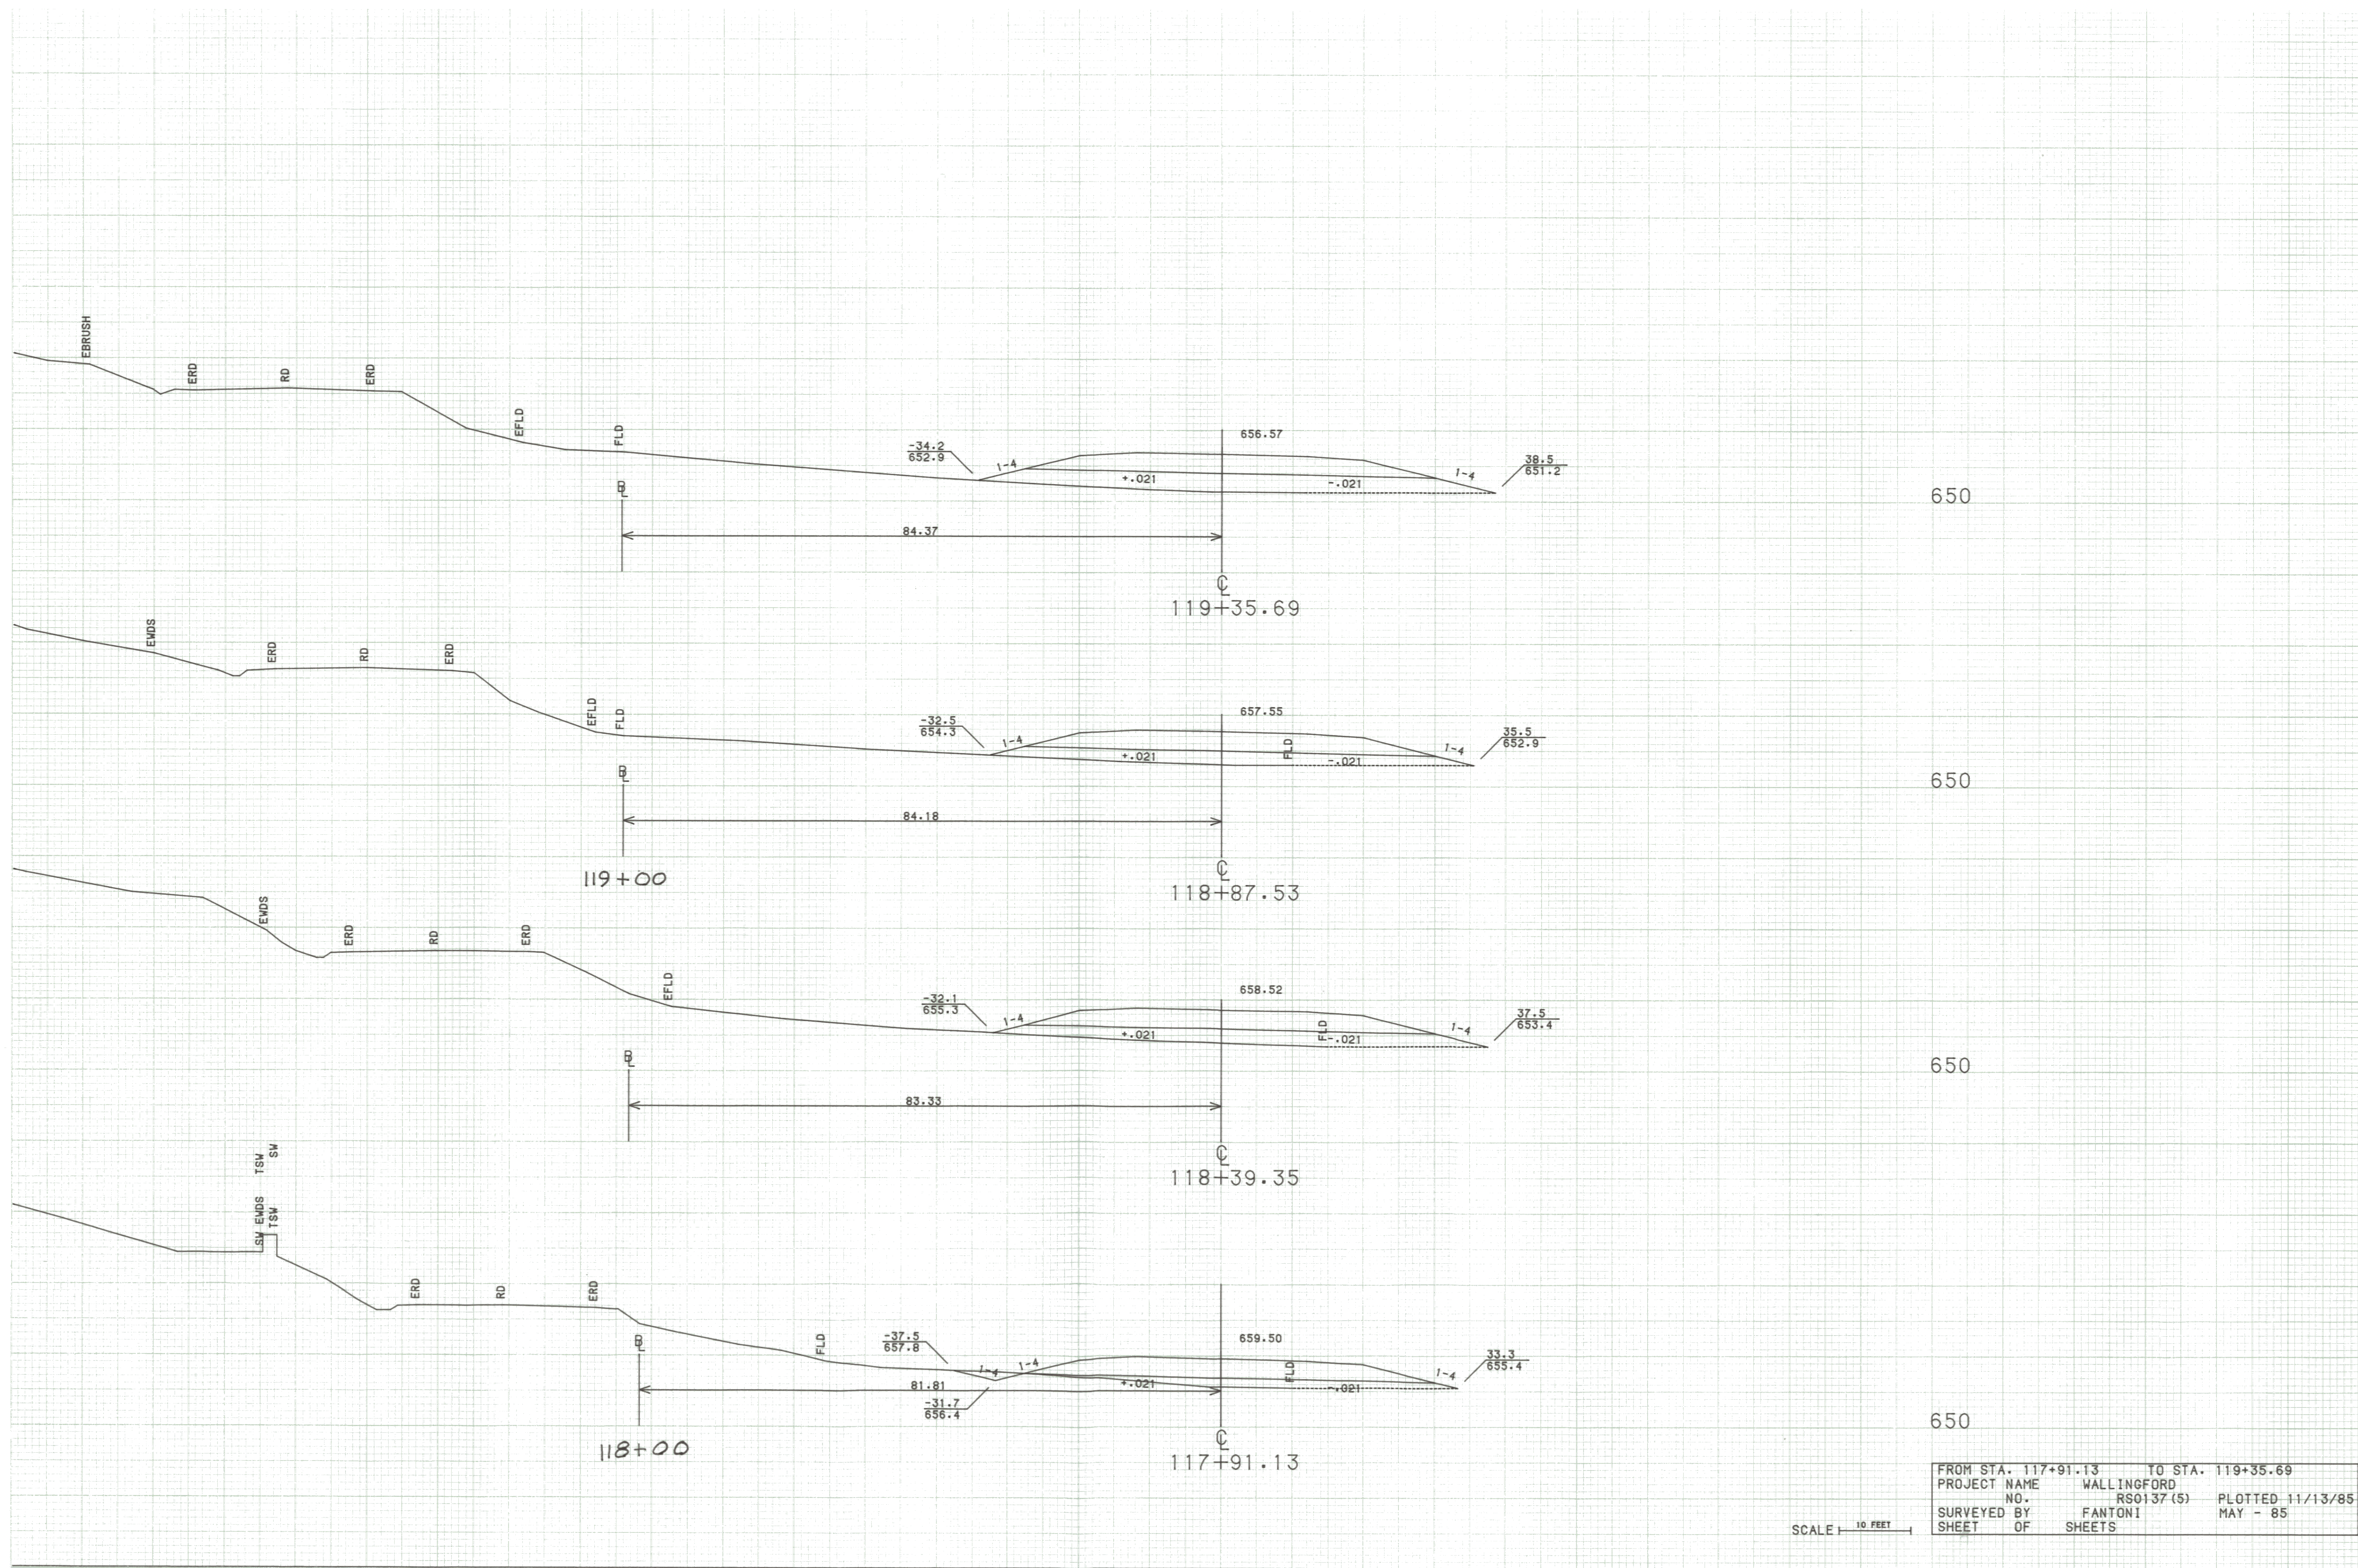

650

650

650

650

FROM STA. 117+91.13		TO STA. 119+35.69	
PROJECT NAME		WALLINGFORD	
NO.		RS0137 (5)	
SURVEYED BY		FANTONI	
SHEET		OF SHEETS	
		PLOTTED 11/13/85	
		MAY - 85	

SCALE 1" = 10 FEET